(Larry Beam) 1:30 - 634-5248 (5246)

IREDELL COUNTY HEALTH DEPARTMENT

STATESVILLE 704-878-5305 MOORESVILLE 704-664-5281

IMPROVEMENT PERMIT / AUTHORIZATION TO CONSTRUCT / OPERATION PERMIT / EXISTING SYSTEM INSPECTION

PERMIT# ~~86508~~ 114300 PIN# ~~4626387480~~ 4626-39-9943 DATE 12/20/99

OWNER OR CONTRACTOR EASTER DEVELOPMENT PHONE: Business 664-2406 Home

ADDRESS BRAWLEY SCHOOL - TR McKENDREE - TR DOGWOOD CIRCLE - TR BARKSDALE - 3RD ON LT

LOCATION

SUBDIVISION BLACKBERRY CRK BLOCK / SECTION LOT 3 LOT AREA .78 AC SITE CLASS. PS DESIGN FLOW 480 GPD L.T.A.R. .3 pd/ft²

Septic Tank: 1000 Gallons; STB 312 Date 4/9/04
Pump Tank: Gallons; PT Date
Pump Make: Model Serial No.
Nitrification Field: No Fields 1 Square Feet 900 Linear Feet 300
No Lines 5@60' Trench Width 36" Max Trench Bottom Depth 36" Gravel Depth N/A

☑ New System ☐ Repair System Type: I, II, III, IV, V, VI
System Description: GRAVITY 25% REDUCTION
Repair System Description: SAME
Maintenance Agreement Required: ☐ Yes ☑ No


☑ House/Mod. Home No. Bedrooms 3
☐ Mobile Home No. Bathrooms 2
☐ Business No. Employees
☐ Other
☐ Slab ☐ Crawl Space ☑ Basement w/plumbing ☐ Basement wo/plumbing

Water Supply: ☑ Individual ☐ Public ☐ Community


Comments:/Conditions:

Comments:/Conditions:

INITIAL SITE SKETCH 1"=50'

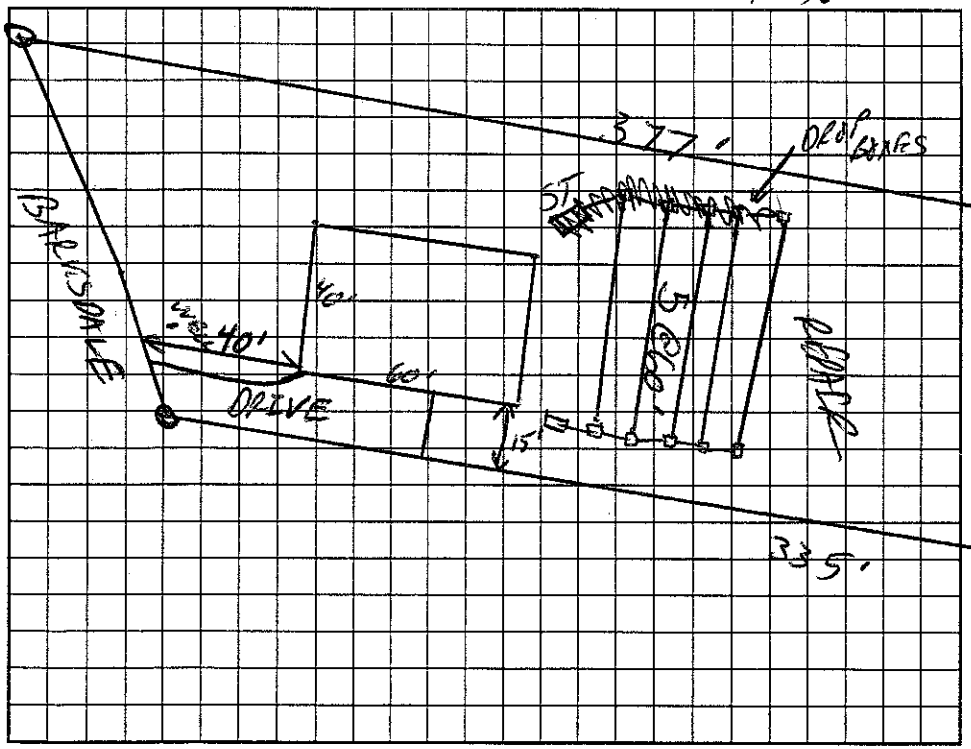

AS BUILT SKETCH

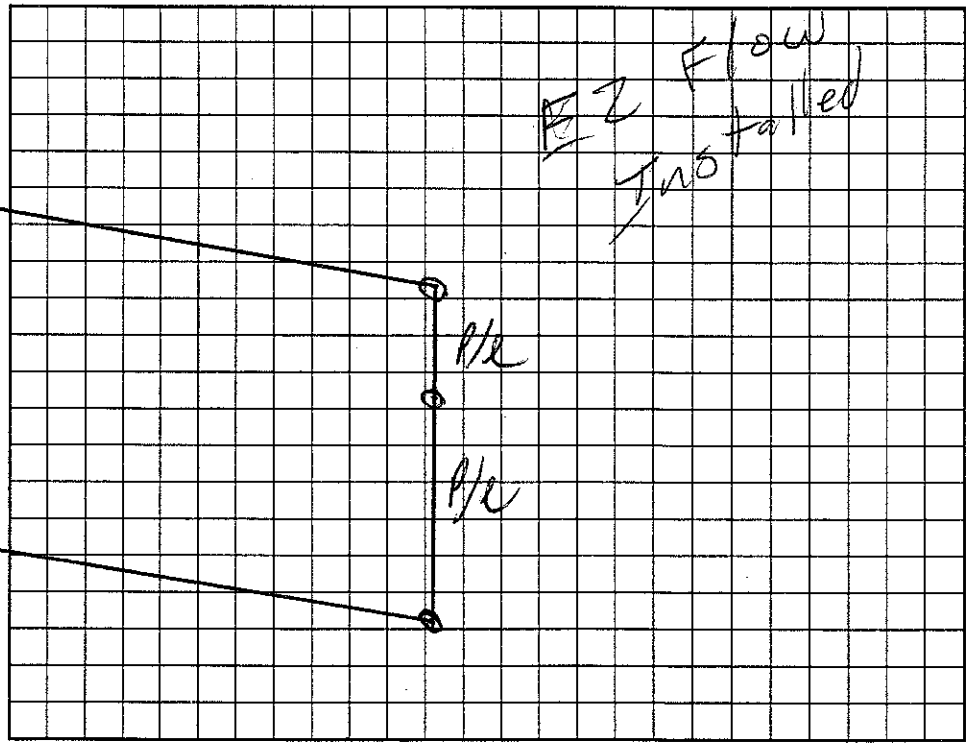

Permit can be suspended or revoked if any false information is supplied toward securing the permit/any unauthorized changes are made to the site/any unauthorized changes are made in the installation of the system. Improvement Permit with plat valid without expiration. Improvement Permit with site plan valid for sixty months. Authorization to Construct is valid for a period equal to that of Improvement Permit – not to exceed sixty months.

Signed: [signature] -PRES EDC date 12/21/99 Installed by: Larry Beam

Improvement Permit by: [signature] KS date 12/20/99 Operation Permit by: [signature] RS date 5/7/04

Authorization to Construct by: [signature] KS date 1/13/00 Existing System Inspection by: date

HEALTH DEPT. COPY: WHITE OWNER COPY (FINAL): YELLOW OWNER COPY (INITIAL): PINK