IREDELL COUNTY HEALTH DEPARTMENT

Authorization to Construct

STATESVILLE 704-878-5305 MOORESVILLE 704-664-5281

IMPROVEMENT PERMIT / ~~CERTIFICATE OF COMPLETION~~ / OPERATION PERMIT / EXISTING SYSTEM INSPECTION

PROPERTY DESCRIPTION NO. 068766 DATE 8/18/97 TAX MAP NO. 4626400787 Watershed: [X] Yes [ ] No

OWNER OR CONTRACTOR Sammy Burbank PHONE: Business 365-9916 Home

ADDRESS 6525 Morrison Blvd Charlotte, NC 28211

LOCATION Brawley Sch. TR Bay Harbour TR Lake Spring Lp. TR Marcus Ridge TL Wild Chris on (L) cul de sac

SUBDIVISION Harbour BLOCK / SECTION III LOT 19 LOT AREA .71 SITE CLASS. PS DESIGN FLOW 480 L.T.A.R. .3

Septic Tank: 1000 Gallons; STB 794 Date

Pump Tank: 1000 Gallons; PT 27 Date 2/30/97

Pump Make: HYDROMATIC Model SHEF50A1 Serial No. 1198

Nitrification Field: No. Fields 1 Square Feet 1200 Linear Feet 400

No. Lines X5 Trench Width 36" Max Trench Bottom Depth 36" Gravel Depth SAND

[X] New System [ ] Repair System Type: I, II, III, IV, V, VI

System Description: Chi Plastic - Presidian

Repair System Description: Same

Maintenance Agreement Required: [ ] Yes [ ] No

[X] House/Mod. Home No. Bedrooms 4

[ ] Mobile Home No. Bathrooms 3

[ ] Business No. Employees

[ ] Other


[ ] Slab [X] Crawl Space [ ] Basement w/plumbing [ ] Basement wo/plumbing

Water Supply: [ ] Individual [X] Community [ ] Public


Comments:

Comments: Installed on different contour from original drawing.

INITIAL SITE SKETCH

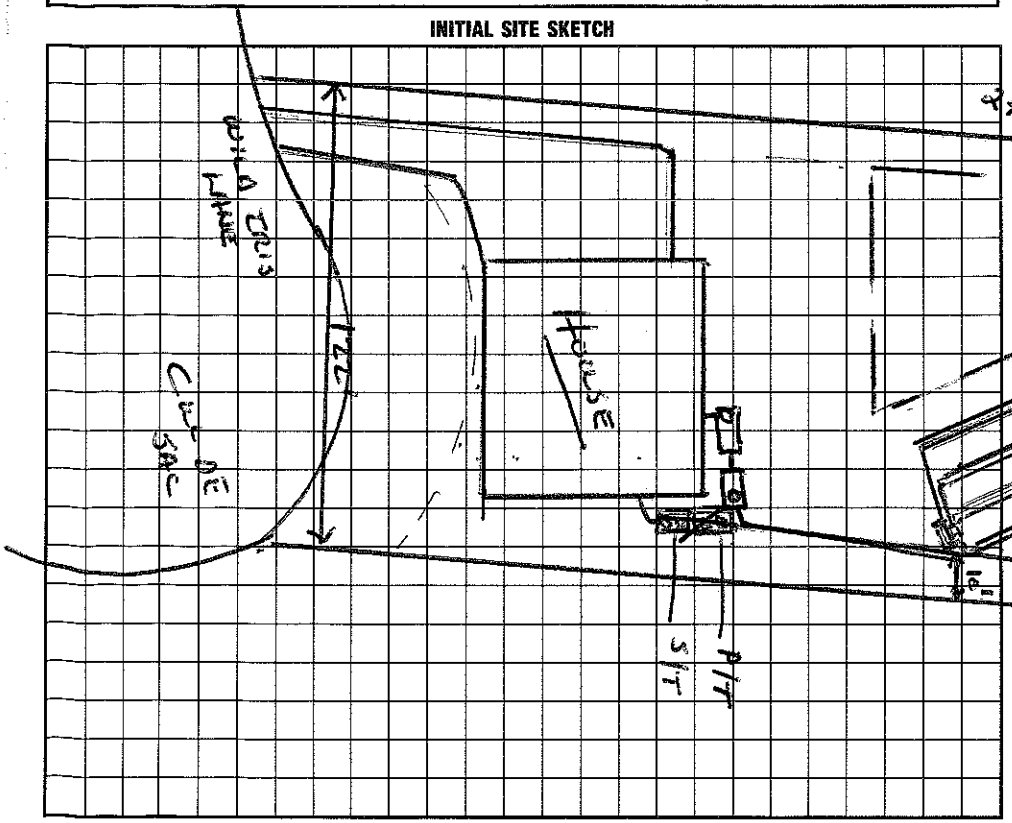

AS BUILT SKETCH

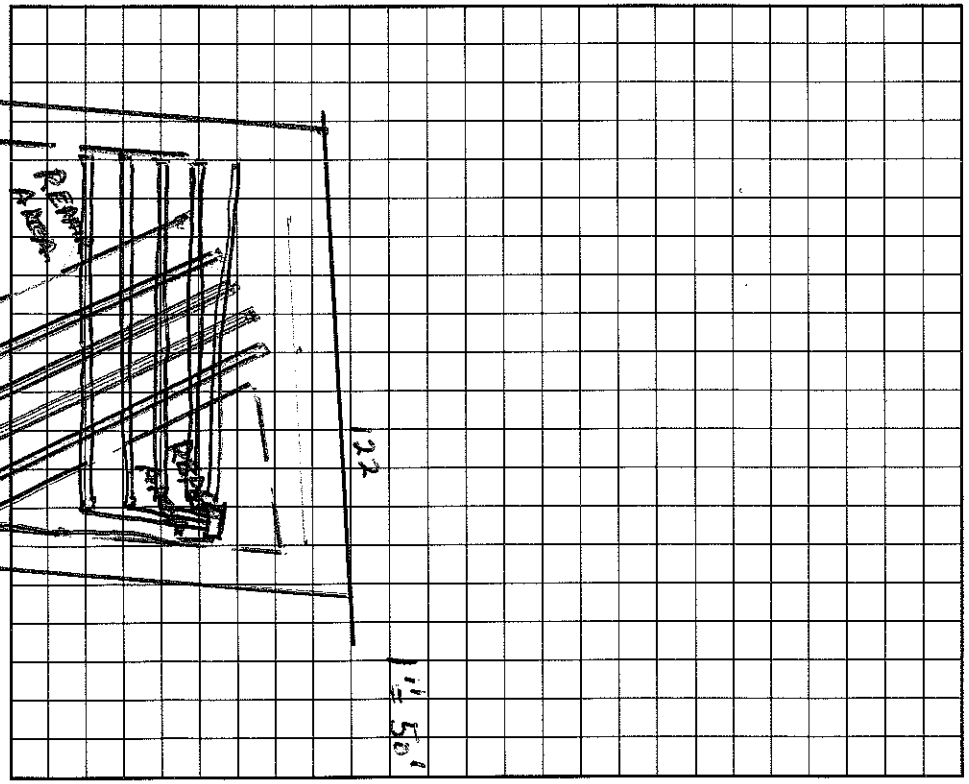

I understand that this permit can be suspended or revoked if any false information is supplied toward securing the permit/any unauthorized changes are made to the site/any unauthorized changes are made in the installation of the system. Improvement Permit is valid for 60 months from date of issuance.


Improvement Permit by: Wesley Sparks R.S. date 8/18/97

Construction Inspection by: Wesley Sparks R.S. date 8/18/97

Installed by: Macleod Const. Co.

Certificate of Completion by: Wesley Sparks R.S. date 3/10/98

Operation Permit by: Wesley Sparks R.S. date 3/10/98

HEALTH DEPT. COPY: WHITE INSPECTION COPY (FINAL): GREEN OWNER COPY (FINAL): YELLOW INSPECTION COPY (INITIAL): PINK OWNER COPY (INITIAL): GOLD