IREDELL COUNTY HEALTH DEPARTMENT

Authorization to Construct

STATESVILLE 704-878-5305 MOORESVILLE 704-664-5281

IMPROVEMENT PERMIT / ~~CERTIFICATE OF COMPLETION~~ / OPERATION PERMIT / EXISTING SYSTEM INSPECTION

PROPERTY DESCRIPTION NO. 069189 DATE 9/11/97 TAX MAP NO. 4626401798 Watershed: [X] Yes [ ] No

OWNER OR CONTRACTOR Swissy Barbank PHONE: Business 365-9916 Home

ADDRESS 6525 Morrison Blvd. Charlotte, NC. 28211

LOCATION 119 Wildlris Lane / 1100 TR Chuckwood Tr Monroe Ridge TR Wildlris, on (L) at cuddesac

SUBDIVISION Harbour BLOCK / SECTION III LOT 20 LOT AREA .67 SITE CLASS. PS DESIGN FLOW 480 L.T.A.R. .3

Septic Tank: 1000 Gallons; STB 794 Date 2/25/98

Pump Tank: 1000 Gallons; PT 27 Date 3/21/94

Pump Make: Model Hydromatic Serial No 5HEF50A1

Nitrification Field: No Fields 1 Square Feet ~~X~~ 1260 Linear Feet 420 ~~X~~

No Lines 6 Trench Width 36" Max Trench Bottom Depth 36" Gravel Depth SAND.

[X] New System [ ] Repair System Type: I, II, (III) IV, V, VI

System Description: 6 OUTLET PRES MANIFOLD

Repair System Description: PRESSURE

Maintenance Agreement Required: [X] Yes [ ] No

[X] House/Mod. Home No. Bedrooms 4

[ ] Mobile Home No. Bathrooms 3

[ ] Business No. Employees

[ ] Other


[X] Slab [X] Crawl Space [ ] Basement w/plumbing [ ] Basement wo/plumbing

Water Supply: [ ] Individual [X] Community [ ] Public


Comments: 43 GPM Pump - 180 GAL/DOSE
~~X~~ Chambered Plastic on H.D.S. Drainfield
Lines on contour

Comments:

INITIAL SITE SKETCH

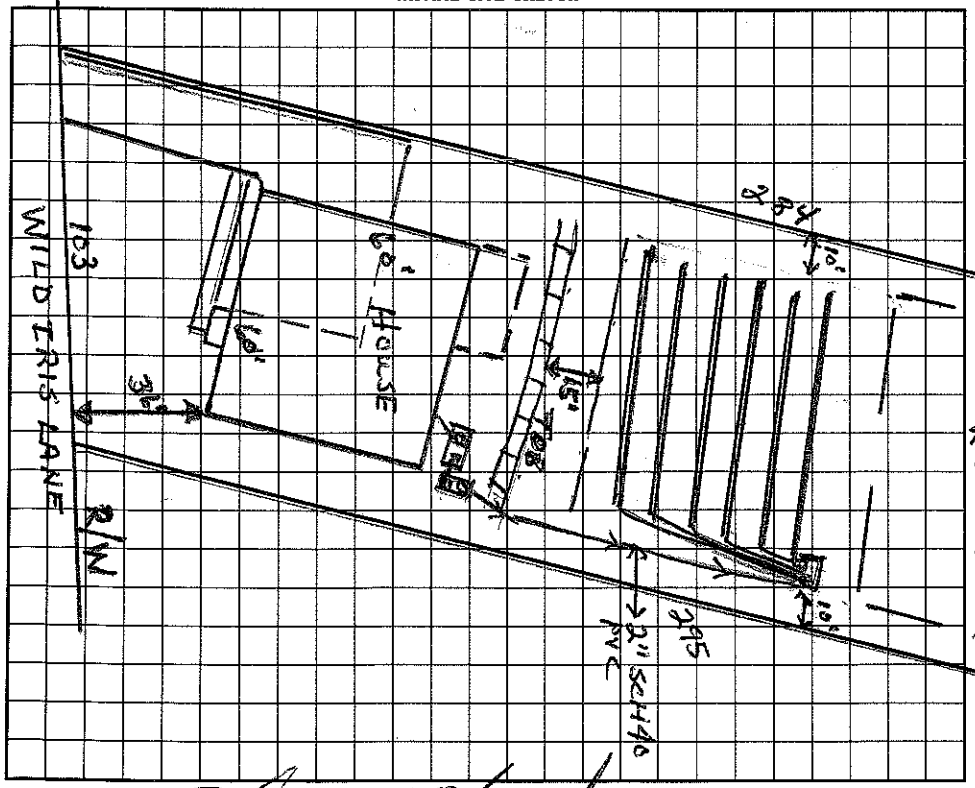

AS BUILT SKETCH

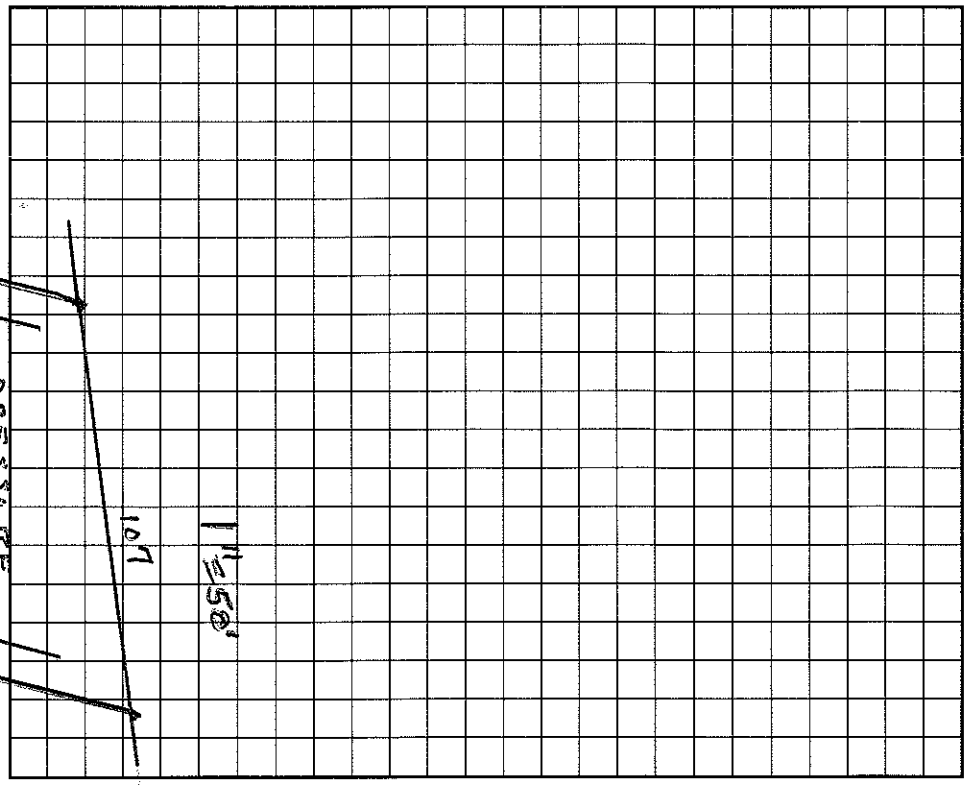

I understand that this permit can be suspended or revoked if any false information is supplied toward securing the permit/any unauthorized changes are made to the site/any unauthorized changes are made in the installation of the system. Improvement Permit is valid for 60 months from date of issuance.

Signed: ~~X~~

Improvement Permit by: Wesley Sparks RS. date 9/11/97

~~Existing System Inspection~~ by: Wesley Sparks RS. date 9/11/97

Installed by: MacLeod Const. Co.

Certificate of Completion by: Wesley Sparks RS. date 6/19/98

Operation Permit by: Wesley Sparks RS. date 6/19/98

HEALTH DEPT. COPY: WHITE INSPECTION COPY (FINAL): GREEN OWNER COPY (FINAL): YELLOW INSPECTION COPY (INITIAL): PINK OWNER COPY (INITIAL): GOLD