IREDELL COUNTY HEALTH DEPARTMENT

STATESVILLE 704-878-5305 MOORESVILLE 704-664-5281

3 30

IMPROVEMENT PERMIT / AUTHORIZATION TO CONSTRUCT / OPERATION PERMIT / EXISTING SYSTEM INSPECTION

PERMIT# 071631 PIN# 4626402523 DATE 1/27/98

OWNER OR CONTRACTOR SAUSSY BURBANK PHONE: Business — Home

ADDRESS 517 SHARON AMITY RD. CHARLOTTE NC 28211

LOCATION BRAWLEY SCHOOL RD - TR BAY HARBOUR - TL LAKE SPRING - 5th ON RT

SUBDIVISION HARBOUR BLOCK / SECTION III LOT 26 LOT AREA — SITE CLASS. PS DESIGN FLOW 480GPD L.T.A.R. .3GPD/FT²

Septic Tank: 1000 Gallons; STB 754 Date 6/15/98

Pump Tank: Gallons; PT Date

Pump Make: Model Serial No.

Nitrification Field: No Fields 1 Square Feet 533 Linear Feet 270

No Lines 6@45 Trench Width 24" Max Trench Bottom Depth 36" Gravel Depth N/A

☑ New System ☐ Repair System Type: I, II, (III), IV, V, VI

System Description: GRAVITY PANEL

Repair System Description: SAME

Maintenance Agreement Required: ☐ Yes ☑ No

☐ Slab ☑ Crawl Space ☐ Basement w/plumbing ☐ Basement wo/plumbing

☑ House/Mod. Home No. Bedrooms 4

☐ Mobile Home No. Bathrooms 4

☐ Business No. Employees


☐ Other

Water Supply:
☐ Individual
☐ Public
☑ Community

Comments:/Conditions:

Comments:/Conditions:

INITIAL SITE SKETCH

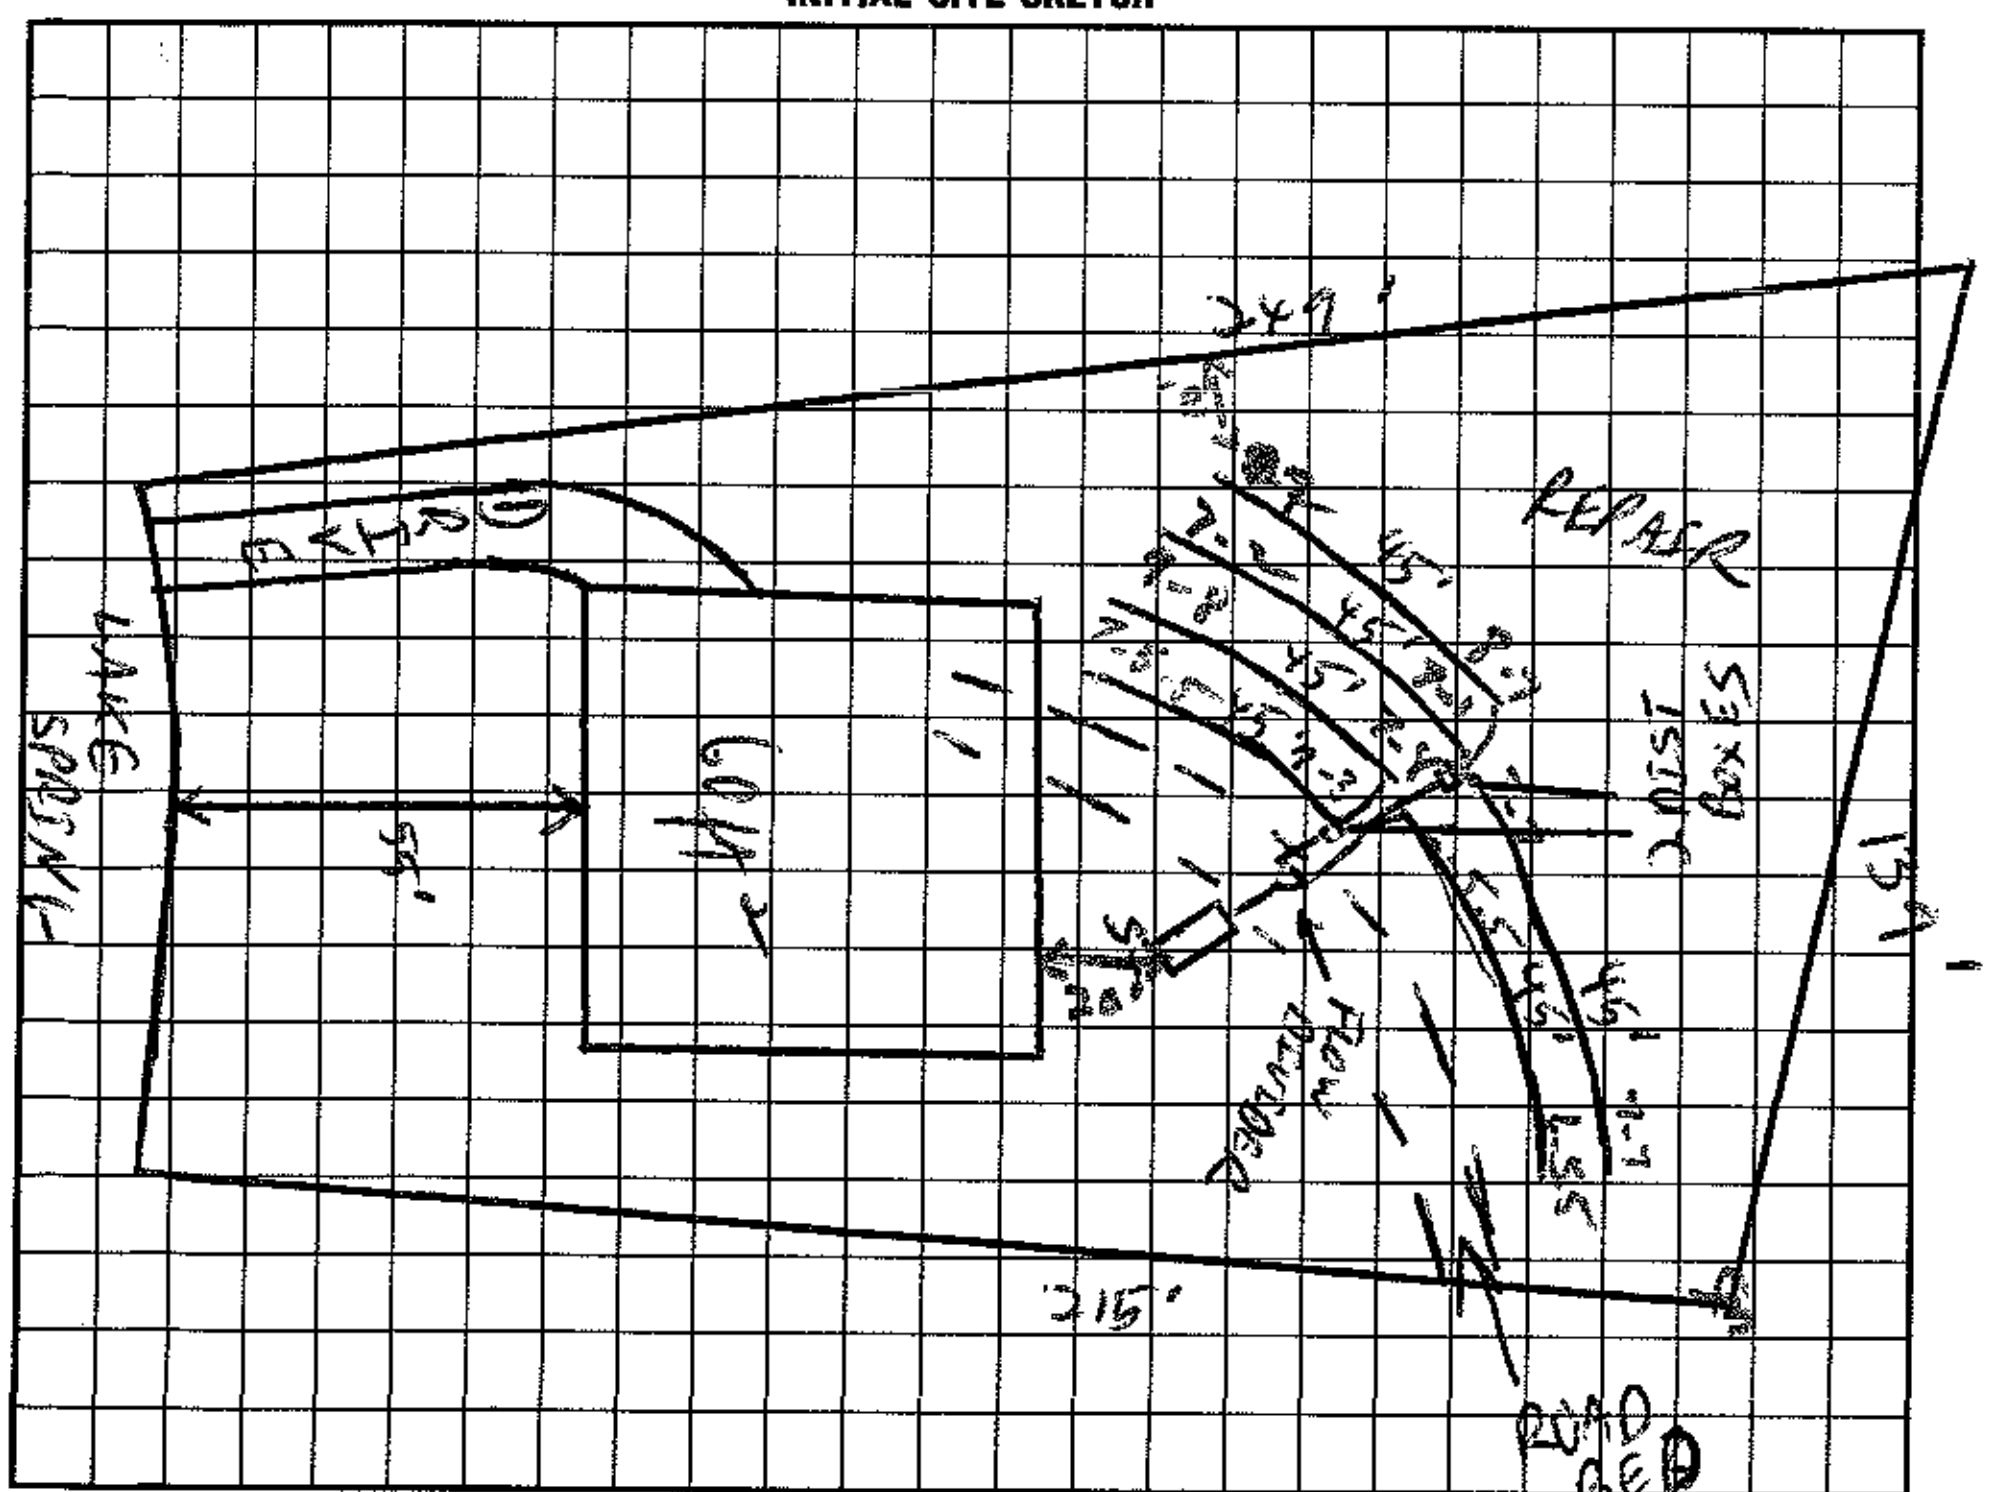

AS BUILT SKETCH

I understand that this permit can be suspended or revoked if any false information is supplied toward securing the permit/any unauthorized changes are made to the site/any unauthorized changes are made in the installation of the system. Improvement Permit with plat valid without expiration. Improvement Permit with site plan valid for sixty months. Authorization to Construct is valid for a period equal to that of Improvement Permit – not to exceed sixty months.

Signed: [signature] date 1/28/98

Improvement Permit by: C. [signature] RS date 1/27/98

Authorization to Construct by: C. [signature] RS date 1/27/98

Installed by: MacLeod Const.

Operation Permit by: Wesley Sparks RS. date 4/5/98

Existing System Inspection by: Wesley Sparks RS date 4/5/98

HEALTH DEPT. COPY: WHITE INSPECTION COPY (FINAL): GREEN OWNER COPY (FINAL): YELLOW INSPECTION COPY (INITIAL): PINK OWNER COPY (INITIAL): GOLD