IREDELL COUNTY HEALTH DEPARTMENT

Authorization to Construct

/ILLE 704-878-5305 MOORESVILLE 704-664-5281

IMPROVEMENT PERMIT / ~~CERTIFICATE OF COMPLETION~~ / OPERATION PERMIT / EXISTING SYSTEM INSPECTION

PROPERTY DESCRIPTION NO. 069188 DATE 9/11/97 TAX MAP NO. 4626403525 Watershed: [X] Yes [ ] No

OWNER OR CONTRACTOR Sawsey Benbenk PHONE: Business 365-9916 Home

ADDRESS 6525 Morrison Blvd. Charlotte NC. 28211

LOCATION 1100 TR Bay Harbour TR Lake Spring 4th lot on (R)

SUBDIVISION HARBOUR BLOCK / SECTION III LOT 25 LOT AREA .54 SITE CLASS. PS. DESIGN FLOW 480 L.T.A.R. .3

Septic Tank: 1000 Gallons; STB 794 Date 11/26/97

Pump Tank: Gallons; PT Date

Pump Make: Model Serial No.

Nitrification Field: No Fields 1 Square Feet 1200 Linear Feet 400*

No Lines 4 Trench Width 36" Max Trench Bottom Depth 36" Gravel Depth SAND.

[X] New System [ ] Repair System Type: I, II, (III) IV, V, VI

System Description: D/BOX — CH. PLASTIC/14DS

Repair System Description: PANEL

Maintenance Agreement Required: [X] Yes [ ] No

[X] House/Mod. Home No. Bedrooms 4

[ ] Mobile Home No. Bathrooms 3

[ ] Business No. Employees

[ ] Other


[ ] Slab [X] Crawl Space [ ] Basement w/plumbing [ ] Basement wo/plumbing

Water Supply: [ ] Individual [X] Community [ ] Public


Comments: * Chambered Plastic

Comments: 2/19/98 - Need Speed Levelers - Label Filter

INITIAL SITE SKETCH

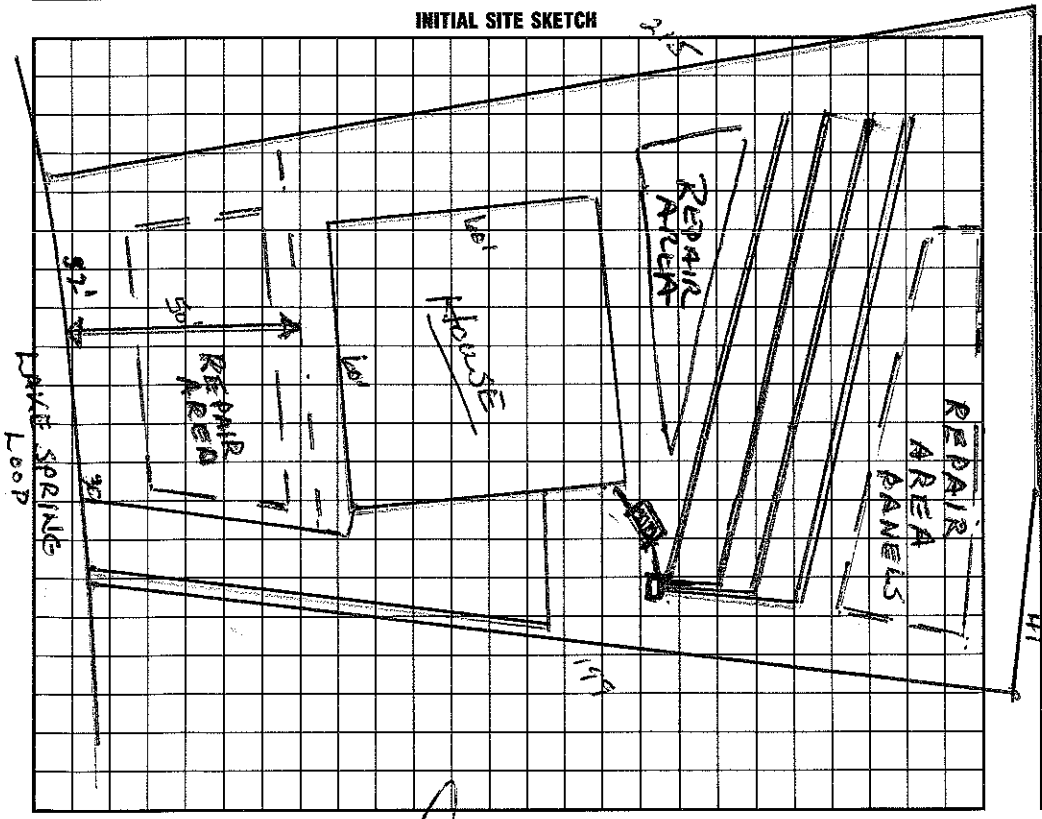

AS BUILT SKETCH

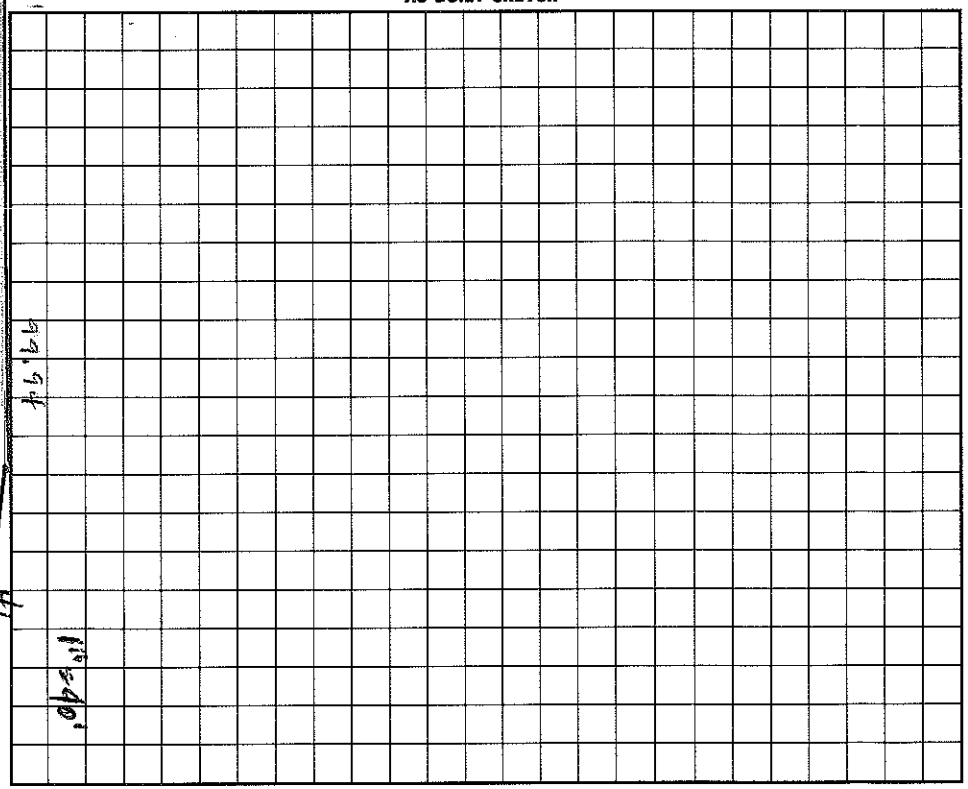

I understand that this permit can be suspended or revoked if any false information is supplied toward securing the permit/any unauthorized changes are made to the site/any unauthorized changes are made in the installation of the system. Improvement Permit is valid for 60 months from date of issuance.

Signed: *

Improvement Permit by: Wesley Sparks RS. date 9/11/97

Existing System Inspection by: Wesley Sparks RS. date 9/11/97

Installed by: Mac Lee Const.

Certificate of Completion by: Wesley Sparks RS date 2/19/98

Operation Permit by: Wesley Sparks RS. date 2/19/98

HEALTH DEPT. COPY: WHITE INSPECTION COPY (FINAL): GREEN OWNER COPY (FINAL): YELLOW INSPECTION COPY (INITIAL): PINK OWNER COPY (INITIAL): GOLD