IREDELL COUNTY HEALTH DEPARTMENT

Authorization to Construct

STATESVILLE 704-878-5305 MOORESVILLE 704-664-5281

IMPROVEMENT PERMIT / ~~CERTIFICATE OF COMPLETION~~ / OPERATION PERMIT / EXISTING SYSTEM INSPECTION

PROPERTY DESCRIPTION NO. 66015 DATE 4/5/97 TAX MAP NO. 4626404535 Watershed: [X] Yes [ ] No

OWNER OR CONTRACTOR Jamsay Burbage PHONE: Business 365-9916 Home WSIVCA

ADDRESS 6525 Monroe Blvd. Chas. NC. 28211

LOCATION 122 Lake Spring Drive Bay Hebron TR 1st Lake Spring on (R) at corner of Morrow Ridge

SUBDIVISION HARBOR BLOCK/ SECTION 3 LOT 24 LOT AREA .5Ac SITE CLASS. PS DESIGN FLOW 480 L.T.A.R. .3

Septic Tank: 1000 Gallons; STB 794 Date 2/7/97
Pump Tank: ____ Gallons; PT ____ Date ____
Pump Make: ____ Model ____ Serial No. ____
Nitrification Field: No Fields 1 Square Feet 900* Linear Feet 300*
No Lines 3 Trench Width 36" Max Trench Bottom Depth 36" Gravel Depth SAND

[X] New System [ ] Repair System Type: I, II, III, IV, V, VI
System Description: Ch Plastic - Bundy
Repair System Description: Same
Maintenance Agreement Required: [X] Yes [ ] No


[X] House/Mod. Home No. Bedrooms 4
[ ] Mobile Home No. Bathrooms 2.5
[ ] Business No. Employees ____
[ ] Other ____
[ ] Slab [X] Crawl Space [ ] Basement w/plumbing [ ] Basement wo/plumbing

Water Supply:
[ ] Individual
[X] Community
[ ] Public


Comments: * 25% reduction for Ch Plastic use

Comments:

INITIAL SITE SKETCH

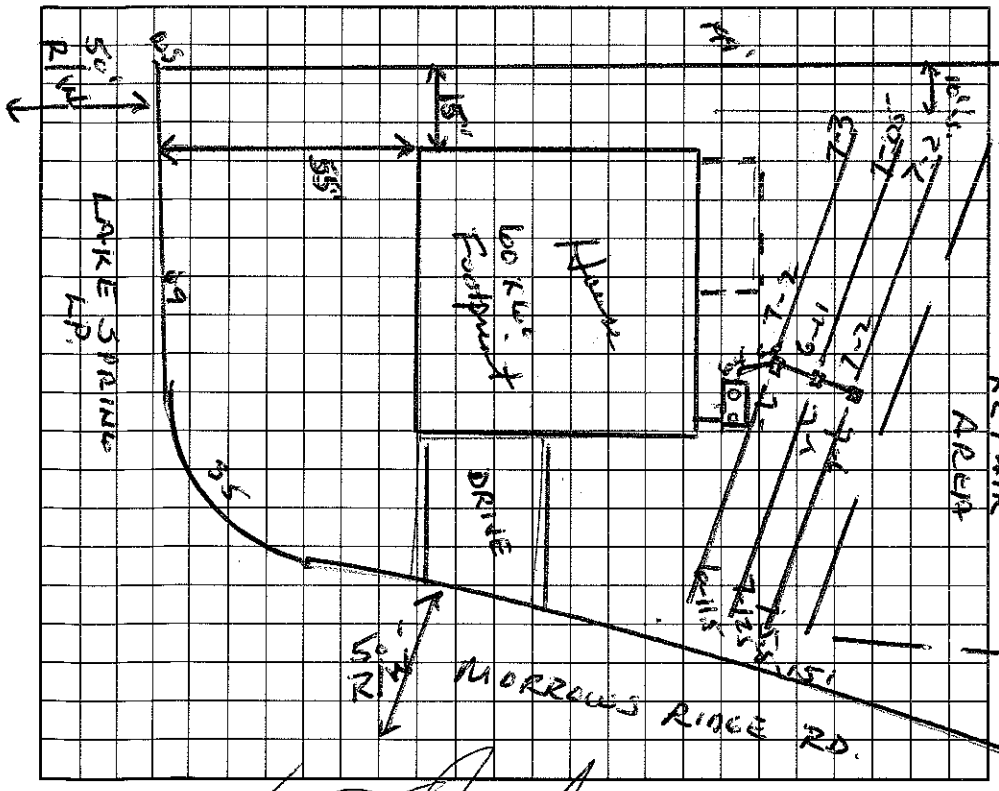

AS BUILT SKETCH

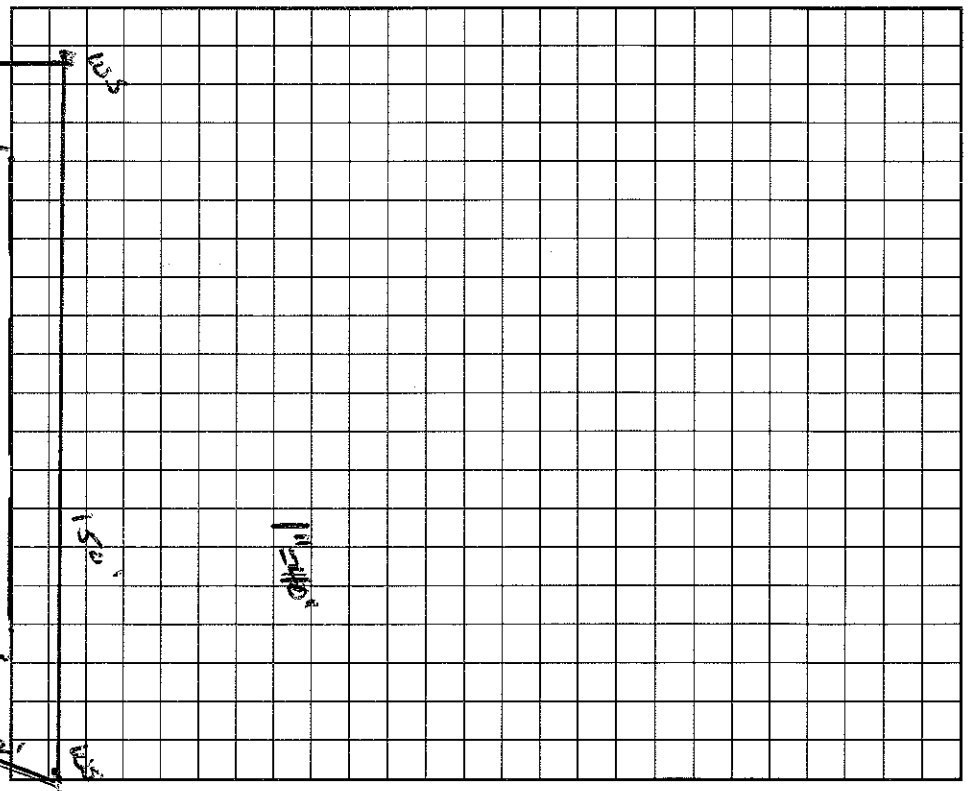

I understand that this permit can be suspended or revoked if any false information is supplied toward securing the permit/any unauthorized changes are made to the site/any unauthorized changes are made in the installation of the system. Improvement Permit is valid for 60 months from date of issuance.

Signed: * [signature]

Improvement Permit by: Wesley Sparks RS. date 4/5/97

Existing System Inspection by: Wesley Sparks RS. date 4/5/97

Installed by: Morhead Const.

Certificate of Completion by: Wesley Sparks RS. date 9/5/97

Operation Permit by: Wesley Sparks RS. date 9/5/97

Authorization

HEALTH DEPT. COPY: WHITE INSPECTION COPY (FINAL): GREEN OWNER COPY (FINAL): YELLOW INSPECTION COPY (INITIAL): PINK OWNER COPY (INITIAL): GOLD