IREDELL COUNTY HEALTH DEPARTMENT

Am Homes Construct

ATESVILLE 704-878-5305 MOORESVILLE 704-664-5281

IMPROVEMENT PERMIT / ~~CERTIFICATE OF COMPLETION~~ / OPERATION PERMIT / EXISTING SYSTEM INSPECTION

PROPERTY DESCRIPTION NO. 069626 DATE 9/25/97 TAX MAP NO. 4626404709 Watershed: ☒ Yes ☐ No

OWNER OR CONTRACTOR Sussex Burbank PHONE: Business 365-9916 Home

ADDRESS 6525 Morrison Blvd. Charlotte, NC.

LOCATION Brawley Sch TR Bay Harbour TR Lake Spring TR Morrow Ridge TL Wildflower Lane

SUBDIVISION HARBOUR BLOCK / SECTION III LOT 27 LOT AREA .58 SITE CLASS. PS DESIGN FLOW 480 L.T.A.R. .275

Septic Tank: 1000 Gallons; STB 794 Date 10/8/97

Pump Tank: 1000 Gallons; PT 271 Date 12/7/97

Pump Make: HYDROMATIC Model SK 60M1 Serial No. 7/97

Nitrification Field: No Fields 1 Square Feet 1350 Linear Feet 450

No Lines 6 Trench Width 36" Max Trench Bottom Depth 32" Gravel Depth SAND.

☒ New System ☐ Repair System Type: I, II, (III) IV, V, VI

System Description: Press Man — CH PLASTICORHIS

Repair System Description:

Maintenance Agreement Required: ☒ Yes ☐ No

☒ House/Mod. Home No. Bedrooms 4

☐ Mobile Home No. Bathrooms 3

☐ Business No. Employees

☐ Other

Water Supply: ☐ Individual ☒ Community ☐ Public


☐ Slab ☒ Crawl Space ☐ Basement w/plumbing ☐ Basement wo/plumbing

Comments:

Comments:

450 270
.06 .64
27.0.0 1620
1620
1458

INITIAL SITE SKETCH

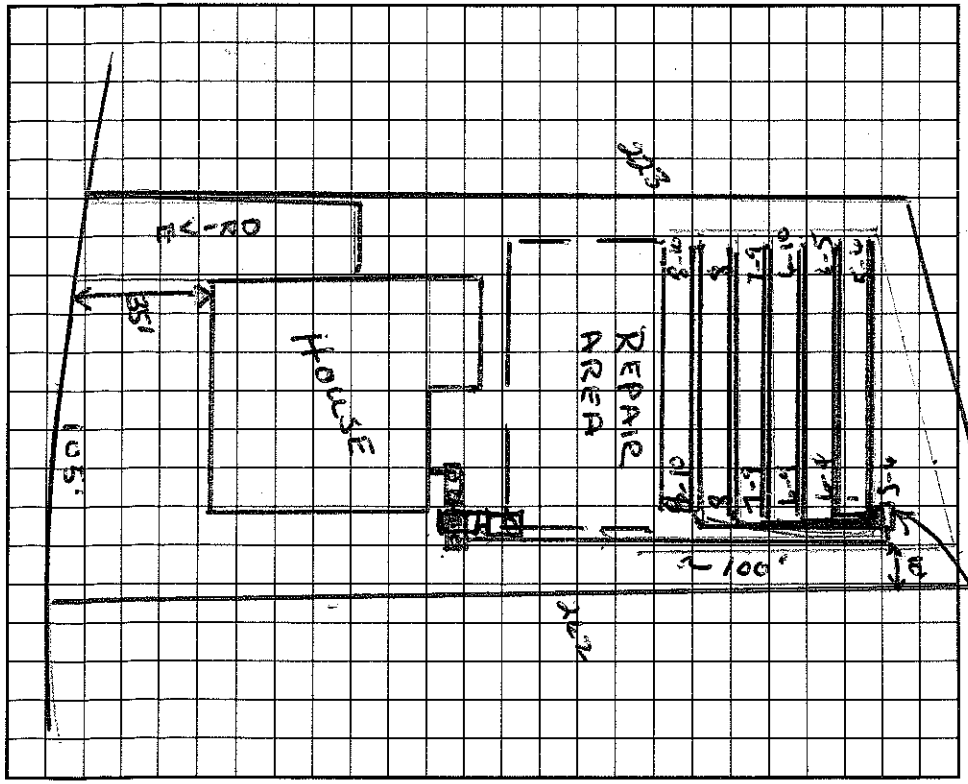

AS BUILT SKETCH

I understand that this permit can be suspended or revoked if any false information is supplied toward securing the permit/any unauthorized changes are made to the site/any unauthorized changes are made in the installation of the system. Improvement Permit is ~~valid~~ for 60 months from date of issuance.

Signed: *

Improvement Permit by: Wesley Sparks R.S. date 9/25/97

Existing System Inspection by: Wesley Sparks R.S. date 9/25/97

Installed by: MacLeod Const.

Certificate of Completion by: Wesley Sparks R.S. date 2/19/98

Operation Permit by: Wesley Sparks R.S. date 2/19/98

HEALTH DEPT. COPY: WHITE INSPECTION COPY (FINAL): GREEN OWNER COPY (FINAL): YELLOW INSPECTION COPY (INITIAL): PINK OWNER COPY (INITIAL): GOLD