IREDELL COUNTY HEALTH DEPARTMENT Const. Auth. STATESVILLE 704-878-5305 MOORESVILLE 704-664-5281

IMPROVEMENT PERMIT / ~~CERTIFICATE OF COMPLETION~~ / OPERATION PERMIT / EXISTING SYSTEM INSPECTION

PROPERTY DESCRIPTION NO. 23362 DATE June 5 '96 TAX MAP NO. part of 2CA3 4626 405717 Watershed: ☑ Yes ☐ No

OWNER OR CONTRACTOR Crescent Properties, Inc James BURBANK PHONE: Business _____ Home _____

ADDRESS PO Box 1007 Charlotte

LOCATION Brawley Sch Rd. TR Chickenwood TL Morrow's Ridge Ln. on Right @ jct w/ Wild Iris

SUBDIVISION The Harbours BLOCK / SECTION ~~III~~ LOT 23 LOT AREA 20,000 ft²+ SITE CLASS. Spr. 1996 DESIGN FLOW ~~440 gpd~~ L.T.A.R. .3

Septic Tank: 1000 Gallons; STB 794 Date 1/29/99

Pump Tank: 1000 Gallons; PT 27 Date 4/7/99

Pump Make: HYDROMATIC Model SK50A1 Serial No. 7/97

Nitrification Field: No Fields 1 Square Feet 540 Linear Feet 270

No Lines 4 Trench Width 24" Max Trench Bottom Depth 30" Gravel Depth NA

☑ New System ☐ Repair System Type: I, II, III, IV, V, VI

System Description: LPP PBPS

Repair System Description: LPP PBPS

Maintenance Agreement Required: ☑ Yes ☐ No

☑ House/Mod. Home ☐ Mobile Home ☐ Business ☐ Other

No. Bedrooms 4 No. Bathrooms 4 No. Employees ____

☐ Slab ☑ Crawl Space ☐ Basement w/plumbing ☐ Basement wo/plumbing


Water Supply: ☐ Individual ☐ Community ☑ Public

Comments:

Comments: installed as shown.

1" = 50'

INITIAL SITE SKETCH

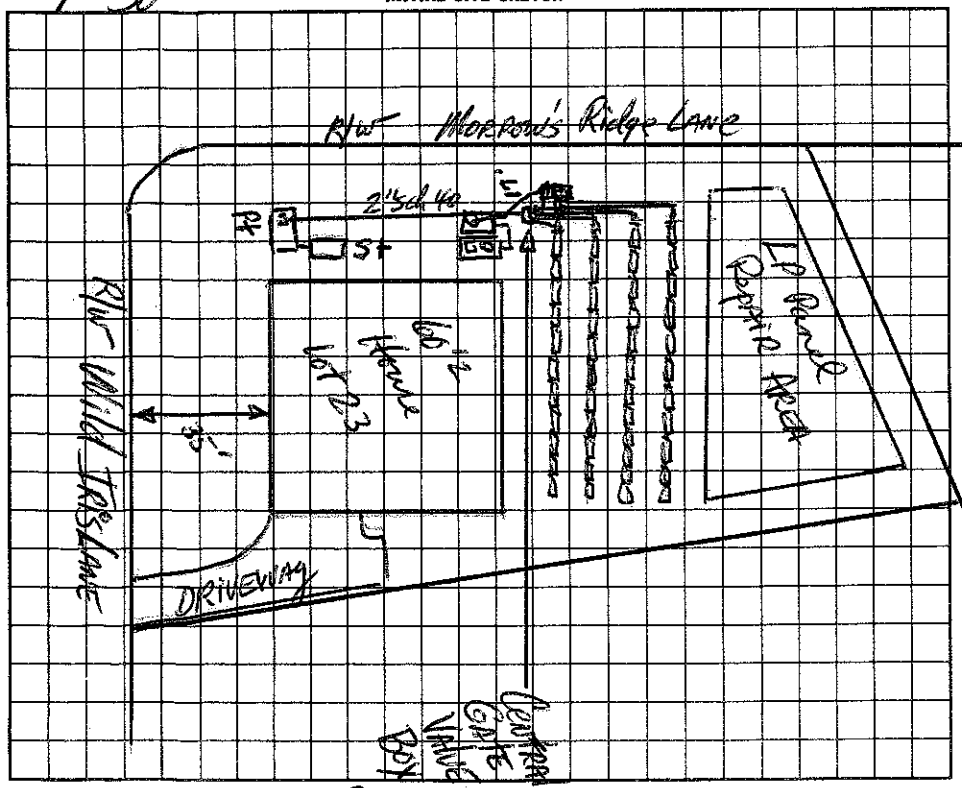

AS BUILT SKETCH

I understand that this permit can be suspended or revoked if any false information is supplied toward securing the permit/any unauthorized changes are made to the site/any unauthorized changes are made in the installation of the system.

Signed: Tony C. Rogers, RS

Improvement Permit by: Mark Hinson, RS date 6-5-96

~~Const.~~ Existing System Inspection by: Wesley Sparks RS. date 9/10/98

Installed by: MacLeod

Certificate of Completion by: Wesley Sparks RS. date 5/17/99

Operation Permit by: _____ date _____

~~Const.~~ Auth. HEALTH DEPT. COPY: WHITE INSPECTION COPY (FINAL): GREEN OWNER COPY (FINAL): YELLOW INSPECTION COPY (INITIAL): PINK OWNER COPY (INITIAL): GOLD