Authorization to Construct

IREDELL COUNTY HEALTH DEPARTMENT

STATESVILLE 704-878-5305 MOORESVILLE 704-664-5281

IMPROVEMENT PERMIT / ~~CERTIFICATE OF COMPLETION~~ / OPERATION PERMIT / EXISTING SYSTEM INSPECTION

PROPERTY DESCRIPTION NO. 25509 DATE 11/12/96 TAX MAP NO. 2C A 3 (Pt) Watershed: ☒ Yes ☐ No

OWNER OR CONTRACTOR [illegible] Burbank PHONE: Business 365-9916 Home 4626-406438

ADDRESS 6525 Morrison Blvd Charlotte, N.C.

LOCATION Morrows Ridge Rd. - 1100 TR BAY HARBOUR TR LAKE SPRING Lp. TR MORROWS RIDGE, 1st on (R) (CORNER)

SUBDIVISION HARBOUR BLOCK / SECTION 3 LOT 7 LOT AREA 20,000 FT² SITE CLASS. PS DESIGN FLOW 480 L.T.A.R. .3

Septic Tank: 1000 Gallons; STB 794 Date 12/15/96

Pump Tank: ______ Gallons; PT ______ Date ______

Pump Make: ______ Model ______ Serial No. AV 400

Nitrification Field: No Fields 1 Square Feet *1800 Linear Feet *1200

No Lines 5 Trench Width 36" Max Trench Bottom Depth 36" Gravel Depth SAND

☒ New System ☐ Repair System Type: I, II, (III), IV, V, VI

System Description: *GRAV-CH PLASTIC

Repair System Description: * SAME

Maintenance Agreement Required: ☐ Yes ☒ No

☒ House/Mod. Home ☐ Mobile Home ☐ Business ☐ Other ______

No. Bedrooms 4 No. Bathrooms 2.5 No. Employees ______


☐ Slab ☒ Crawl Space ☐ Basement w/plumbing ☐ Basement wo/plumbing

Water Supply: ☐ Individual ☒ Community ☐ Public

Comments:

Comments: Lines run as drawn - Dist Box set where top line begins - speed levelers used

INITIAL SITE SKETCH

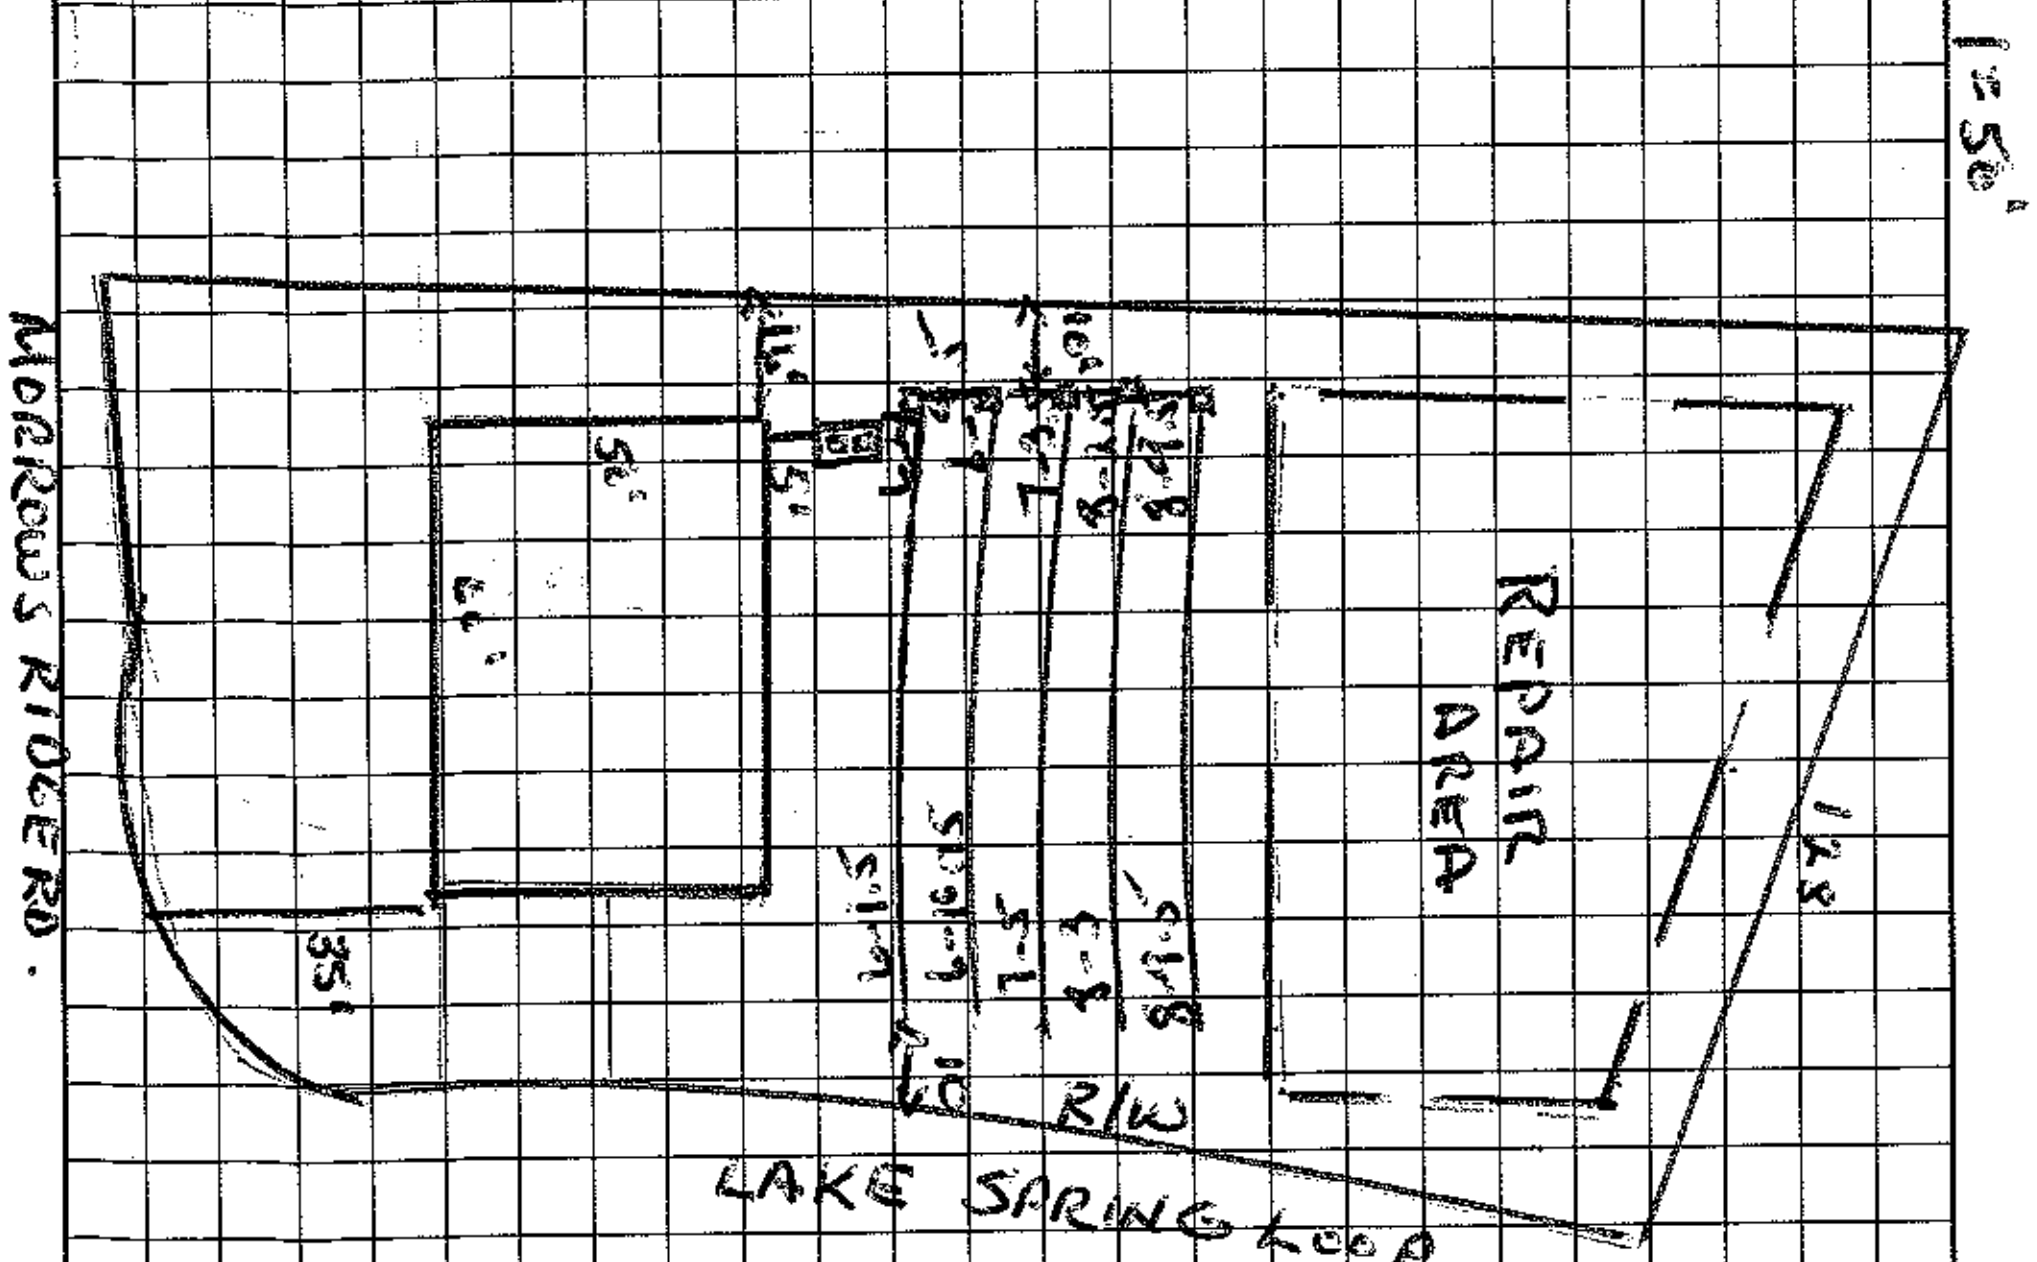

AS BUILT SKETCH

I understand that this permit can be suspended or revoked if any false information is supplied toward securing the permit/any unauthorized changes are made to the site/any unauthorized changes are made in the installation of the system.

Signed: * [signature]

Improvement Permit by: Wesley Sparks R.S. date 11/12/96

System Inspection by: Wesley Sparks R.S. date 11/12/96

Installed by: MacLeod Const.

Certificate of Completion by: Wesley Sparks R.S. date 2/27/97

Operation Permit by: Wesley Sparks R.S. date 2/27/97

HEALTH DEPT. COPY: WHITE INSPECTION COPY (FINAL): GREEN OWNER COPY (FINAL): YELLOW INSPECTION COPY (INITIAL): PINK OWNER COPY (INITIAL): GOLD