IREDELL COUNTY HEALTH DEPARTMENT

STATESVILLE 704-878-5305 MOORESVILLE 704-664-5281

IMPROVEMENT PERMIT / AUTHORIZATION TO CONSTRUCT / OPERATION PERMIT / EXISTING SYSTEM INSPECTION

PERMIT# 073064 PIN# 4626 40 4597 DATE 5/12/98

OWNER OR CONTRACTOR Dewey Burbank PHONE: Business 945-1515 Home

ADDRESS 517 Sharon Amity Dr. Suite 100 Charlotte, NC. 28211

LOCATION Brawley Sch TR Chuckwood TL Morocco Ridge to 6th lot on (L)

SUBDIVISION HARBOUR BLOCK / SECTION III LOT 6 LOT AREA .68 SITE CLASS. PS DESIGN FLOW 480 L.T.A.R. .3

Septic Tank: 1000 Gallons; STB 794 Date 7/28/98
Pump Tank: Gallons; PT Date
Pump Make: Model Serial No.
Nitrification Field: No Fields 1 Square Feet 1200* Linear Feet 400*
No Lines X 5 Trench Width 36" Max Trench Bottom Depth 36"

X New System ☐ Repair System Type: I, II, (III) IV, V, VI
System Description: GRAV → CH. PLASTIC
Repair System Description: SAME
Maintenance Agreement Required: ☐ Yes X No
Gravel Depth SAND


X House/Mod. Home No. Bedrooms 4
☐ Mobile Home No. Bathrooms 3
☐ Business No. Employees
☐ Other
☐ Slab X Crawl Space ☐ Basement w/plumbing ☐ Basement wo/plumbing

Water Supply: ☐ Individual ☐ Public X Community


Comments:/Conditions: * 25% REDUCTION FOR CH. PLASTIC
MINIMUM GRADING REQUIRED FOR HOUSE

Comments:/Conditions:

INITIAL SITE SKETCH

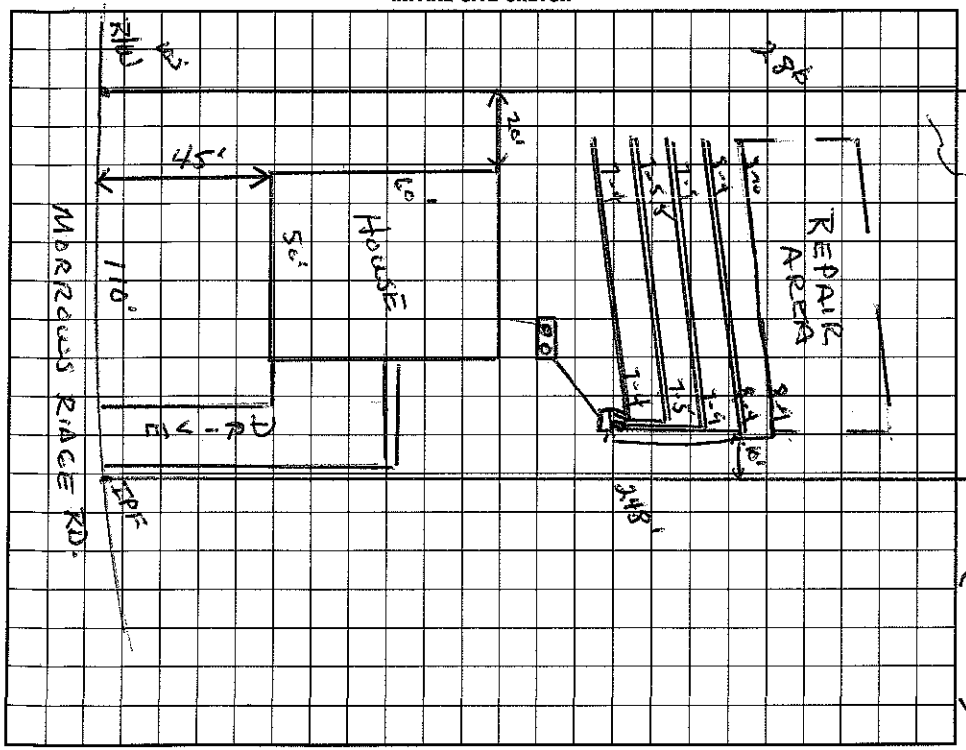

AS BUILT SKETCH

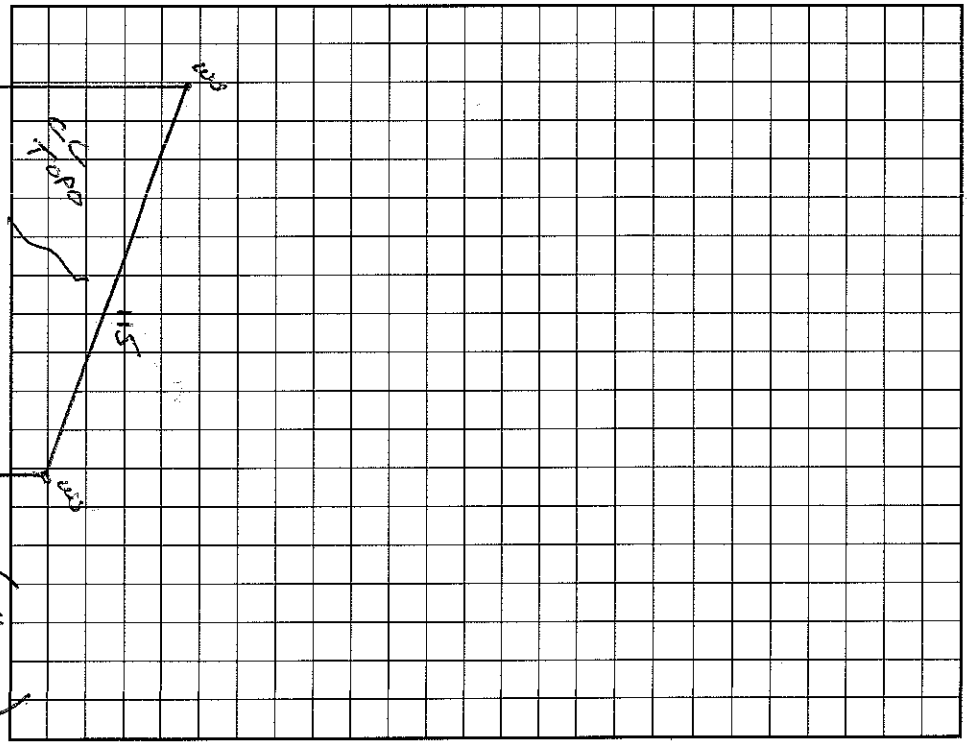

I understand that this permit can be suspended or revoked if any false information is supplied toward securing the permit/any unauthorized changes are made to the site/any unauthorized changes are made in the installation of the system. Improvement Permit with plat valid without expiration. Improvement Permit with site plan valid for sixty months. Authorization to Construct is valid for a period equal to that of Improvement Permit – not to exceed sixty months.

Signed: * date

Improvement Permit by: Wesley Sparks R.S. date 5/12/98

Authorization to Construct by: Wesley Sparks R.S. date 5/12/98

Installed by: McCloud

Operation Permit by: date 11/17/98

Existing System Inspection by: date

HEALTH DEPT. COPY: WHITE INSPECTION COPY (FINAL): GREEN OWNER COPY (FINAL): YELLOW INSPECTION COPY (INITIAL): PINK OWNER COPY (INITIAL): GOLD