IREDELL COUNTY HEALTH DEPARTMENT

.TESVILLE 704-878-5305 MOORESVILLE 704-664-5281

IMPROVEMENT PERMIT / CERTIFICATE OF COMPLETION / OPERATION PERMIT / EXISTING SYSTEM INSPECTION

PROPERTY DESCRIPTION NO. 071899 DATE 2/19/98 TAX MAP NO. 4626 40 7647 Watershed: [X] Yes [ ] No

OWNER OR CONTRACTOR Jaussy Burbank PHONE: Business 945-1515 Home WSIVCA

ADDRESS 517 Sharon Amity Suite 100

LOCATION 1100 TR Chuckwood TL Morrow Ridge, on (L) 3RD lot before intersection

SUBDIVISION HARBOUR BLOCK / SECTION III LOT 5 LOT AREA ~.86 SITE CLASS. PS DESIGN FLOW 480 L.T.A.R. .35

Septic Tank: 1000 Gallons; STB ____ Date ____

Pump Tank: ____ Gallons; PT ____ Date ____

Pump Make: ____ Model ____ Serial No. ____

Nitrification Field: No Fields 1 Square Feet 900 Linear Feet 342 Adj

No Lines 3 Trench Width 36" Max Trench Bottom Depth 36" Gravel Depth SAND

[X] New System [ ] Repair System Type: I, II, (III) IV, V, VI

System Description: GRAV - CH PLASTIC

Repair System Description: SAME

Maintenance Agreement Required: [ ] Yes [ ] No

[X] House/Mod. Home No. Bedrooms 4

[ ] Mobile Home No. Bathrooms 2.5

[ ] Business No. Employees ____

[ ] Other ____


[ ] Slab [X] Crawl Space [ ] Basement w/plumbing [ ] Basement wo/plumbing

Water Supply: [ ] Individual [ ] Community [X] Public


Comments:

Comments: 8/10/98 - ZABEL FILTER MISSING

INITIAL SITE SKETCH

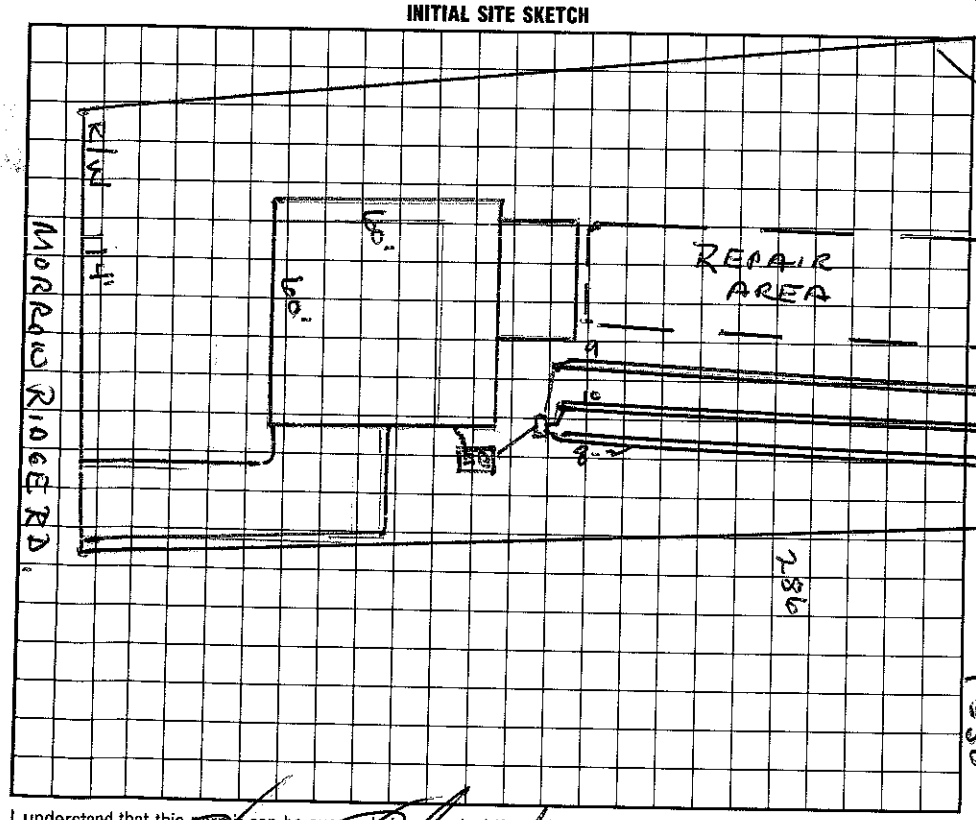

AS BUILT SKETCH

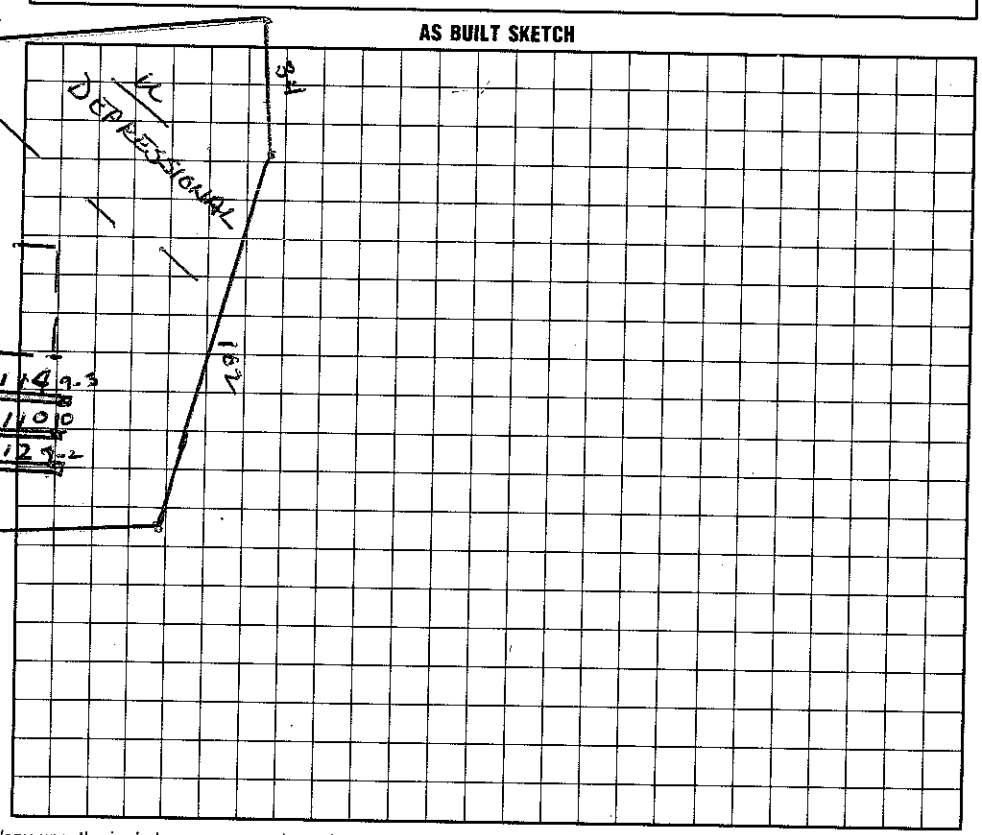

I understand that this permit can be suspended or revoked if any false information is supplied toward securing the permit/any unauthorized changes are made to the site/any unauthorized changes are made in the installation of the system.

Signed: X 2/20/98

Improvement Permit by: Wesley Sparks RS. date 2/19/98 Installed by: Macheo d Const.

Existing System Inspection by: Wesley Sparks RS. date 2/19/98 Certificate of Completion by: ____ date ____

Operation Permit by: Wesley Sparks RS. date 8/14/98

HEALTH DEPT. COPY: WHITE INSPECTION COPY (FINAL): GREEN OWNER COPY (FINAL): YELLOW INSPECTION COPY (INITIAL): PINK OWNER COPY (INITIAL): GOLD