IREDELL COUNTY HEALTH DEPARTMENT

STATESVILLE 704-878-5305 MOORESVILLE 704-664-5281

IMPROVEMENT PERMIT / AUTHORIZATION TO CONSTRUCT / OPERATION PERMIT / EXISTING SYSTEM INSPECTION

3-30

PERMIT# 074773 PIN# 4626 40 7798 DATE 7/2/98

OWNER OR CONTRACTOR Sawyer Burbank PHONE: Business 945-1515 Home

ADDRESS 517 Sharon Amity Rd. Charlotte, NC. 28211

LOCATION 1100 TR Bay Harbour TR Lake Spring Lp. TR Morrow Ridge to 4th on (R)

SUBDIVISION Harbour BLOCK / SECTION 3 LOT 4 LOT AREA .83 SITE CLASS PS DESIGN FLOW 480 L.T.A.R. .3

Septic Tank: 1000 Gallons; STB 794 Date 11/11/98
Pump Tank: Gallons; PT Date
Pump Make: Model Serial No.
Nitrification Field: No Fields 1 Square Feet 1200 Linear Feet 400
No Lines 4 Trench Width 36" Max Trench Bottom Depth 36" Gravel Depth SAND.

[X] New System [ ] Repair System Type: I, II, (III), IV, V, VI
System Description: GRAVITY - CH PLASTIC
Repair System Description: SAME
Maintenance Agreement Required: [ ] Yes [X] No

[X] House/Mod. Home No. Bedrooms 4
[ ] Mobile Home No. Bathrooms 3
[ ] Business No. Employees
[ ] Other

[ ] Slab [X] Crawl Space [ ] Basement w/plumbing [ ] Basement wo/plumbing


Water Supply:
[ ] Individual
[ ] Public
[X] Community

Comments:/Conditions:


Comments:/Conditions:

DIST BOX LEAKS.

INITIAL SITE SKETCH

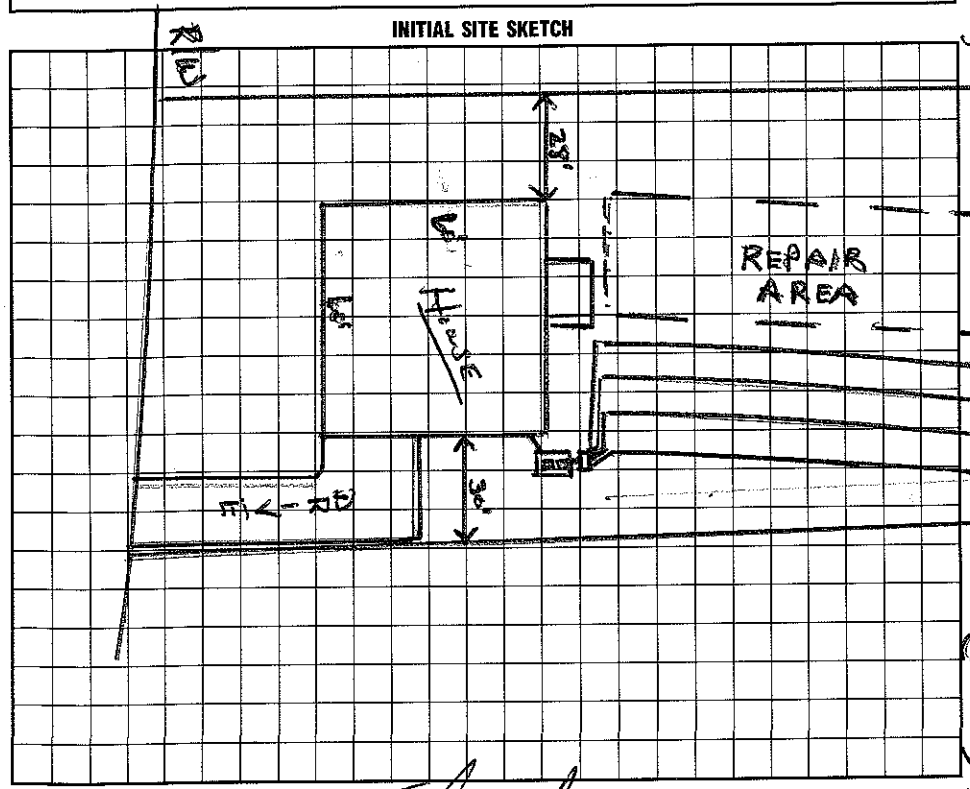

AS BUILT SKETCH

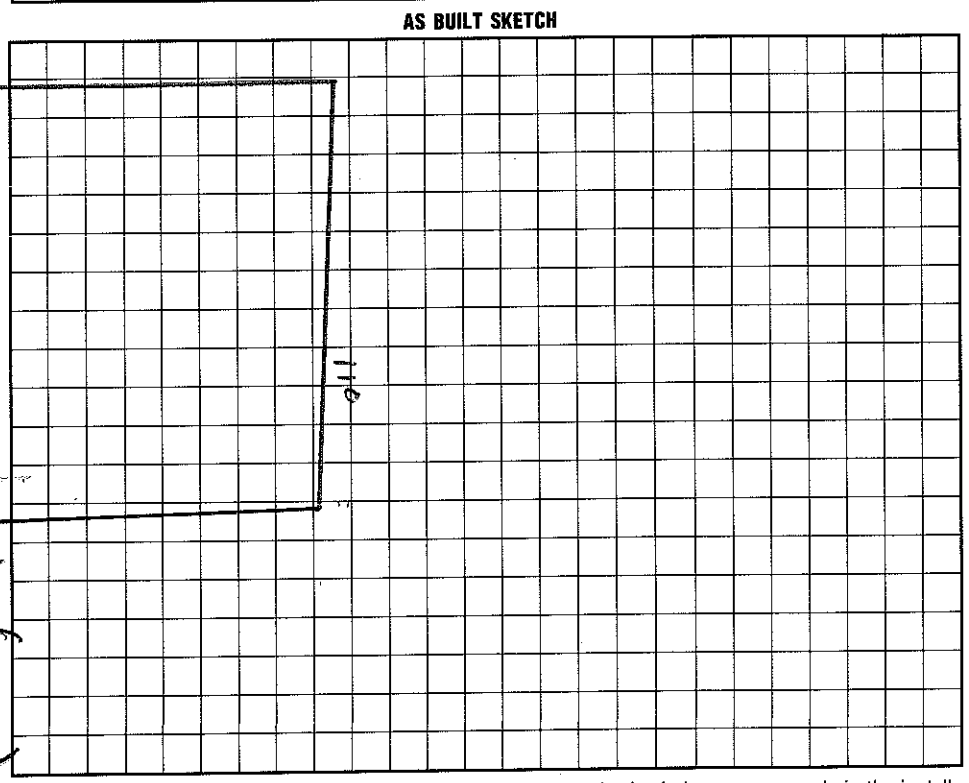

I understand that this permit can be suspended or revoked if any false information is supplied toward securing the permit/any unauthorized changes are made to the site/any unauthorized changes are made in the installation of the system. Improvement Permit with plat valid without expiration. Improvement Permit with site plan valid for sixty months. Authorization to Construct is valid for a period equal to that of Improvement Permit – not to exceed sixty months.

Signed: [signature] date 7/7/98

Improvement Permit by: Wesley Sparks R.S. date 7/6/98

Authorization to Construct by: Wesley Sparks R.S. date 7/6/98

Installed by: McCloud Const.

Operation Permit by: Wesley Sparks RS date 2/9/99

Existing System Inspection by: date

HEALTH DEPT. COPY: WHITE INSPECTION COPY (FINAL): GREEN OWNER COPY (FINAL): YELLOW INSPECTION COPY (INITIAL): PINK OWNER COPY (INITIAL): GOLD