IREDELL COUNTY HEALTH DEPARTMENT

AUTHORIZATION TO CONSTRUCT

STATESVILLE 704-878-5305 MOORESVILLE 704-664-5281

IMPROVEMENT PERMIT / ~~CERTIFICATE OF COMPLETION~~ / OPERATION PERMIT / EXISTING SYSTEM INSPECTION

PROPERTY DESCRIPTION NO. 22288 DATE 10/16/95 TAX MAP NO. 2F 12A 71 Watershed: [X] Yes [ ] No

OWNER OR CONTRACTOR Murray Burbank PHONE: Business 892-0660 ~~Home~~ 4626-40-8065

ADDRESS PO Box 176 Davidson, NC. 28036

LOCATION Beaty S.h Rd. TR Bay Harbour on (L) just past Beach Funct.

SUBDIVISION HARBOUR BLOCK / SECTION ~~MAPE~~ LOT 71 LOT AREA .401 AC SITE CLASS. PS DESIGN FLOW 480 L.T.A.R. .35

Septic Tank: 1000 Gallons; STB 794 Date 11/25/95

Pump Tank: _____ Gallons; PT _____ Date _____

Pump Make: _____ Model _____ Serial No. _____

Nitrification Field: No Fields 1 Square Feet 1371 Linear Feet *350

No Lines 5 Trench Width 36" Max Trench Bottom Depth 30" Gravel Depth N/A

[X] New System [ ] Repair System Type: I, II, (III) IV, V, VI

System Description: INFILTRATOR

Repair System Description: PANEL 16"

Maintenance Agreement Required: [ ] Yes [X] No

[X] House/Mod. Home No. Bedrooms 4

[ ] Mobile Home No. Bathrooms 2.5

[ ] Business No. Employees ____

[ ] Other _____


[ ] Slab [X] Crawl Space [ ] Basement w/plumbing [ ] Basement wo/plumbing

Water Supply: [ ] Individual [X] Community [ ] Public


Comments: Gravity chaf Infiltrator - Dist Box w/ Speed Levelers -

Comments:

INITIAL SITE SKETCH

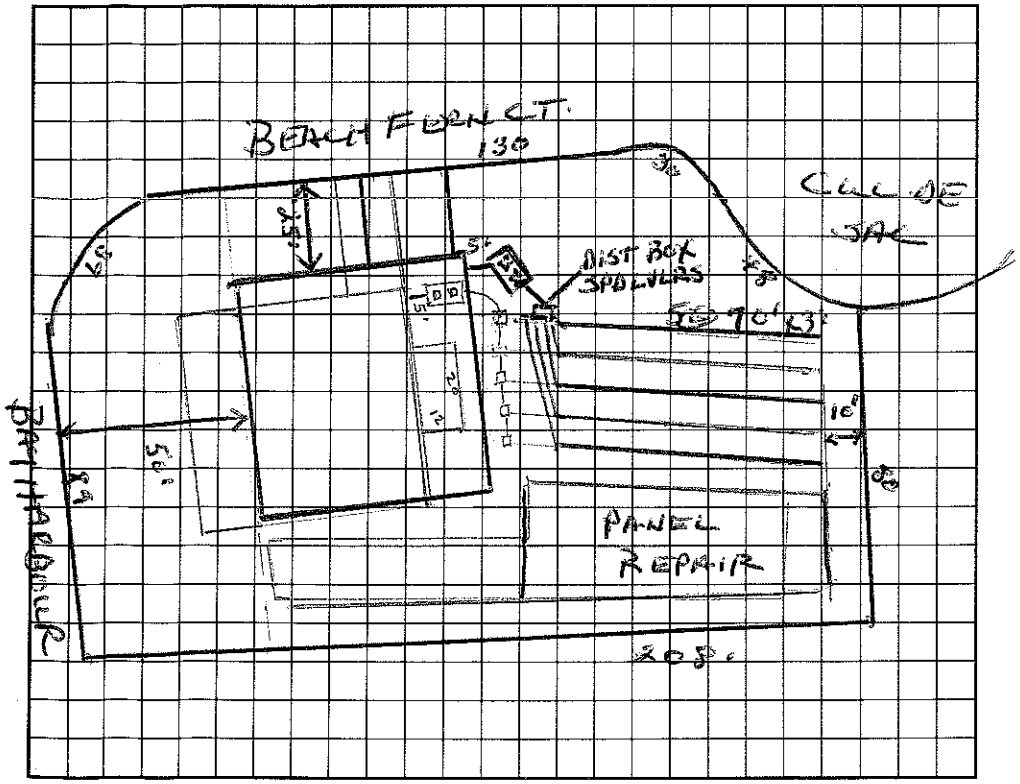

AS BUILT SKETCH

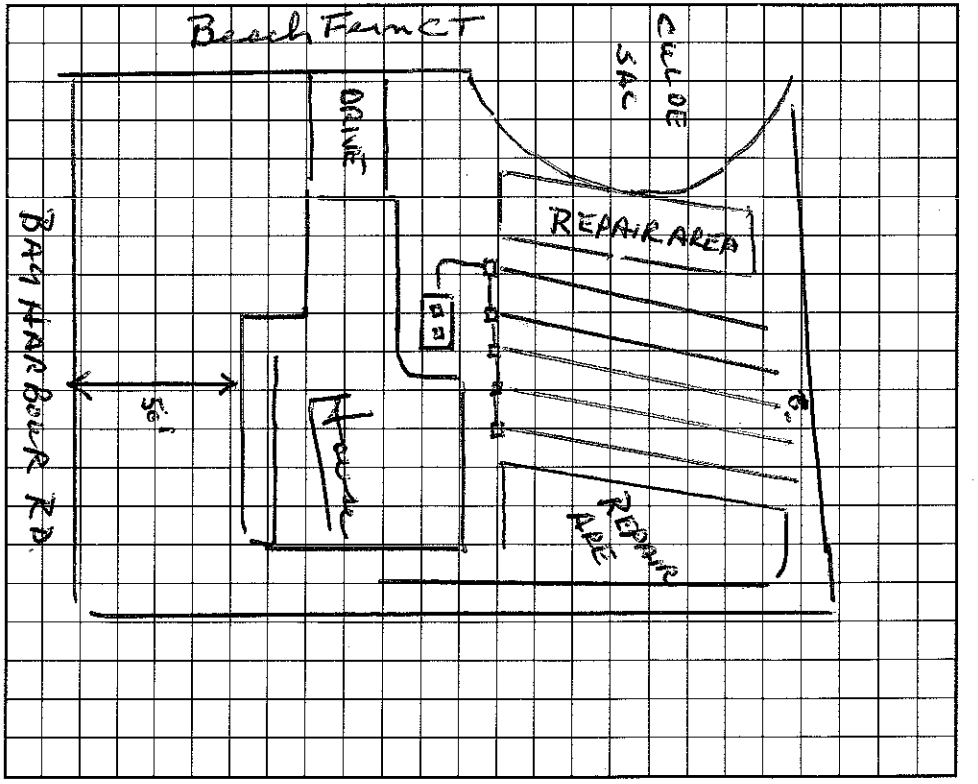

I understand that this permit can be suspended or revoked if any false information is supplied toward securing the permit/any unauthorized changes are made to the site/any unauthorized changes are made in the installation of the system.

Authorization to Construct valid 5 years. Op. Permit indefinitely valid

Signed: _____ Installed by: Barry J. Thompson

Improvement Permit by: Wesley Sparks RS date 10/17/95

Certificate of Completion by: _____ date _____

Existing System Inspection by: to Construct. Wesley Sparks date 10/17/95

Operation Permit by: Wesley Sparks RS. date 5/1/96

HEALTH DEPT. COPY: WHITE INSPECTION COPY (FINAL): GREEN OWNER COPY (FINAL): YELLOW INSPECTION COPY (INITIAL): PINK OWNER COPY (INITIAL): GOLD