IREDELL COUNTY HEALTH DEPARTMENT

Authorization to Construct

STATESVILLE 704-878-5305 MOORESVILLE 704-664-5281

IMPROVEMENT PERMIT / ~~CERTIFICATE OF COMPLETION~~ / OPERATION PERMIT / EXISTING SYSTEM INSPECTION

PROPERTY DESCRIPTION NO. 18985 DATE Oct 31, '94 (Sweeny Burdette) TAX MAP NO. part of 2CA3 Watershed: ☑ Yes ☐ No

OWNER OR CONTRACTOR Crescent Resources, Inc PHONE: Business Home 4626-40-8815 CN

ADDRESS PO Box 1003, Charlotte NC

LOCATION 1100 TR Bay Harbour Dr. TR (across from Beach tract) 1st lot on Rt 480

SUBDIVISION The Harbour BLOCK / SECTION ~~Hyde~~ LOT 73 LOT AREA 22,000 ft²+ SITE CLASS. PS per 1996 DESIGN FLOW ~~360 gpd~~ L.T.A.R. .3

Septic Tank: 1000 Gallons; STB 744 Date 2/23/96

Pump Tank: _____ Gallons; PT _____ Date _____

Pump Make: _____ Model _____ Serial No. 400

Nitrification Field: No. Fields 1 Square Feet 1600 Linear Feet ~~500~~

No. Lines X5 Trench Width 24" Max Trench Bottom Depth 28" Gravel Depth NA

☑ New System ☐ Repair System Type: I, II, III, IV, V, VI

System Description: gravity ~~PPBPS~~ INFILTRATOR

Repair System Description: Same

Maintenance Agreement Required: ☐ Yes ☑ No

☑ House/Mod. Home No. Bedrooms 4

☐ Duplex/Apt. No. Bathrooms 3

☐ Business No. Employees _____

☐ Other _____

☐ Slab ☑ Crawl Space ☐ Basement w/plumbing ☐ Basement wo/plumbing


Water Supply: ☐ Individual ☑ Community ☐ Public

Comments: Follow contour w/ laterals; Exit plumbing at a depth to accomodate specified trench bottom depth.

Comments: * 12/4/96 INFILTRATOR

PPBPS for 50% reduction in effluent

INITIAL SITE SKETCH

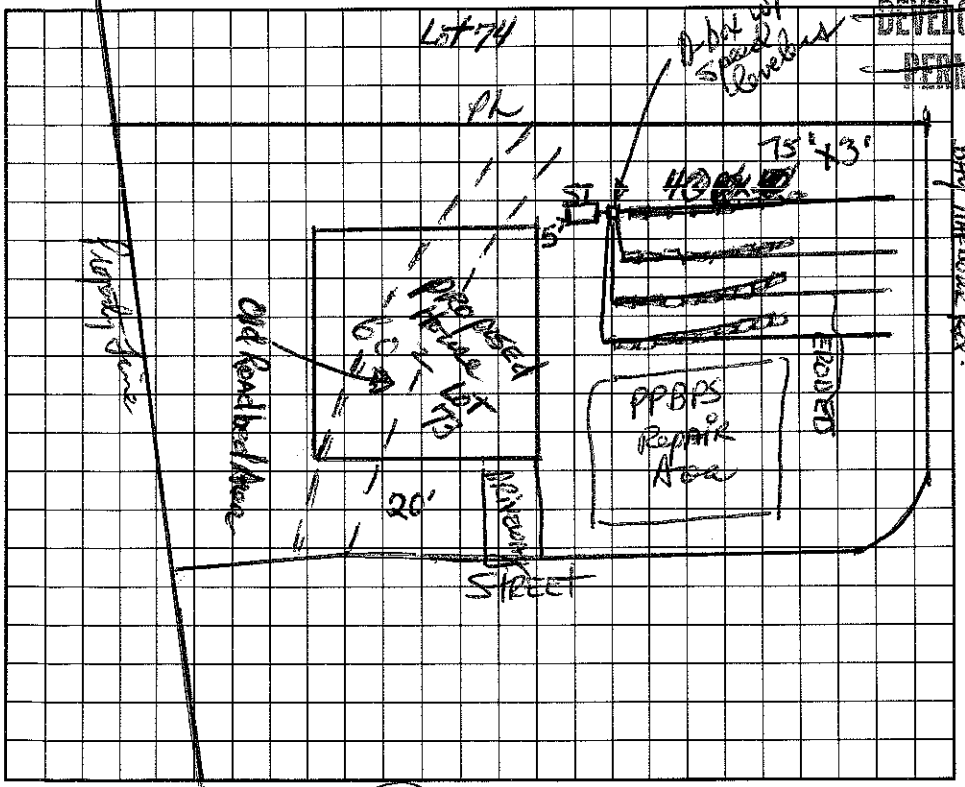

AS BUILT SKETCH

Authorization to Construct

I understand that this permit can be suspended or revoked if any false information is supplied toward securing the permit/any unauthorized changes are made to the site/any unauthorized changes are made in the installation of the system. Improvement Permit is valid for 60 months from date of issuance.

Signed: _____

Improvement Permit by: _____ RS date 10/31/94

Existing System Inspection by: Authorization to Construct Wesley Sparks RS date 11/30/95

Installed by: ~~Authorization to Construct~~ Co. Thompson Earthwork

Certificate of Completion by: Wesley Sparks RS. date 5/22/97

Operation Permit by: Wesley Sparks RS. date 5/22/97

HEALTH DEPT. COPY: WHITE INSPECTION COPY (FINAL): GREEN OWNER COPY (FINAL): YELLOW INSPECTION COPY (INITIAL): PINK OWNER COPY (INITIAL): GOLD