IREDELL COUNTY HEALTH DEPARTMENT

IMPROVEMENT PERMIT / ~~CERTIFICATE OF COMPLETION~~ / OPERATION PERMIT / EXISTING SYSTEM INSPECTION

Authorization to Construct

STATESVILLE 704-878-5305 MOORESVILLE 704-664-5281

PROPERTY DESCRIPTION NO. 18386 DATE Nov. 1, '94

OWNER OR CONTRACTOR Crescent Resources c/o Sandy Butler TAX MAP NO. part of 2CA3

ADDRESS PO Box 1003 Charlotte PHONE: Business ~~Home~~ 4626-40-8492 Cell Watershed: ☑ Yes ☐ No

LOCATION 1100 TR Bay Harbour Rd. on RT just before Beach Ferry Ct.

SUBDIVISION The Harbour BLOCK / SECTION 1 LOT 74 LOT AREA 22,000 ft²± SITE CLASS. PSpr 1956 DESIGN FLOW 360 gpd L.T.A.R. .25

Septic Tank: 1000 Gallons; STB 794 Date 6/27/96

Pump Tank: _____ Gallons; PT _____ Date _____

Pump Make: _____ Model _____ Serial No. _____

Nitrification Field: No Fields 1 Square Feet _____ Linear Feet ~~240~~ 320

No Lines 8 4 Trench Width 24" Max Trench Bottom Depth 30" Gravel Depth NA

☑ New System ☐ Repair System Type: I, II, III, IV, V, VI

System Description: gravity PPBPS

Repair System Description: SAME

Maintenance Agreement Required: ☐ Yes ☑ No

☑ House/Mod. Home ☐ Mobile Home ☐ Business ☐ Other

No. Bedrooms 3 No. Bathrooms 3 No. Employees ____

☐ Slab ☑ Crawl Space ☐ Basement w/plumbing ☐ Basement wo/plumbing


Water Supply: ☐ Individual ☑ Community ☐ Public

Comments: Laterals to follow contours.

Comments:

INITIAL SITE SKETCH

Authorization to Construct

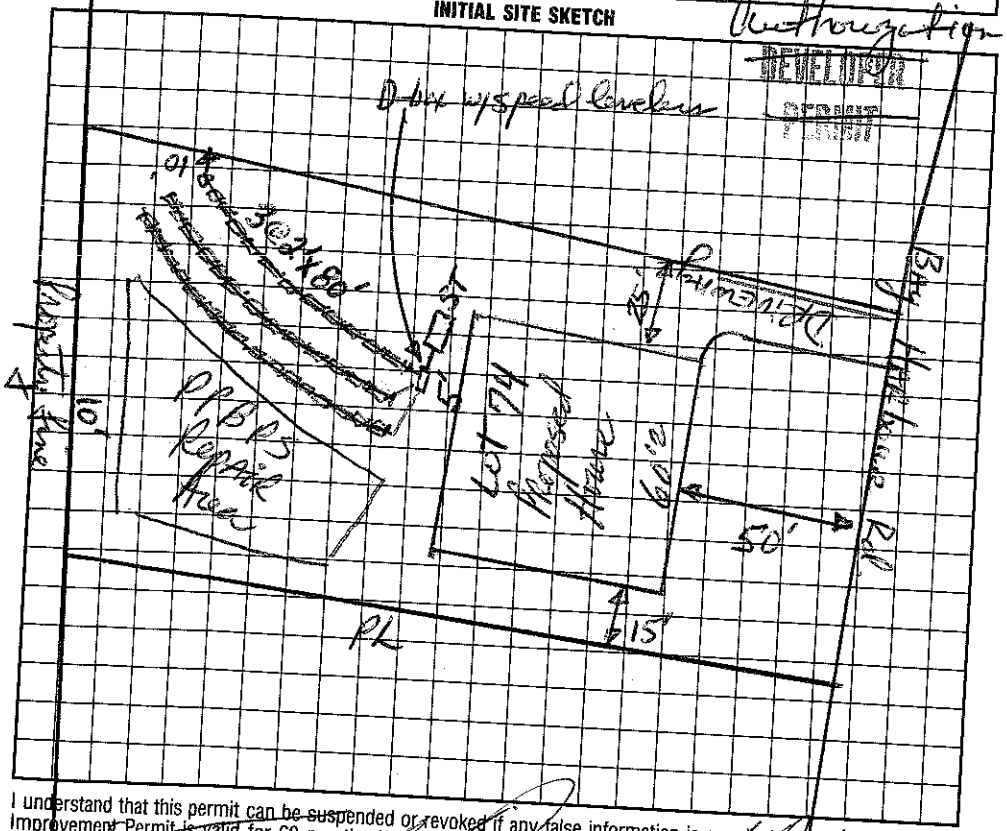

AS BUILT SKETCH

I understand that this permit can be suspended or revoked if any false information is supplied toward securing the permit/any unauthorized changes are made to the site/any unauthorized changes are made in the installation of the system. Improvement Permit is valid for 60 months from date of issuance.

Signed: _____ Approx 11/1/94

Improvement Permit by: _____ date 11/1/94

Existing System Inspection by: Wesley Sparks R.S. date 11/24/96

Installed by: Machine d Const.

Certificate of Completion by: _____ date _____

Operation Permit by: Wesley Sparks R.S. date 11/27/96

HEALTH DEPT. COPY: WHITE INSPECTION COPY (FINAL): GREEN OWNER COPY (FINAL): YELLOW INSPECTION COPY (INITIAL): PINK OWNER COPY (INITIAL): GOLD