IREDELL COUNTY HEALTH DEPARTMENT

Const. Auth. JEFF ODEN - STATESVILLE 704-878-5305 MOORESVILLE 704-664-5281

IMPROVEMENT PERMIT / ~~CERTIFICATE OF COMPLETION~~ / OPERATION PERMIT / EXISTING SYSTEM INSPECTION

PROPERTY DESCRIPTION NO. 23356 DATE June 5 '96 TAX MAP NO. ~~part of 2443~~ 4626411192 Watershed: ☑ Yes ☐ No

OWNER OR CONTRACTOR ~~Crescent Resources Inc~~ Sandy Burbank PHONE: Business _____ Home _____

ADDRESS PO Box 1003 Charlotte

LOCATION Brawley Sch Rd- TR Churchwood TL Morrow's Ridge Ln. TR Wild Iris Ln on Right at cul-d-sac

SUBDIVISION The Harbour BLOCK / SECTION III LOT 13 LOT AREA 20,000ft² + SITE CLASS. Spr. 1956 DESIGN FLOW 480gpd L.T.A.R. .3

Septic Tank: 1000 Gallons; STB 794 Date 11/6/96

Pump Tank: 1000 Gallons; PT 27 Date 12/29/98

Pump Make: HYDROMATIC Model SK. 60M1 Serial No. 12/98

Nitrification Field: No Fields 1 Square Feet 540 Linear Feet 270

No Lines 4 Trench Width 24" Max Trench Bottom Depth 30" Gravel Depth NA

☑ New System ☐ Repair System Type: I, II, III, IV, V, VI

System Description: 1P PPBS

Repair System Description: LPP

Maintenance Agreement Required: ☑ Yes ☐ No

☑ House/Mod. Home ☐ Mobile Home ☐ Business ☐ Other

No. Bedrooms 4 No. Bathrooms 4 No. Employees ____

☐ Slab ☑ Crawl Space ☐ Basement w/plumbing ☐ Basement wo/plumbing


Water Supply: ☐ Individual ☑ ~~Community~~ ☐ Public

Comments:


Comments:

1"=50'

INITIAL SITE SKETCH

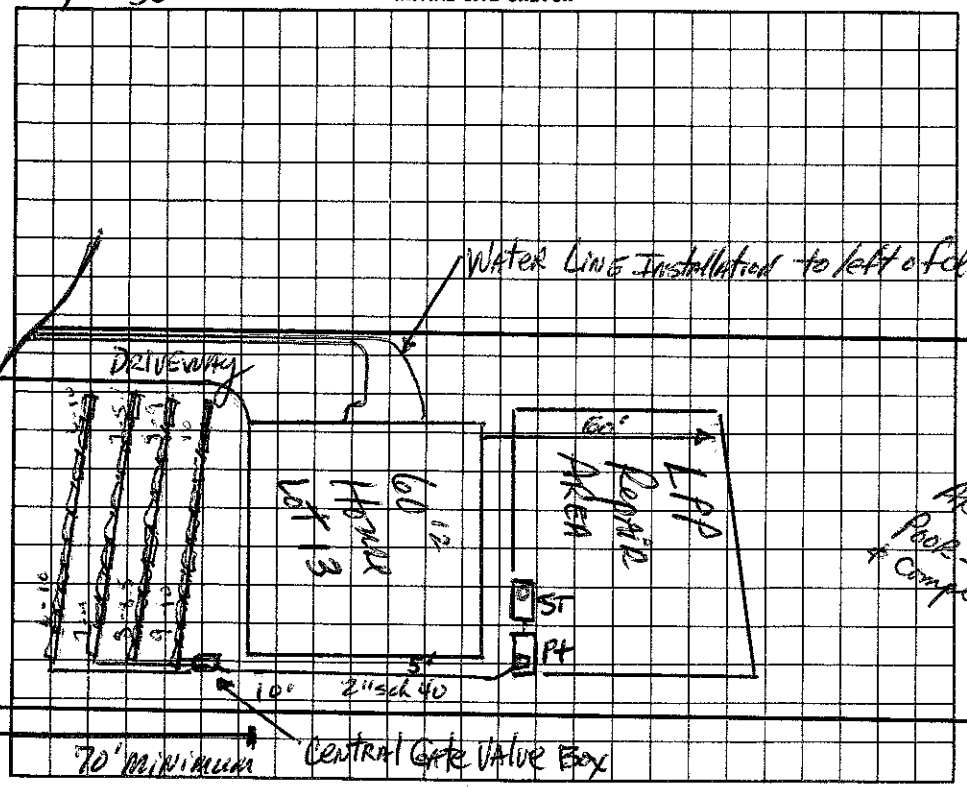

AS BUILT SKETCH

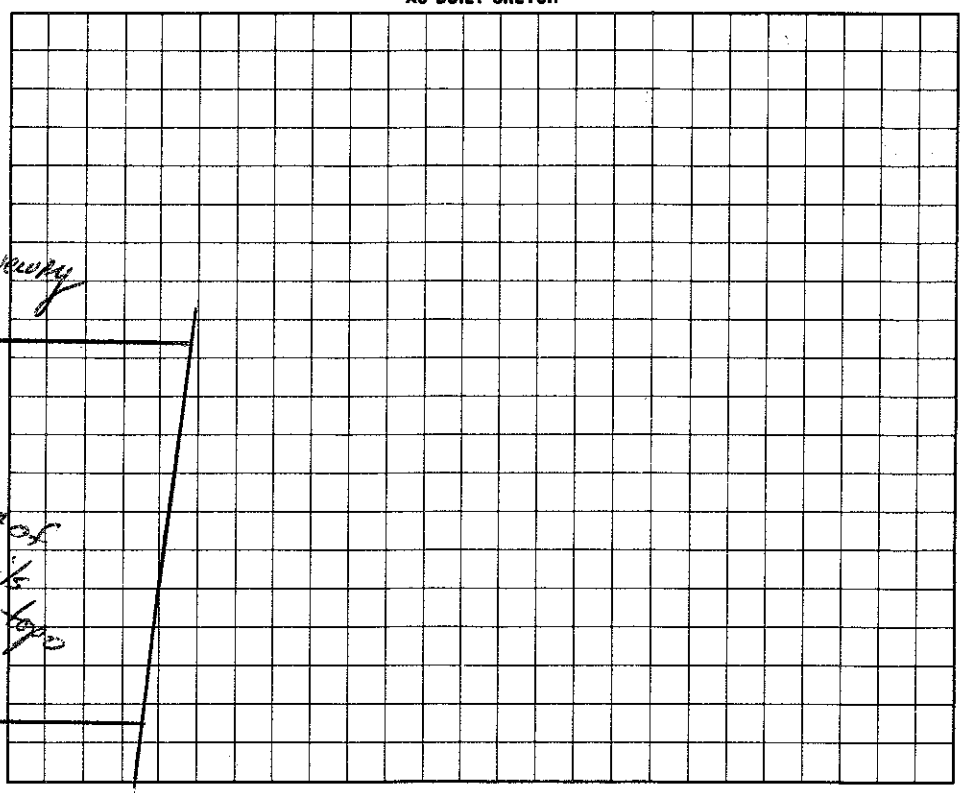

I understand that this permit can be suspended or revoked if any false information is supplied toward securing the permit/any unauthorized changes are made to the site/any unauthorized changes are made in the installation of the system.

Signed: _____

Improvement Permit by: Wesley Sparks RS date 6-5-96

Existing System Inspection by: Wesley Sparks RS. date 5/11/98

Installed by: Macleod Const. Co.

Certificate of Completion by: _____ date _____

Operation Permit by: Wesley Sparks RS. date 2/23/99

Construction Authorization

HEALTH DEPT. COPY: WHITE INSPECTION COPY (FINAL): GREEN OWNER COPY (FINAL): YELLOW INSPECTION COPY (INITIAL): PINK OWNER COPY (INITIAL): GOLD