IREDELL COUNTY HEALTH DEPARTMENT Const. Auth. STATESVILLE 704-878-5305 MOORESVILLE 704-664-5281

IMPROVEMENT PERMIT / ~~CERTIFICATE OF COMPLETION~~ / OPERATION PERMIT / EXISTING SYSTEM INSPECTION

PROPERTY DESCRIPTION NO. 23355 DATE June 4, 196 TAX MAP NO: ~~Part~~ 1 of 2CA3 4626412192 Watershed: ~~☑~~ Yes ☐ No

OWNER OR CONTRACTOR ~~Gradient Resources~~ Sandy Builders PHONE: Business / Home

ADDRESS PO Box 1003 Charlotte

LOCATION Brawley Sch Rd. TR Chuckwood TL Morrow's Ridge Ln. TR Wild Iris Ln. on Right

SUBDIVISION The Harbour BLOCK / SECTION III LOT 12 LOT AREA 20,000 ft²± SITE CLASS. PSpm.195 DESIGN FLOW 480gpd L.T.A.R. .3

Septic Tank: 1000 Gallons; STB 794 Date 11/2/97
Pump Tank: 1000 Gallons; PT 29 Date 11/17/97
Pump Make: Model Serial No.
Nitrification Field: No. Fields 1 Square Feet 540 Linear Feet 270
No Lines 5 Trench Width 24" Max Trench Bottom Depth 30" Gravel Depth NA

☑ New System ☐ Repair System Type: I. II. III. IV. V. VI
System Description: LPP PPBRS
Repair System Description: LPP
Maintenance Agreement Required: ☑ Yes ☐ No

☑ House/Mod. Home No. Bedrooms 4/4
☐ Mobile Home No. Bathrooms 4
☐ Business No. Employees
☐ Other
☐ Slab ☑ Crawl Space ☐ Basement w/plumbing ☐ Basement wo/plumbing


Water Supply:
☐ Individual
☑ Community
☐ Public

Comments:


Comments: 5/15/97 Drainfield and Tanks approved - AWS.
Metal Gate Valve in tank - metal gates on each drain lines -

1" = 50'

INITIAL SITE SKETCH

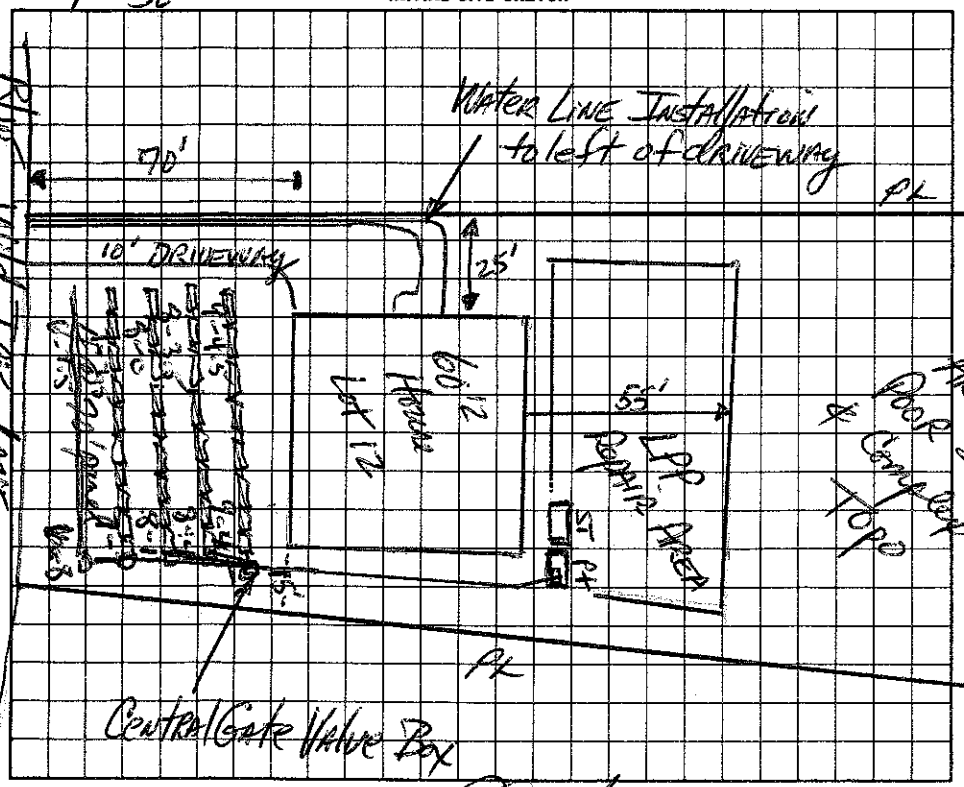

AS BUILT SKETCH

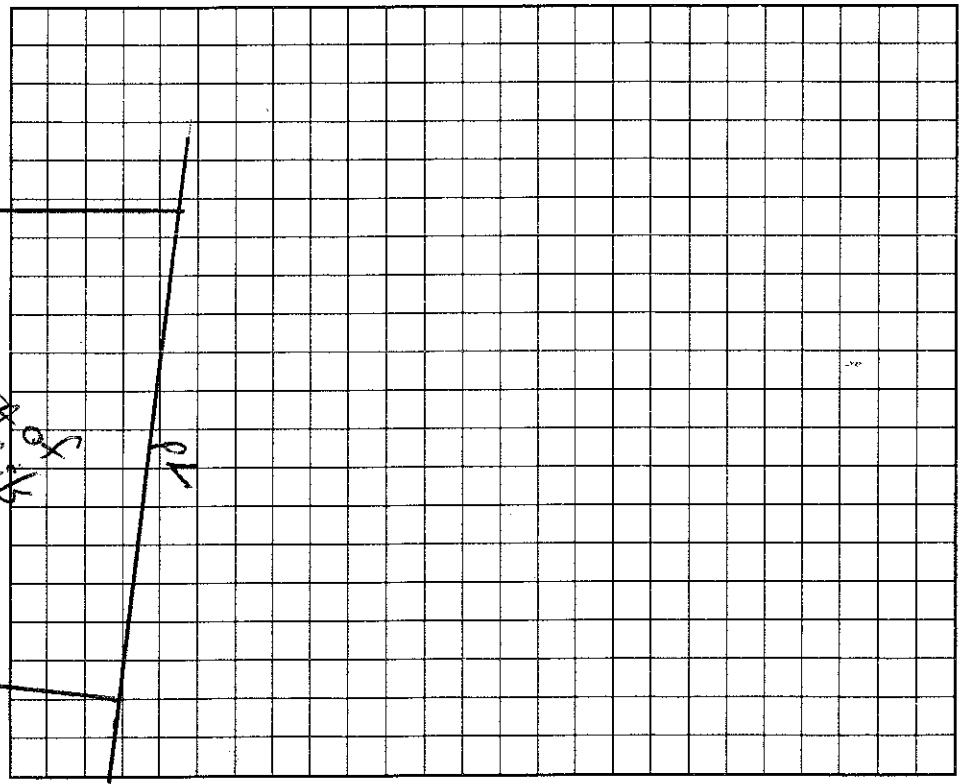

I understand that this permit can be suspended or revoked if any false information is supplied toward securing the permit/any unauthorized changes are made to the site/any unauthorized changes are made in the installation of the system.

Signed: ~~X~~ Thomas Sandy, CBS

Improvement Permit by: Hoke Livingston RS date 6-4-96

Construction Existing System Inspection by: Wesley Sparks R.S. date 11/12/96

Authorization

Installed by: MacLeod Const Co.

Certificate of Completion by: Wesley Sparks RS date 6/20/97

Operation Permit by: Wesley Sparks R.S. date 6/20/97

HEALTH DEPT. COPY: WHITE INSPECTION COPY (FINAL): GREEN OWNER COPY (FINAL): YELLOW INSPECTION COPY (INITIAL): PINK OWNER COPY (INITIAL): GOLD