IREDELL COUNTY HEALTH DEPARTMENT

Statesville Office (704) 878-5305 Mooresville Office (704) 660-3625 PERMIT # 202243

IMPROVEMENT PERMIT / AUTHORIZATION TO CONSTRUCT / OPERATION PERMIT / EXISTING SYSTEM

PIN # 4626-41-2400

APPLICANT: LAKE LUXURY Homes APPLICANT ADDRESS: PO Box 3792 Mooresville NC 28117

SITE ADDRESS: 271 Chuckwood Rd PHONE: 828-478-2761 ALT. PHONE:

SITE DIRECTIONS: Brawley Sch Rd TR on Chuckwood, Lot on L before Barber Lp

SUBDIVISION: Heron View SECTION: LOT # 1 LOT AREA: 1.09 ac DESIGN FLOW: 480 gpd L.T.A.R.: 0.275

Septic Tank	1000	(gal)	STB	825	Date	11-28-14	☑ New System	☐ Repair	☐ Expansion	System Type: I II (III) IV V VI	☑ Residence	No. Bedrooms	4	Water Supply	
Pump Tank	1000	(gal)	PT	502	Date	11-14-14	System Description:	PM 25% Reduction			☐ Business	No. Persons	8	☑ Private	
Pump Make	ZOELLER	Model	N152		Serial #		Repair System Description:	Drip Irrigation			☐ Other	No. Employees		☐ Public	
# Nitrification Fields	1	# Lines	6		Linear Ft:	445	Maintenance Agreement Required:	☐ YES	☑ NO		☐ Slab	☐ Crawl Space		☐ Community	
Trench Width	36"	Max. Trench Bottom Depth	26"		Gravel Depth	N/A		☐ GRAVITY	☑ PRESSURE		☑ Basement w/plumbing		☐ Basement w/o plumbing		

Comments / Conditions: *Trench Bottom 26" per plan Specs

INITIAL SITE SKETCH

SEE DESIGN BY ROLLANS SOIL & ENVIRONMENTAL SERVICES

AS BUILT SKETCH

1/2" SCH 80 TAPS

CHECKED LINES
TANKS
PM
SET 2' HEAD
BA
APPROVED JAN 30 2015

Permit can be suspended or revoked if any false information is supplied toward securing the permit / any unauthorized changes are made to the site / any unauthorized changes are made in the installation of the system. **CONTACT A LOCATOR SERVICE PRIOR TO ANY EXCAVATION**

☐ **IMPROVEMENT PERMIT** *with plat valid without expiration.* ☑ **IMPROVEMENT PERMIT** *with site plan valid for 60 mos.* ☑ **AUTHORIZATION TO CONSTRUCT** *valid for period equal to IMPROVEMENT PERMIT--not to exceed 60 mo.*

Owner / Applicant Signature: George B Mosier Date: 5/28/14

IMPROVEMENT PERMIT by: Date: 5-28-14


AUTHORIZATION TO CONSTRUCT by: Date: 5-29-14

Installed by: Rowan Septic APPROVED FEB 19 2015

OPERATION PERMIT by: Date:

Existing System Inspected by: Date:

Health Dept. Copy - WHITE Applicant (Final Approval) - YELLOW Applicant (Conditional Approval) - PINK

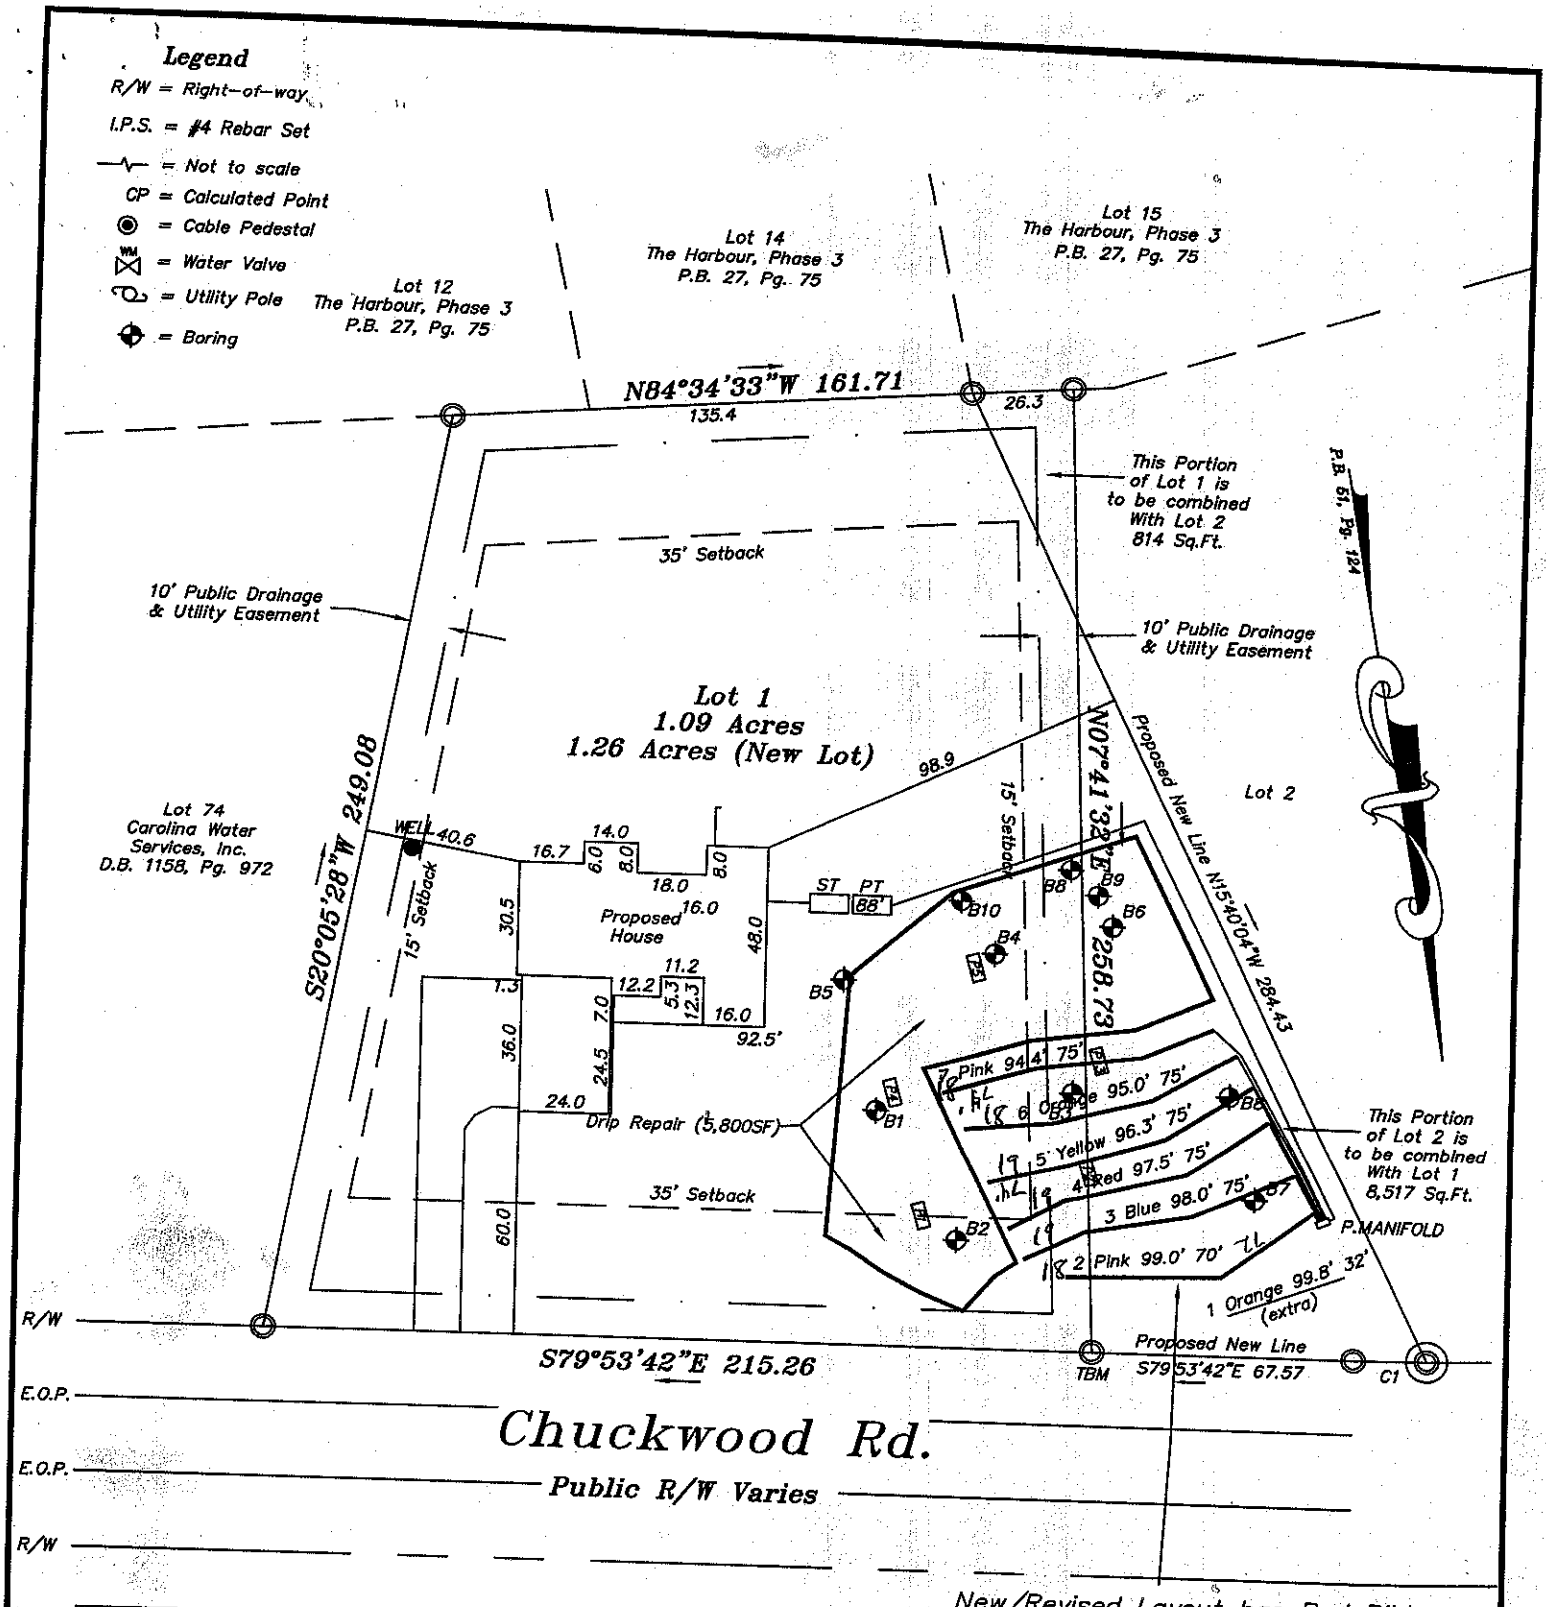

CURVE TABLE				
CURVE	LENGTH	RADIUS	BEARING	CHORD
C1	18.98	816.95	N80°33'38"W	18.98

New/Revised Layout has Red Ribbon tied to each colored pin flag.

APPROVED MAY 28 2014

APPROVED MAY 28 2014

ALP

Notes:

1) This property may be subject to any Easements, Rights-of-way, and/or Restrictive Covenants.
2) Boundary information based on Plat Book: 51 at Page: 124 as recorded in the Iredell County Register of Deeds.
3) This survey is of an existing parcel or parcels of land.
4) No N.C.G.S. or U.S.G.S. Monuments could be located within 2000'.
5) Area by coordinate method.

GRAPHIC SCALE

50 0 25 50 100

(IN FEET)

1 inch = 50 ft