IREDELL COUNTY HEALTH DEPARTMENT

Authorization to Construct

STATESVILLE 704-878-5305 MOORESVILLE 704-664-5281

IMPROVEMENT PERMIT / ~~CERTIFICATE OF COMPLETION~~ / OPERATION PERMIT / EXISTING SYSTEM INSPECTION

PROPERTY DESCRIPTION NO. 23354 DATE Jun. 27, 1997 TAX MAP NO. ~~Part of~~ 2C43 4626414 100 Watershed: X Yes ☐ No

OWNER OR CONTRACTOR Sunny Burbank PHONE: Business 663 6905 Home

ADDRESS PO Box 10013 Charlotte, NC 28201

LOCATION Brawley Sch. Rd. TR Chuckwood TL Moscow Ridge Ln. TR Wildchris Ln., 3rd on (R)

SUBDIVISION Hudson BLOCK / SECTION III LOT 11 LOT AREA 20,000 FT² SITE CLASS. PS ~~Perc Soils~~ DESIGN FLOW 360 L.T.A.R. .3

Septic Tank: 1000 Gallons; STB 794 Date 9/4/97

Pump Tank: 1000 Gallons; PT 27 Date 10/26/97

Pump Make: HYDROMATIC Model SHEFSCAN Serial No. 8-97

Nitrification Field: No Fields 1 Square Feet *400 Linear Feet *200

No Lines @4 Trench Width 24" Max Trench Bottom Depth 30" Gravel Depth SAND

X New System ☐ Repair System Type: I, II, III, (IV) V, VI

System Description: Pres - 16" PPBS

Repair System Description: SAME

Maintenance Agreement Required: X Yes ☐ No

X House/Mod. Home No. Bedrooms 3

☐ Mobile Home No. Bathrooms 3

☐ Business No. Employees

☐ Other


☐ Slab X Crawl Space ☐ Basement w/plumbing ☐ Basement wo/plumbing

Water Supply:
☐ Individual
X Community
☐ Public


Comments: * 50% reduction for 16" PPBS use

Comments: 20% 48 5.4" drawdown; 200 3.6; 52 3 46 138 6.18 165.6

INITIAL SITE SKETCH

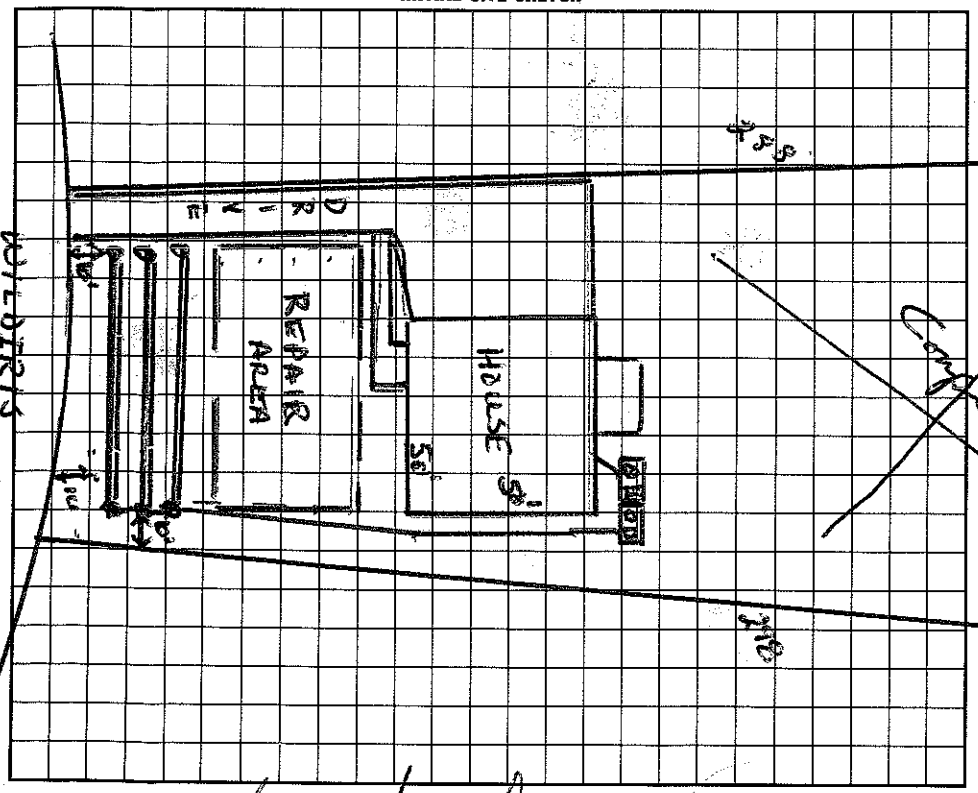

AS-BUILT SKETCH

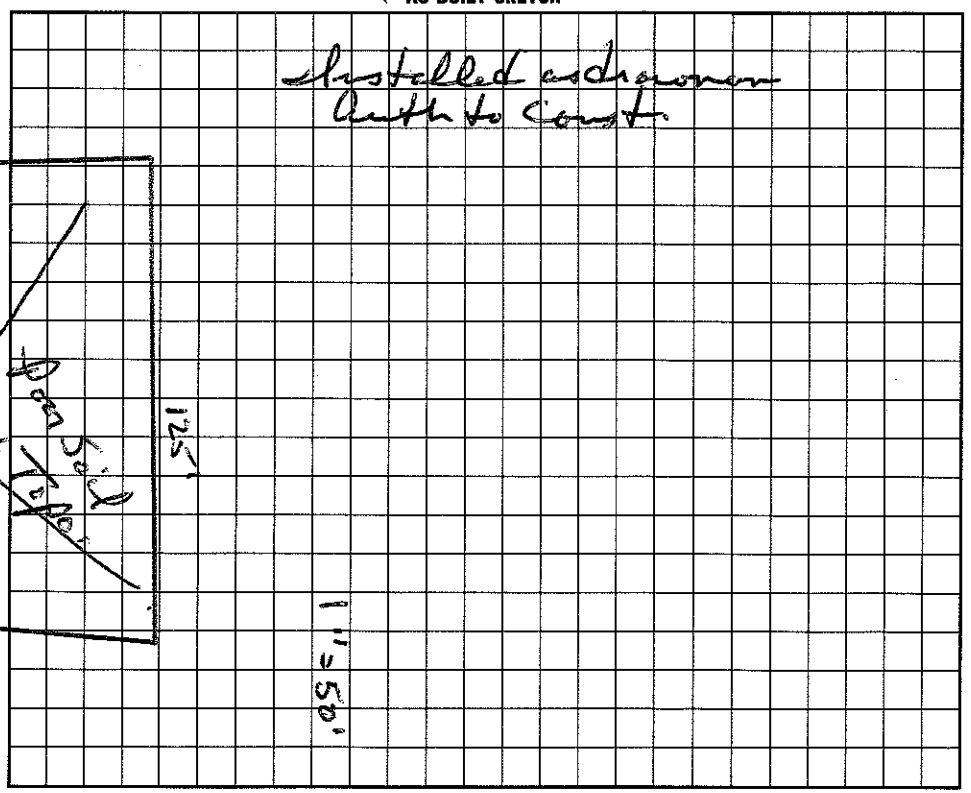

I understand that this permit can be suspended or revoked if any false information is supplied toward securing the permit/any unauthorized changes are made to the site/any unauthorized changes are made in the installation of the system. Improvement Permit is valid for 60 months from date of issuance.

Signed: *

Improvement Permit by: Wesley Sparks RS. date 6/27/97

Existing System Inspection by: Wesley Sparks RS. date 6/27/97

Installed by: Macneal Const.

Certificate of Completion by: Wesley Sparks RS. date 1/15/98

Operation Permit by: Wesley Sparks RS. date 1/15/98

HEALTH DEPT. COPY: WHITE INSPECTION COPY (FINAL): GREEN OWNER COPY (FINAL): YELLOW INSPECTION COPY (INITIAL): PINK OWNER COPY (INITIAL): GOLD