IREDELL COUNTY HEALTH DEPARTMENT Const. Auth. STATESVILLE 704-878-5305 MOORESVILLE 704-664-5281

IMPROVEMENT PERMIT / ~~CERTIFICATE OF COMPLETION~~ / OPERATION PERMIT / EXISTING SYSTEM INSPECTION

PROPERTY DESCRIPTION NO. 23352 DATE June 4, 1996 TAX MAP NO. part of 2CA3 4626 41 6010 Watershed: ☑ Yes ☐ No

OWNER OR CONTRACTOR ~~Crescent Resources Corp~~ SAMUEL BURBANK PHONE: Business _____ Home _____

ADDRESS PO Box 1003 Charlotte

LOCATION Byerley Sch Rd TR Chesterwood TL Morrow Ridge Lane on Right

SUBDIVISION The Harbour BLOCK / SECTION III LOT 9 LOT AREA 20,000 ft²± SITE CLASS. B per 1958 DESIGN FLOW 360 gpd L.T.A.R. .3

Septic Tank: 1000 Gallons; STB 794 Date 8-26-98

Pump Tank: 1000 Gallons; PT 27 Date 10/6-98

Pump Make: HYDROMATIC Model SHEF 50A Serial No. 10198

Nitrification Field: No Fields 1 Square Feet 900 Linear Feet 300

No Lines 4@75' Trench Width 36" Max Trench Bottom Depth 30" Gravel Depth N/A

☑ New System ☐ Repair System Type: I. II (III) IV. V. VI

System Description: pumped-pon-chambered

Repair System Description: LPP

Maintenance Agreement Required: ☐ Yes ☑ No initially

☑ House/Mod. Home No. Bedrooms 3

☐ Mobile Home No. Bathrooms 3

☐ Business No. Employees _____

☐ Other _____

☐ Slab ☑ Crawl Space ☐ Basement w/plumbing ☐ Basement wo/plumbing


Water Supply:
☐ Individual
☑ Community
☐ Public

Comments:

Comments:

1"=50'

INITIAL SITE SKETCH

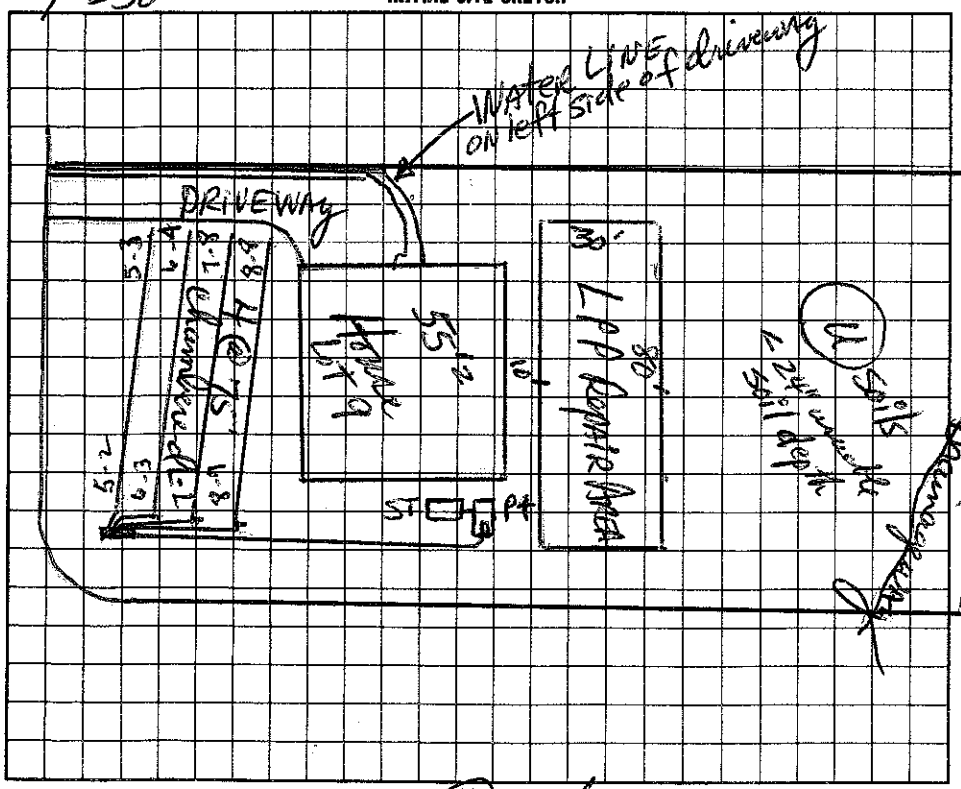

AS BUILT SKETCH

I understand that this permit can be suspended or revoked if any false information is supplied toward securing the permit/any unauthorized changes are made to the site/any unauthorized changes are made in the installation of the system.

Signed: _____

Improvement Permit by: _____ date 6-4-96

Existing System Inspection by: _____ date 6/9/98

Installed by: MacLeod Const.

Certificate of Completion by: _____ date _____

Operation Permit by: Wesley Sparks R.S. date 11/30/98

Authorization to Construction

REVIEW DEPT. COPY: WHITE INSPECTION COPY (FINAL): GREEN OWNER COPY (FINAL): YELLOW INSPECTION COPY (INITIAL): PINK OWNER COPY (INITIAL): GOLD