200

IREDELL COUNTY HEALTH DEPARTMENT Court Auth. STATESVILLE 704-878-5305 MOORESVILLE 704-664-5281

IMPROVEMENT PERMIT / ~~CERTIFICATE OF COMPLETION~~ / OPERATION PERMIT / EXISTING SYSTEM INSPECTION

PROPERTY DESCRIPTION NO. 23357 DATE August 12, '97 TAX MAP NO. part of 2C43 Watershed: ☑ Yes ☐ No

OWNER OR CONTRACTOR ~~Crescent Resources Inc~~ Sandy Burbank PHONE: Business _____ Home _____

ADDRESS PO Box 1003, Charlotte

LOCATION Brawley Sch Rd: TR Chuckwood TL Morrow's Ridge immediately on Right

SUBDIVISION The Harbour BLOCK / SECTION 3 LOT 8 LOT AREA 1.5 ac SITE CLASS. PS 1 DESIGN FLOW ~~360gpd~~ L.T.A.R. ~.12

Septic Tank: 1000 Gallons; STB 744 Date 12/23/97

Pump Tank: 1000 Gallons; PT 27 Date 2/14/98

Pump Make: Hydromatic Model 3HEF50 Serial No. _____

Nitrification Field: No Fields 3 Square Feet 3000 Linear Feet 606

No Lines 17 Trench Width 18" Max Trench Bottom Depth 12" Gravel Depth ~8"

☑ New System ☐ Repair System Type: I, II, III, IV, V, VI

System Description: LPP

Repair System Description: LPP Pump/Tank on BA

Maintenance Agreement Required: ☑ Yes ☐ No

☑ House/Mod. Home No. Bedrooms 3

☐ Mobile Home No. Bathrooms 3

☐ Business No. Employees _____

☐ Other _____


☐ Slab ☑ Crawl Space ☐ Basement w/plumbing ☐ Basement wo/plumbing

Water Supply: ☐ Individual ☑ Community ☐ Public


Comments:

Comments: 1/25/99 - FAXED TO TRI COUNTY Waste Water - WS.

INITIAL SITE SKETCH

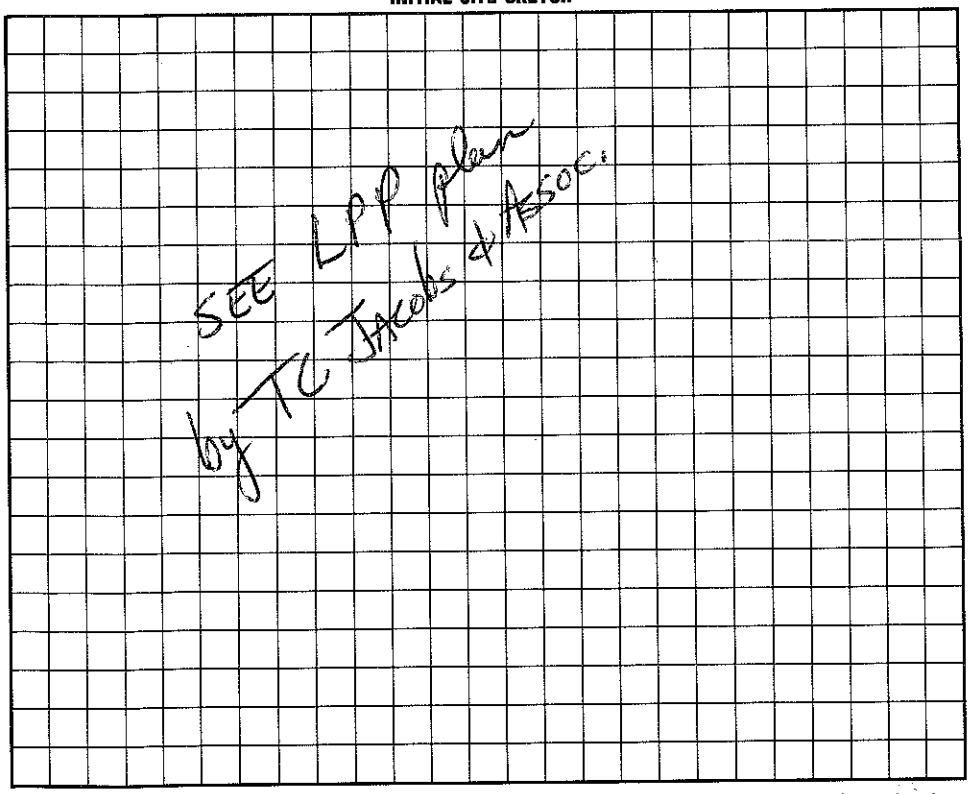

AS BUILT SKETCH

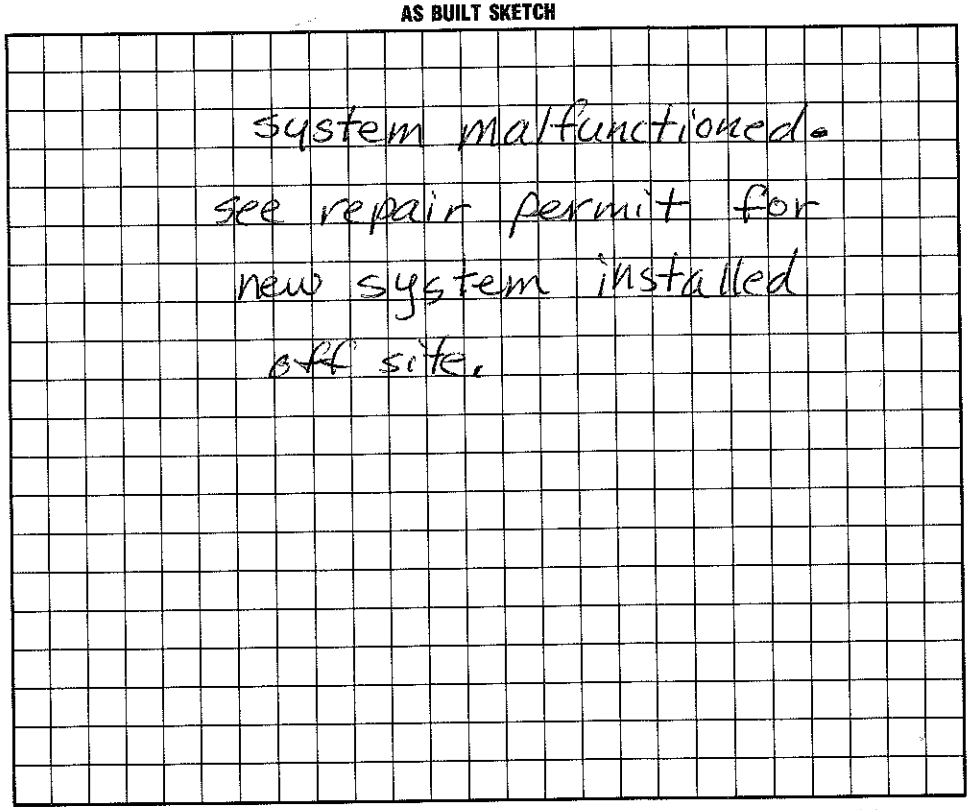

I understand that this permit can be suspended or revoked if any false information is supplied toward securing the permit/any unauthorized changes are made to the site/any unauthorized changes are made in the installation of the system. Improvement Permit is valid for 60 months from date of issuance.

Signed: ~~X~~ Sandy Burbank, agent 8/18/97

Improvement Permit by: D. Harmon, RS date 8-18-97

~~Construction~~ ~~Existing System~~ Inspection by: Wesley Sparks RS. date 8/17/98

Authorization for

Installed by: McLeod

Certificate of Completion by: _____ date _____

Operation Permit by: C. Mc RS date 4/5/99

HEALTH DEPT. COPY: WHITE INSPECTION COPY (FINAL): GREEN OWNER COPY (FINAL): YELLOW INSPECTION COPY (INITIAL): PINK OWNER COPY (INITIAL): GOLD