IREDELL COUNTY HEALTH DEPARTMENT

STATESVILLE 704-878-5305 150.00 Paid MOORESVILLE 704-664-5281

IMPROVEMENT PERMIT / AUTHORIZATION TO CONSTRUCT / OPERATION PERMIT / EXISTING SYSTEM INSPECTION

PERMIT# 11477420 PIN# 4626 41 8479.000 DATE 11/29/05

OWNER OR APPLICANT Kelly Building & Dev. Corp. PHONE: Business 704-664-9222 Home

ADDRESS PO Box 3081 Mooresville, NC. 28117

LOCATION 1100 TR, Chuckwood, Past Seagrove on (R) just B4 Monaws Ridge on (L)

SUBDIVISION Holiday Harbor BLOCK / SECTION LOT 80 LOT AREA .48 Ac SITE CLASS. PS DESIGN FLOW 480 L.T.A.R. .3

Septic Tank: 1000 Gallons; STB 794 Date 11-6-05
Pump Tank: Gallons; PT Date
Pump Make: Model Serial No.
Nitrification Field: No Fields 1 Square Feet 1200 Linear Feet 400
No Lines 5@80' Trench Width 3' Max Trench Bottom Depth 3'

[X] New System [ ] Repair [ ] Expansion System Type: I II III IV V VI
System Description: DIST BOX → 25% REDUCED
Repair System Description: <83 LOT / SOME 16" PPBX
Maintenance Agreement Required: [ ] Yes [X] No

[X] House/Mod. Home No. Bedrooms 4
[ ] Mobile Home No. Persons 4
[ ] Business No. Employees
[ ] Other


Water Supply: [X] Individual [ ] Public [ ] Community NEW

Gravel Depth NA [ ] Gravity [ ] Pressure [ ] Slab [X] Crawl Space [ ] Basement w/plumbing [ ] Basement wo/plumbing


Comments:/Conditions:

Comments:/Conditions: Trenches 36"+ N 54 to PL

(1"=30') INITIAL SITE SKETCH

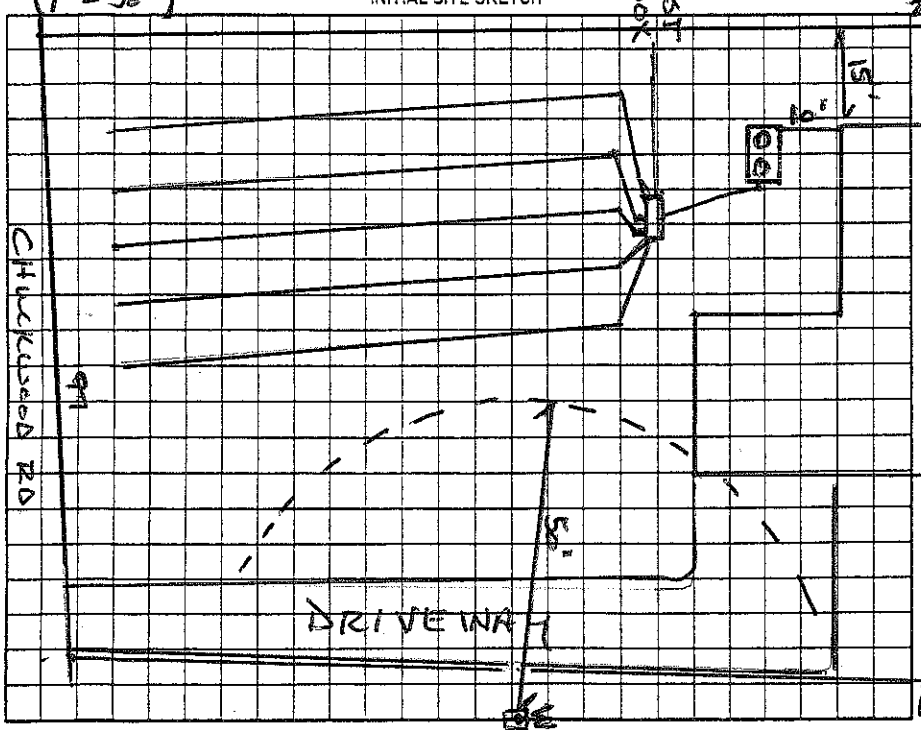

AS BUILT SKETCH

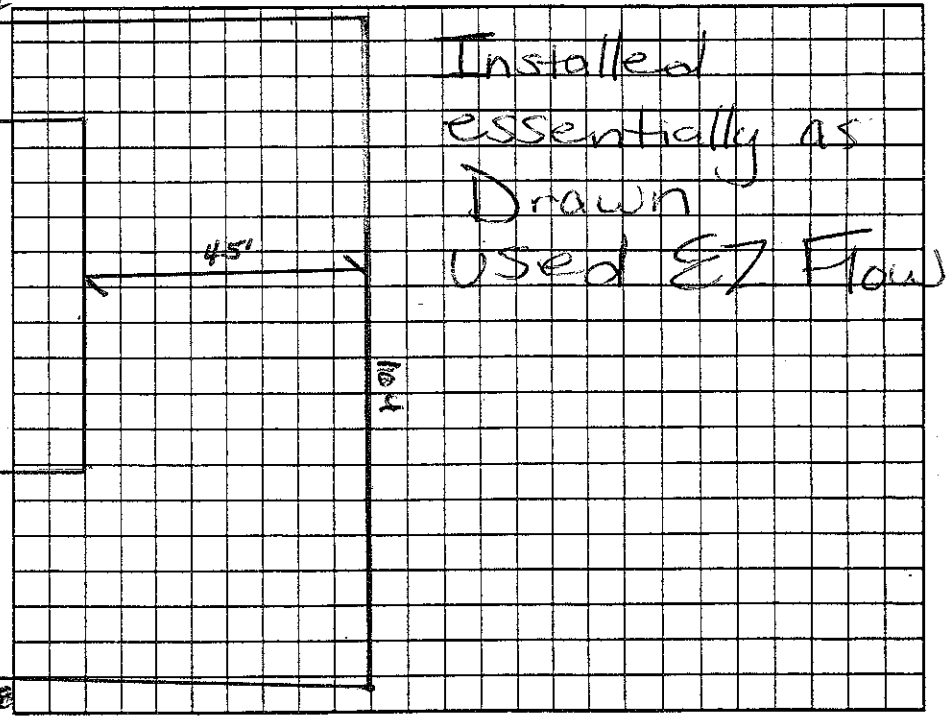

Installed essentially as Drawn Used E/1 Flow

Permit can be suspended or revoked if any false information is supplied toward securing the permit/any unauthorized changes are made to the site/any unauthorized changes are made in the installation of the system. Improvement Permit with plat valid without expiration. [ ] Improvement Permit with site plan valid for sixty months [ ] Authorization to Construct is valid for a period equal to that of Improvement Permit – not to exceed sixty months.

Signed: x Frances M Kelly date 12/2/05 Installed by: R&H RS

Improvement Permit by: Wesley Sparks RS date 11/29/05 Operation Permit by: Marvin H Dotson RS date 3/3/06

Authorization to Construct by: Wesley Sparks RS date 11/29/05 Existing System Inspection by date

HEALTH DEPT. COPY: WHITE OWNER COPY (FINAL): YELLOW OWNER COPY (INITIAL): PINK