IREDELL COUNTY HEALTH DEPARTMENT

STATESVILLE 704-878-5305 MOORESVILLE 704-664-5281

IMPROVEMENT PERMIT / AUTHORIZATION TO CONSTRUCT / OPERATION PERMIT / EXISTING SYSTEM INSPECTION

PERMIT# 07617 2 PIN# 4626 41 9272 DATE 8/20/98

OWNER OR CONTRACTOR Sunny Burbank PHONE: Business 945-1515 Home

ADDRESS 887 Sharon Amity Charlotte, NC. 28211

LOCATION Monows Ridge Rd. - Brawley School Rd. TR Chickwood Rd. TL Monows Ridge Rd., 1st on (L)

SUBDIVISION Harbour BLOCK / SECTION 3 LOT 1 LOT AREA .88 AC SITE CLASS. PS DESIGN FLOW 480 L.T.A.R. .3

Septic Tank: 1000 Gallons; STB 794 Date 1/29/99
Pump Tank: 1000 Gallons; PT 27 Date 3/5/99
Pump Make: Model Serial No.
Nitrification Field: No Fields 1 Square Feet 1200* Linear Feet 400*
No Lines 4 Trench Width 36" Max Trench Bottom Depth 36" Gravel Depth SAND

☒ New System ☐ Repair System Type: I, II, (III), IV, V, VI,
System Description: PresMan → CH Plastic
Repair System Description: Same
Maintenance Agreement Required: ☒ Yes ☐ No


☒ House/Mod. Home No. Bedrooms 4
☐ Mobile Home No. Bathrooms 3
☐ Business No. Employees
☐ Other
☐ Slab ☒ Crawl Space ☐ Basement w/plumbing ☐ Basement wo/plumbing

Water Supply:
☐ Individual
☐ Public
☒ Community

Comments:/Conditions:

Comments:/Conditions:

INITIAL SITE SKETCH

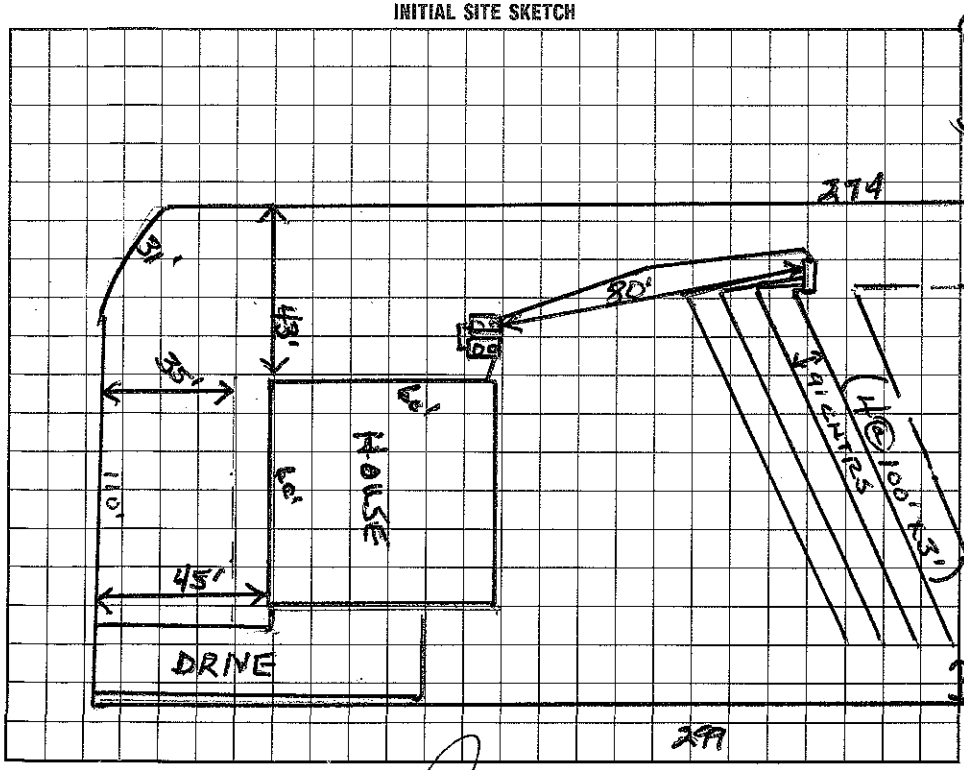

AS BUILT SKETCH

I understand that this permit can be suspended or revoked if any false information is supplied toward securing the permit/any unauthorized changes are made to the site/any unauthorized changes are made in the installation of the system. Improvement Permit with plat valid without expiration. Improvement Permit with site plan valid for sixty months. Authorization to Construct is valid for a period equal to that of Improvement Permit – not to exceed sixty months.

Signed: * date 8/25/98 Installed by: Macwood Const.

Improvement Permit by: Wesley Sparks R.S. date 8/20/98 Operation Permit by: Wesley Sparks R.S. date 4/15/99

Authorization to Construct by: Wesley Sparks R.S. date 8/20/98 Existing System Inspection by: date

HEALTH DEPT. COPY: WHITE INSPECTION COPY (FINAL): GREEN OWNER COPY (FINAL): YELLOW INSPECTION COPY (INITIAL): PINK OWNER COPY (INITIAL): GOLD