IREDELL COUNTY HEALTH DEPARTMENT

STATESVILLE 704-878-5305 MOORESVILLE 704-664-5281

IMPROVEMENT PERMIT / CERTIFICATE OF COMPLETION / OPERATION PERMIT / EXISTING SYSTEM INSPECTION

PROPERTY DESCRIPTION NO. 16635 DATE July 12, 93 TAX MAP NO. 2F64K5

OWNER OR CONTRACTOR Kayzad & Robyn Pirsa PHONE: Business 4626-42-1504 Home

ADDRESS 7435 Parkgate Dr. Charlotte NC 28215

LOCATION 1100 TR 1177 TR Seagrove TL Lakeland on left just past Riviera Dr.

SUBDIVISION Holiday Harbor BLOCK / SECTION LOT 45 LOT AREA 1.56 ac. SITE CLASS P5 L.T.A.R. .35 gal/ft²/day

Water Supply: ☑ Individual ☐ Community ☐ Public ACP-GCS

Septic Tank: 1000 Gallons; STB 782 Date 10-18-93

Pump Tank: _____ Gallons; PT _____ Date

Nitrification Field: No. Fields 1 Square Feet 1050 Linear Feet 350

No. Lines 5 Trench Width 36" Trench Depth 24"-30" Gravel Depth 12"

☑ New System ☐ Repair System Type: I, II, III, IV, V, VI

System Description: gravity conventional

Repair System Description: _____

Maintenance Agreement Required: ☐ Yes ☐ No

☑ House/Mod. Home No. Bedrooms 3

☐ Mobile Home No. Bathrooms 2½

☐ Business No. Employees _____

☐ Other _____

☐ Slab ☑ Crawl Space ☐ Basement w/plumbing ☐ Basement wo/plumbing

Garbage Disposal: ☐ Yes ☑ No


Auto. Dishwasher: ☑ Yes ☐ No

Auto. Washing Machine: ☑ Yes ☐ No

Other _____

Comments Well not installed as of this date 3/31/94

INITIAL SITE SKETCH

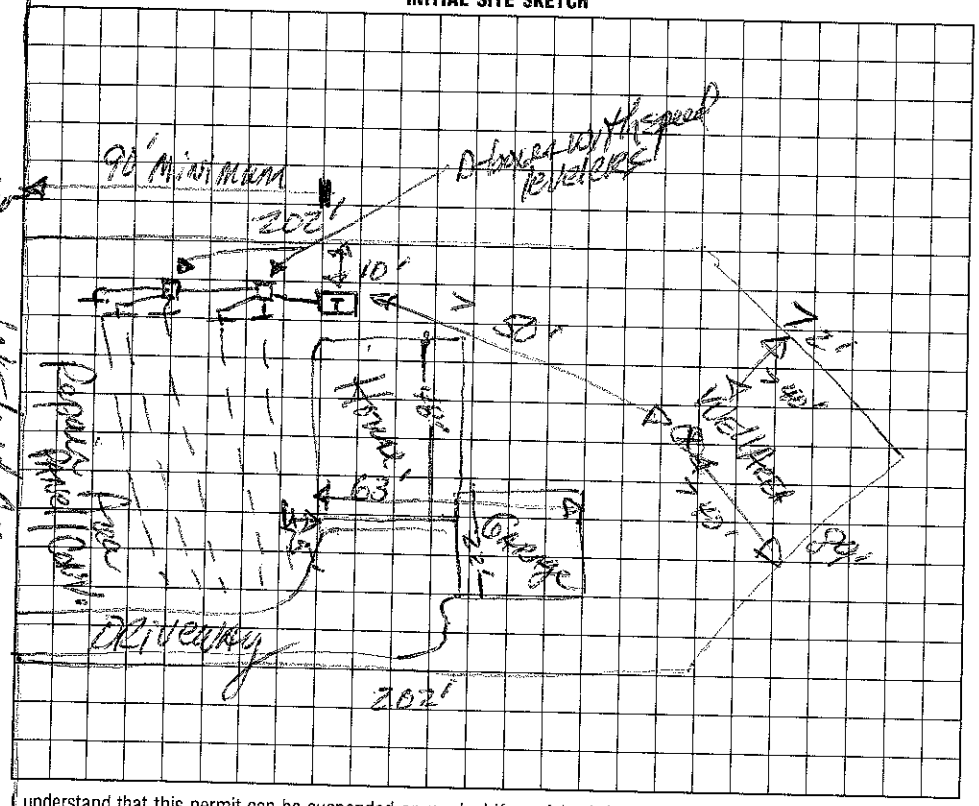

AS BUILT SKETCH

Substantially as shown on initial sketch

I understand that this permit can be suspended or revoked if any false information is supplied toward securing the permit/any unauthorized changes are made to the site/any unauthorized changes are made in the installation of the system. Improvement Permit is valid for 60 months from date of issuance.

Signed: Kayzad Pirsa

Improvement Permit by: Patrick R. Hanson RS date 7/12/93

Existing System Inspection by: _____ date _____

Installed by: Donald Lackey

Certificate of Completion by: Patrick R. Hanson date 3/31/94

Operation Permit by: _____ date _____

HEALTH DEPT. COPY: WHITE INSPECTION COPY (FINAL): GREEN OWNER COPY (FINAL): YELLOW INSPECTION COPY (INITIAL): PINK OWNER COPY (INITIAL): GOLD