IREDELL COUNTY HEALTH DEPARTMENT

STATESVILLE 704-878-5305 MOORESVILLE 704-664-5281

IMPROVEMENT PERMIT / CERTIFICATE OF COMPLETION / OPERATION PERMIT / EXISTING SYSTEM INSPECTION

PROPERTY DESCRIPTION NO. 20012 DATE Jan 11, '95 TAX MAP NO. 2F6A50 Watershed: ☑ Yes ☐ No

OWNER OR CONTRACTOR Wells Builders PHONE: Business 664-5255 ~~Home~~ 462-42-5322 LN WS IV

ADDRESS 234 Chuckwood Dr., Mooresville

LOCATION 1400 TR Chuckwood TR Seagrove TR Lakeland on Lft corner lot wj Riviera

SUBDIVISION Holiday Harbor BLOCK / SECTION ____ LOT 50 LOT AREA ~107' X 179' SITE CLASS. B pre 1956 DESIGN FLOW 360 gpd L.T.A.R. .3

Septic Tank: 1000 Gallons; STB 794 Date ____

Pump Tank: ____ Gallons; PT ____ Date ____

Pump Make: ____ Model ____ Serial No. ____

Nitrification Field: No Fields 1 Square Feet ____ Linear Feet 200

No Lines 3 Trench Width 24" Max Trench Bottom Depth 30" Gravel Depth NA

☑ New System ☐ Repair System Type: I, II, III, IV, V, VI

System Description: gravity PPBPS

Repair System Description: Same

Maintenance Agreement Required: ☐ Yes ☑ No

☐ House/Mod. Home No. Bedrooms 3

☐ Mobile Home No. Bathrooms 2

☐ Business No. Employees ____

☐ Other ____


☐ Slab ☑ Crawl Space ☐ Basement w/plumbing ☐ Basement wo/plumbing

Water Supply: ☑ Individual ☐ Community ☐ Public

Comments: Laterals to follow contour
8/11/95 - Changes in blue approved - AWS.

Comments:

INITIAL SITE SKETCH

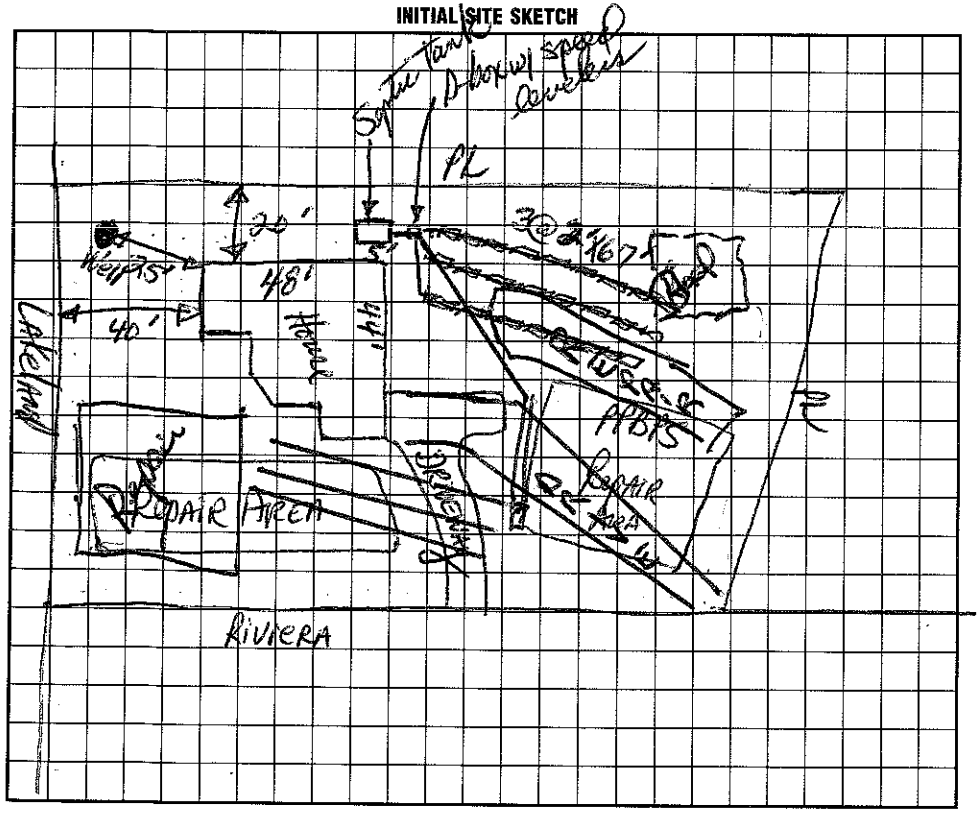

AS BUILT SKETCH

I understand that this permit can be suspended or revoked if any false information is supplied toward securing the permit/any unauthorized changes are made to the site/any unauthorized changes are made in the installation of the system. Improvement Permit is valid for 60 months from date of issuance.

Signed: X

Improvement Permit by: [signature] RS date 1-11-95

Existing System Inspection by: ____ date ____

Installed by: Doug Walls

Certificate of Completion by: Wesley Sparks RS. date 8/18/95

Operation Permit by: ____ date ____

HEALTH DEPT. COPY: WHITE INSPECTION COPY (FINAL): GREEN OWNER COPY (FINAL): YELLOW INSPECTION COPY (INITIAL): PINK OWNER COPY (INITIAL): GOLD