IREDELL COUNTY HEALTH DEPARTMENT

Statesville Phone TR 3-7271 Mooresville Phone NO 3-1271

PERMIT TO INSTALL SEPTIC TANK

Permit No. _____ Permit Date 2 Nov 1965

Owner H. L. Howell Address Route 1 Salem N.C.

Installed By Owner Address Troutman, N.C.


Location of Property Lot 39-40-41 Holiday Hills

| Tank | | Capacity | | Length of Lines | | Fixtures | |
|---|---|---|---|---|---|---|---|
| Block | (✓) | 1000 | (✓) | 225' | (✓) | No. of Baths | ( ) |
| Precast | ( ) | 1250 | ( ) | 250' | ( ) | Dishwasher | ( ) |
| | | 1500 | ( ) | Other _____ | | Garbage Grdr. | ( ) |
| | | Other _____ | | | | Other _____ | |

NOTIFY HEALTH DEPARTMENT AT LEAST EIGHT HOURS BEFORE TANK IS TO BE INSPECTED.

Final Inspection 2 Nov 1965 Approved ( ) Disapproved ( )

Remarks _____

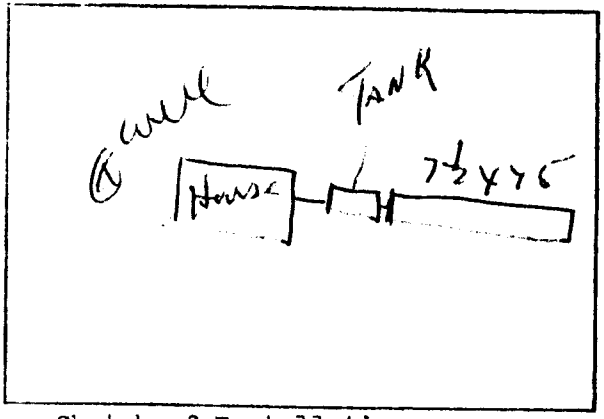


Sketch of Installation

Phillip H. Scoggin RS

Sanitarian