IREDELL COUNTY HEALTH DEPARTMENT

STATESVILLE 704-878-5305 MOORESVILLE 704-664-5281

IMPROVEMENT PERMIT / AUTHORIZATION TO CONSTRUCT / OPERATION PERMIT / EXISTING SYSTEM INSPECTION

PERMIT # 163550/164591 PIN # 4626-43-9246 DATE 10-28-10

OWNER or APPLICANT JANE GRIFFITH PHONE: Business 704-361-0433 Home: KEN DELLINGER

OWNER or APPLICANT ADDRESS 111 BASSETT COVE LN MOORESVILLE NC 28117

LOCATION / DIRECTIONS RSR, TR SOUTHFORK, BASSETT COVE

SUBDIVISION CLET BLOCK / SECTION 8 LOT # 15 LOT AREA DESIGN FLOW 240 GPD L.T.A.R. .3(.25R)

Septic Tank EX 1000 Gallons: STB Date

Pump Tank Gallons: P T Date

Pump Make Model Serial #

Nitrification Field No Fields 1 No Lines 3 Linear Feet 96'

Trench Width 36" Max. Trench Bottom Depth 36" Gravel Depth —

☐ New System ☐ Repair ☒ Expansion System Type I II III IV V VI

System Description: GRAVITY 25% REDUCTION

Repair System Description: PANEL BLOCK

Maintenance Agreement Required ☐ YES ☒ NO

☐ GRAVITY ☐ PRESSURE

☑ Residence No. Bedrooms

☐ Business No. Persons

☐ Other No. Employees

☐ Slab ☒ Crawl Space


☐ Basement w/plumbing ☐ Basement w/o plumbing

Water Supply: ☒ Private ☐ Public ☐ Community


Comments / Conditions ① INSTALL 3 C32' LINES AS SHOWN
② INSTALL FILTER IN ST IF NOT ALREADY DONE

Comments / Conditions

INITIAL SITE SKETCH

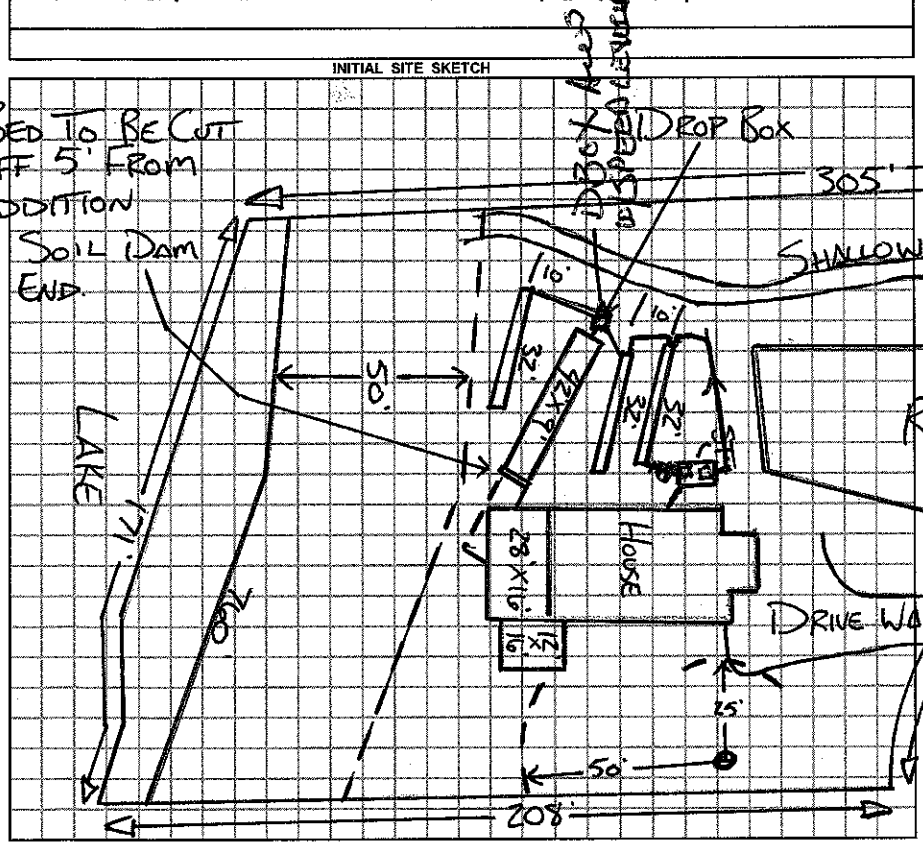

AS BUILT SKETCH

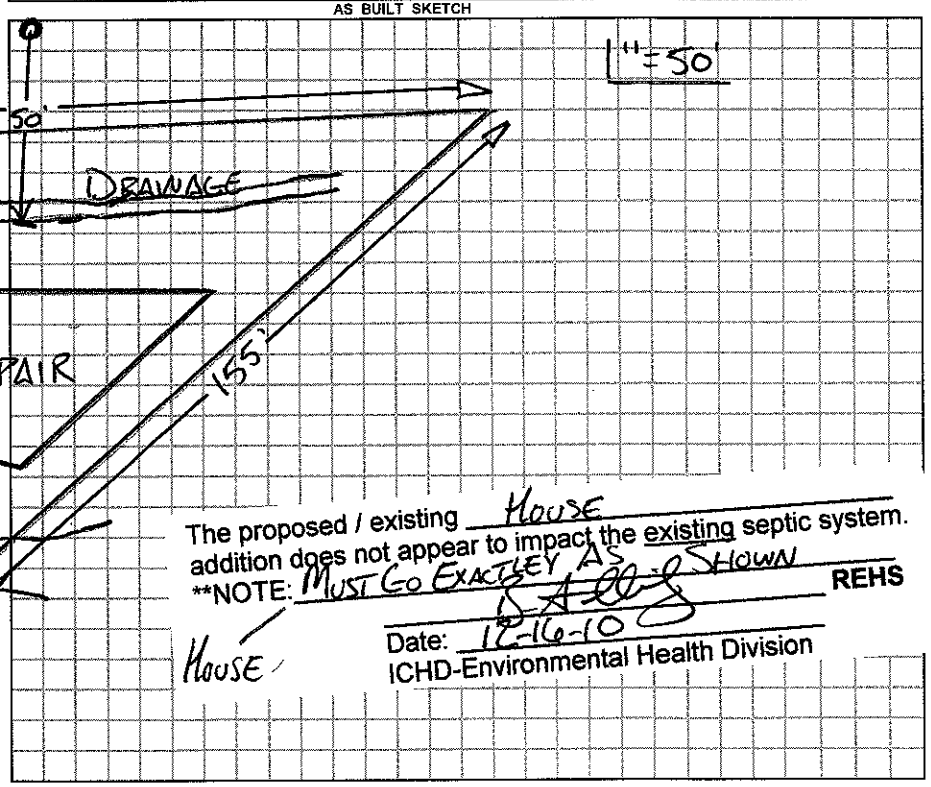

The proposed / existing HOUSE addition does not appear to impact the existing septic system.
**NOTE: MUST GO EXACTLEY AS SHOWN REHS
Date: 12-16-10
ICHD-Environmental Health Division

HOUSE

Permit can be suspended or revoked if any false information is supplied toward securing the permit / any unauthorized changes are made to the site / any unauthorized changes are made in the installation of the system.

☐ *IMPROVEMENT PERMIT w / plat valid without expiration* ☐ *IMPROVEMENT PERMIT w / site plan valid for 60 mos.* ☐ *AUTHORIZATION TO CONSTRUCT valid for period equal to IMPROVEMENT PERMIT-not to exceed 60 mo.*

Owner / Applicant Signature: Ken Dellinger Date 11-8-10

Improvement Permit by: REHS Date 11-2-10

Authorization to Construct by: REHS Date 11-2-10

YOU SHOULD CONTACT A LOCATOR SERVICE PRIOR TO ANY EXCAVATION.

Installed by: Dennis Hoyle

Operation Permit by: Wesley Sparks REHS Date: 11/24/2010

Existing System Inspected by: Date:

WHITE COPY Environmental Health YELLOW COPY (Final) Owner / Applicant PINK COPY (Initial) Owner / Applicant