700.00 Paid

IREDELL COUNTY HEALTH DEPARTMENT

STATESVILLE 704-878-5305 MOORESVILLE 704-664-5281

IMPROVEMENT PERMIT / AUTHORIZATION TO CONSTRUCT / OPERATION PERMIT / EXISTING SYSTEM INSPECTION

DATE 6-7-06

PERMIT# 13104l PIN# 4622644668 4626446670

OWNER OR APPLICANT Jason Heller PHONE: Business 704-649-9898 Home 704-799-0962

ADDRESS 112 Webbed Foot Rd Mooresville 28117

LOCATION Brawley School Rd TR Southfork bear right on Agnew TL Chatfield Cove

SUBDIVISION CL&T BLOCK / SECTION 8 LOT 55 LOT AREA .815 Ac SITE CLASS. PS DESIGN FLOW 360 gpd L.T.A.R. .25 gpd/ft² .3 Repair

1/3 230 v 61

Septic Tank: 1000 Gallons; STB 312 Date 6-12-07

Pump Tank: 1000 Gallons; PT 283 Date 6-12-07

Pump Make: Goulds Model WE0313MU Serial No.

Nitrification Field: No Fields 1 Square Feet 1440 Linear Feet 240

No Lines 3@80' Trench Width 24" min Max Trench Bottom Depth 32"

☒ New System ☐ Repair ☐ Expansion System Type: I II III IV V VI

System Description: LP PPBPS

Repair System Description: LPPPBPS

Maintenance Agreement Required: ☒ Yes ☐ No

☒ House/Mod. Home ☐ Mobile Home ☐ Business ☐ Other

No. Bedrooms 3 No. Persons 6 No. Employees


Water Supply: ☒ Individual ☐ Public ☐ Community

Gravel Depth NA ☐ Gravity ☒ Pressure ☐ Slab ☐ Crawl Space ☒ Basement w/plumbing ☐ Basement wo/plumbing


Comments:/Conditions: 56 panels total
Properly abandon existing system if must be excavated
Submit maintenance agreement before OP

Comments:/Conditions: Red polylok filter

INITIAL SITE SKETCH 260.44' 1"=50'

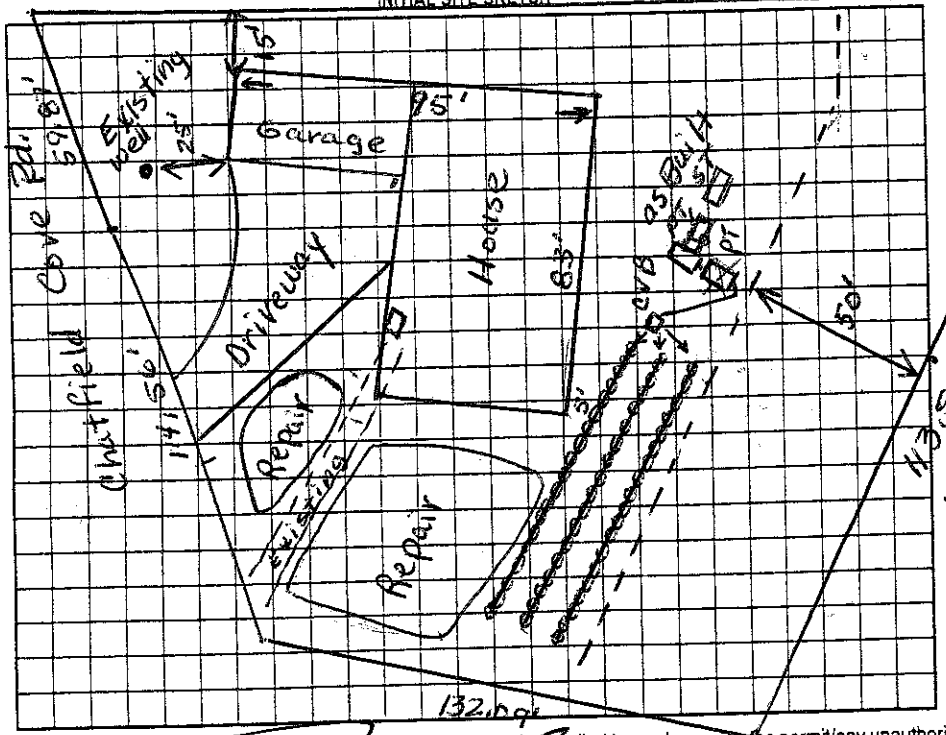

AS BUILT SKETCH

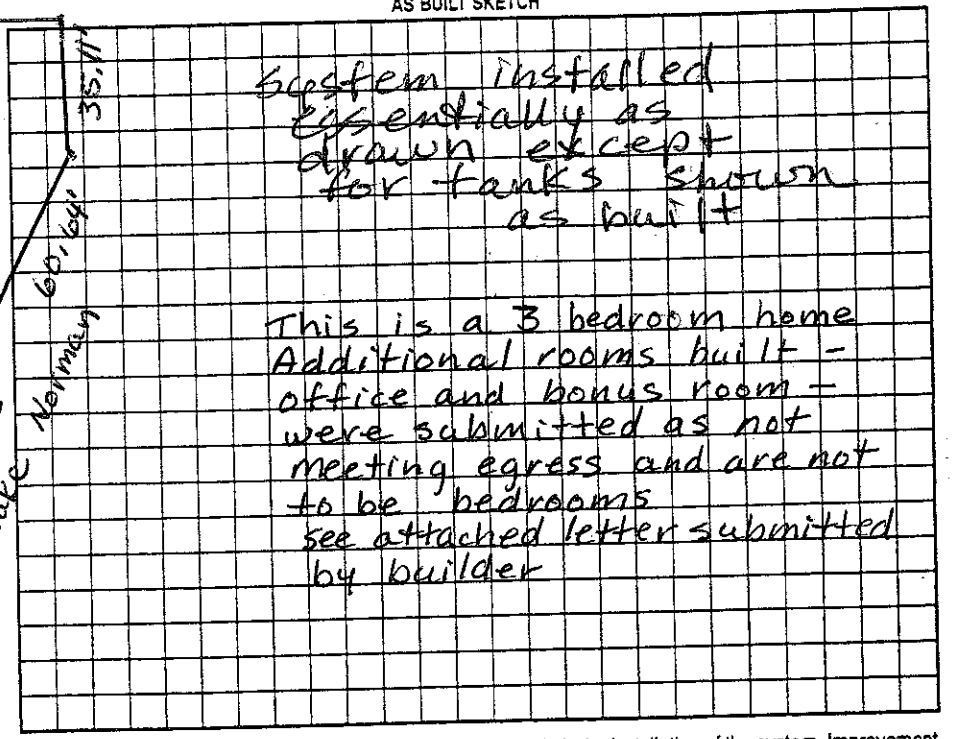

System installed essentially as drawn except for tanks shown as built

This is a 3 bedroom home Additional rooms built - office and bonus room - were submitted as not meeting egress and are not to be bedrooms see attached letter submitted by builder

Permit can be suspended or revoked if any false information is supplied toward securing the permit/any unauthorized changes are made to the site/any unauthorized changes are made in the installation of the system. Improvement Permit with plat valid without expiration ☐ Improvement Permit with site plan valid for sixty months ☒ Authorization to Construct is valid for a period equal to that of Improvement Permit – not to exceed sixty months.

Signed: date 6-9-06 Installed by: Stanley Septic

Improvement Permit by: Judy Melvill date 6-7-06 Operation Permit by: Judy Melvill date 8-27-07

Authorization to Construct by: Judy Melvill date 6-7-06 Existing System Inspection by: date

HEALTH DEPT. COPY: WHITE OWNER COPY (FINAL): YELLOW OWNER COPY (INITIAL): PINK