IREDELL COUNTY HEALTH DEPARTMENT

Statesville Office (704) 878-5305 Mooresville Office (704) 660-3625 PERMIT # 202889

IMPROVEMENT PERMIT / AUTHORIZATION TO CONSTRUCT / OPERATION PERMIT / EXISTING SYSTEM

PIN # 4626455348

APPLICANT: Renee Osborne APPLICANT ADDRESS: 5400 Country Woods Dr. Mint Hill, NC 28227

SITE ADDRESS: 389 Agnew Rd, Mooresville NC 28117 PHONE: 704 201-0671 ALT. PHONE:

SITE DIRECTIONS: Brawley School Rd TR McKendree TL Kemp Rd TL Agnew Rd house on Rt. B4 Chatfield

SUBDIVISION: C&T SECTION: 8 LOT # 67 LOT AREA: .840 acre DESIGN FLOW: 480 L.T.A.R.: .25

Septic Tank: Exist (gal) STB 794 Date 12-15-14
Pump Tank (gal) PT Date
Pump Make Model Serial #
Nitrification Fields 1 # Lines 2 Linear Ft: 120
Trench Width 36" Max. Trench Bottom Depth 24" Gravel Depth N/A

☐ New System ☐ Repair ☒ Expansion System Type: I ◯ III IV V VI
System Description: Gravity – 25% Reduction
Repair System Description: Modified – Pretreatment
Maintenance Agreement Required: ☐ YES ☒ NO
☒ GRAVITY ☐ PRESSURE

☒ Residence ☐ Business ☐ Other ☐ Slab ☒ Basement w/plumbing
No. Bedrooms: 4 No. Persons No. Employees ☐ Crawl Space


Water Supply: ☒ Private ☐ Public ☐ Community ☐ Basement w/o plumbing

Add

Comments / Conditions:
* If ST is structurally sound & can meet setbacks then it's ok to reuse.
** Note: Basement of house must be at least 15ft from Septic, deck must be at least 5ft

* Exist Septic System appears to be functioning ok. Original Septic Permit for Existing System was permitted for 3 Bedrooms. Additional drainlines is for an additional bedroom for a total of 4

INITIAL SITE SKETCH

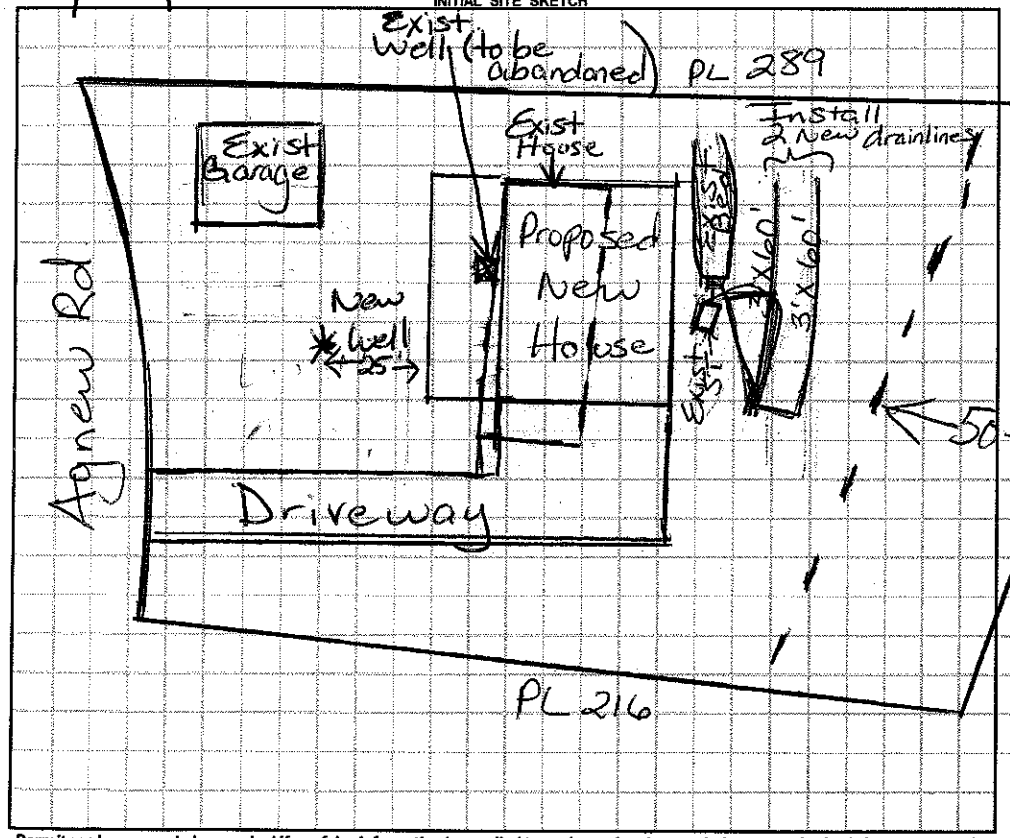

AS BUILT SKETCH

Scale 1:50 Existing well must be Abandoned prior to House Construction
ST ~ 209 to House
Installed New D-box

Lake

Norman

Note: Supply line out of ST along 15ft drainline & then turned down into end cap at end
Used Quick 4

Permit can be suspended or revoked if any false information is supplied toward securing the permit / any unauthorized changes are made to the site / any unauthorized changes are made in the installation of the system. **CONTACT A LOCATOR SERVICE PRIOR TO ANY EXCAVATION**

☐ **IMPROVEMENT PERMIT** *with plat valid without expiration.* ☐ **IMPROVEMENT PERMIT** *with site plan valid for 60 mos.* ☐ **AUTHORIZATION TO CONSTRUCT** *valid for period equal to IMPROVEMENT PERMIT--not to exceed 60 mo.*

Owner / Applicant Signature: Renee Osborne Date: 7/25/14
IMPROVEMENT PERMIT by: Mariah Dotson RS Date: 7/21/14
AUTHORIZATION TO CONSTRUCT by: Mariah Dotson RS Date: 7/21/14

Installed by: Bass Grading
OPERATION PERMIT by: Mariah Dotson RS Date: 1/27/15
Existing System Inspected by: Date:

Health Dept. Copy - WHITE Applicant (Final Approval) - YELLOW Applicant (Conditional Approval) - PINK