ICHD - ENVIRONMENTAL HEALTH DIVISION

Statesville Office (704) 878-5305 x3456 Mooresville Office (704) 660-3625

SEPTIC: IMPROVEMENT PERMIT / AUTHORIZATION TO CONSTRUCT / OPERATION PERMIT / EXISTING SYSTEM

PERMIT: OSWP 2023-20112

PIN # 4626-45-5348

APPLICANT/OWNER: Jeremy Osborne

APPLICANT ADDRESS: 389 Agnew Rd Mooresville NC 28117.

SITE ADDRESS: 389 Agnew Rd Mooresville, NC 28117.

PHONE: 704 201 0671

ALT. PHONE

SITE DIRECTIONS: Brawley School to South Fork Sty on Agnew Lot on left

SAP CONTROLLED: ☐ YES ☒ NO

SUBDIVISION: CL & T

SECTION: 8 LOT # 67 LOT AREA: .84 DESIGN FLOW: 480

L.T.A.R.(Initial): — L.T.A.R (Repair): —

Septic Tank	1000 (gal)	STB	Date	☐ New System	☒ Repair	☐ Expansion	System Type: I II (III) IV V VI
Pump Tank	1000 (gal)	PT	Date	System Description:			
Pump Make		Model	Serial #	Repair System Description:	pm Gravel Bed.		
# Nitrification Fields	1	# Lines	— Sq ft 1408	Maintenance Agreement Required:	☐ YES	☒ NO	
Trench Width	16ft	*Max. Trench Depth(Initial)	48	*Max. Trench Depth(Repair)	—	Gravel Depth	24
					☐ GRAVITY	☒ PRESSURE	

* Measured on the downhill side of the trench

Effluent Standard: ☒ DSE ☐ HSE ☐ TS-I ☐ TS-II ☐ RCW ☐ NSF/ANSI 40

Usable Depth to LC (Initial): —


☒ Residence	No. Bedrooms	4	Water Supply
☐ Business	No. Persons	8	☐ Private
☐ Other	No. Employees		☐ Public
☐ Slab	☐ Crawl Space		☐ Community
☒ Basement w/plumbing	☐ Basement w/o plumbing		

Usable Depth to LC (Repair): — *Limiting Condition*

Comments / Conditions: *Call 704-902-3741 Prior to Construction*
Install 48 inches e Elev(1) to 64 inches e Elev(2) Use 24 in of Stone Sleeve
This permit is in place of previous permit.

* Install in-line pump filter (Sintec)
* Keep system out of powerline R.O.W.
* Shape Area for positive Drainage away from system

INITIAL SITE SKETCH

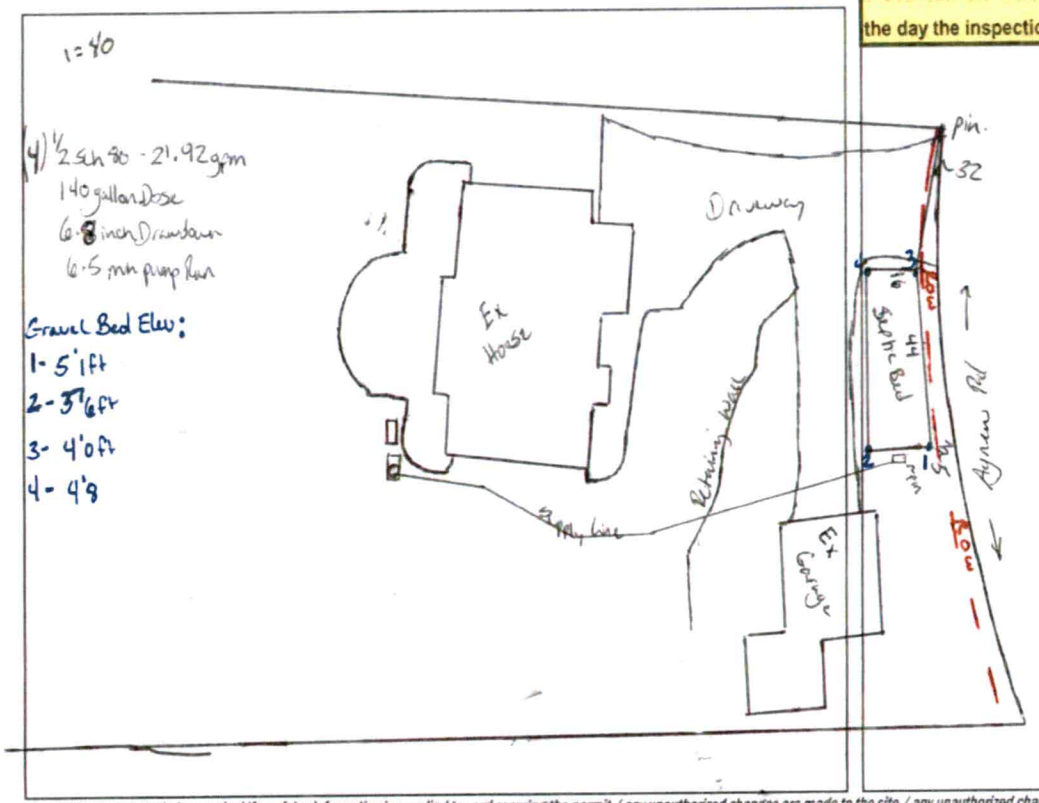

AS-BUILT SKETCH

FOR SEPTIC FINAL INSPECTION CALL: 704-664-3703 between 8am-9am the day the inspection is needed. Be sure to speak with an inspector to confirm your time.

POINT 3 INSTALLED AT 56" DEEP
318-2024 BCW
INSTALLED AS SHOWN
- ALARM
- ELECTRICAL

Permit can be suspended or revoked if any false information is supplied toward securing the permit / any unauthorized changes are made to the site / any unauthorized changes are made in the installation of the system. **CONTACT A LOCATOR SERVICE PRIOR TO ANY EXCAVATION**

☐ **IMPROVEMENT PERMIT** *with plat valid without expiration.* ☒ **IMPROVEMENT PERMIT** *with site plan valid for 60 mos.* ☒ **AUTHORIZATION TO CONSTRUCT** *valid for period equal to IMPROVEMENT PERMIT--not to exceed 60 mo.*

Owner / Applicant Signature: Date:

Installed by: LENTZ WASTEWATER

IMPROVEMENT PERMIT by: Bryant Bates Date: 11-3-2023

OPERATION PERMIT by: Date: 3/19/24

AUTHORIZATION TO CONSTRUCT by: Bryant Bates Date: 11-8-23

Existing System Inspected by: Date:

ICHD - ENVIRONMENTAL HEALTH DIVISION

Statesville Office (704) 878-5305 | Mooresville Office (704) 660-3625 | PERMIT # OSWP-2023-20112

SEPTIC: IMPROVEMENT PERMIT / AUTHORIZATION TO CONSTRUCT / OPERATION PERMIT / EXISTING SYSTEM

PIN # 4626 -- 45 -- 5348

SW

APPLICANT/OWNER: Jeremy Osborne | APPLICANT ADDRESS: 389 Agnew Rd Mooresville NC 28117. 704-201-0671 | ALT. PHONE

SITE ADDRESS: 389 Agnew Rd Mooresville NC | SAP CONTROLLED: ☐ YES ☒ NO

SITE DIRECTIONS: Brawley School to South Fork to Agnew.

SUBDIVISION: CL+T | SECTION: 8 | LOT # 67 | LOT AREA: .54 Ac | DESIGN FLOW: 480 | L.T.A.R.: —

Septic Tank	1000 (gal)	STB Existing	Date —	☐ New System	☒ Repair	☐ Expansion	System Type: I (II) III IV V VI	☒ Residence	No. Bedrooms 4
Pump Tank	1000 (gal)	PT	Date	System Description: —				☐ Business	No. Persons 8
Pump Make		Model	Serial #	Repair System Description: Gravel Bed.				☐ Other	No. Employees
# Nitrification Fields	1	# Lines —	Sq Ft 924	Maintenance Agreement Required:	☐ YES	☒ NO		☐ Slab	☐ Crawl Space
Trench Width	12ft	Trench Bottom Depth(Low side)	60 inch	Gravel Depth	24 inches	☐ GRAVITY	☒ PRESSURE	☒ Basement w/ plumbing	☐ Basement w/o plumbing

Water Supply: ☒ Private ☐ Public ☐ Community

Comments / Conditions: * Call 704-902-3741 Prior to Cutover/Hook *
Install @ 48 inches @ Elev(1) to 60 Inches @ Elev(2). Use 24 in of Stone.
Sleeve Supply in Sch 80 where Supply line goes under drive. Install Secure


* Install in line pump filter (Sinter) & Re-Route French Drain on Back
* Keep System out of Roadside R.O.W
* Shape Area for positive Drainage away from System

INITIAL SITE SKETCH

140 gallon Dose / 6.8 inch Drawdown. (4) 1/2 sch 80 - 21.92 gpm
6.5 min pump Run


Gravel Bed Elev:
1- 3'8 ft
2- 2'3 1/2 ft
3- 3'1 1/2 ft
4- 2'7 ft

1:40

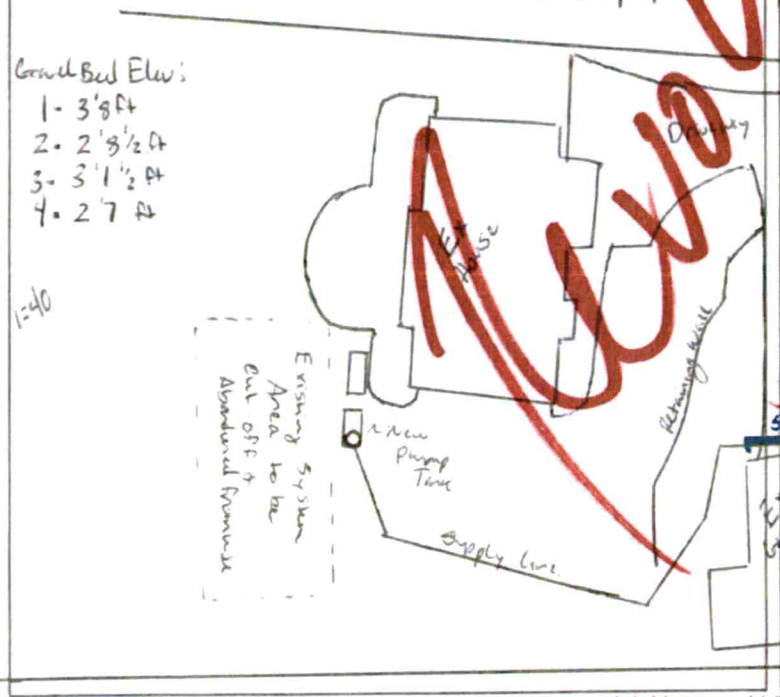

AS BUILT SKETCH

FOR SEPTIC FINAL INSPECTION CALL: 704-664-3703 between 8am-9am the day the inspection is needed. Be sure to speak with an inspector to confirm your time.

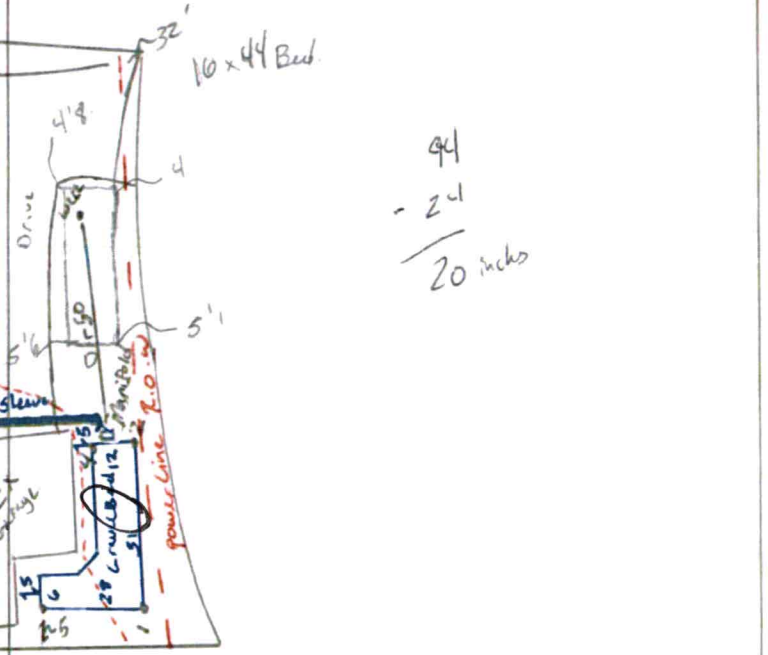


Permit can be suspended or revoked if any false information is supplied toward securing the permit / any unauthorized changes are made to the site / any unauthorized changes are made in the installation of the system. CONTACT A LOCATOR SERVICE PRIOR TO ANY EXCAVATION

☐ IMPROVEMENT PERMIT *with plat* valid without expiration. ☒ IMPROVEMENT PERMIT *with site plan* valid for 60 mos. ☒ AUTHORIZATION TO CONSTRUCT valid for period equal to IMPROVEMENT PERMIT--not to exceed 60 mo.

Owner / Applicant Signature: _____ Date: _____ Installed by: _____

IMPROVEMENT PERMIT by: Benjamin A Batton Date: 11-3-2023 OPERATION PERMIT by: _____ Date: _____

AUTHORIZATION TO CONSTRUCT by: Benjamin A Batton Date: 11-3-2023 Existing System Inspected by: _____ Date: _____

FOR SEPTIC FINAL INSPECTION: CALL 704-664-3703 between 8am-9am the day the inspection is needed.