IREDELL COUNTY HEALTH DEPARTMENT

(SEPTIC TANK) IMPROVEMENTS PERMIT AND CERTIFICATE OF COMPLETION
(Ground Absorption Sewage Disposal System – G. S. Chapter 130-Article 13C)

OWNER OR CONTRACTOR David Broome DATE 7-25-77 PERMIT NO. _____

PHONE: Business _____ Home _____


LOCATION 1100 TR on 1115 TL on 1445 TL on 1250 ¼ mi on right S. R. No. _____

SUBDIVISION NAME Lake Norman LOT NO. 68 SECTION OR BLOCK NO. 8

House (✓) Mobile Home ( ) Business ( ) Other _____

No. Bedrooms 3 No. Bathrooms 2
Garbage Disposal Unit Yes (✓) No ( )
Auto. Dishwasher Yes (✓) No ( )
Auto. Wash. Machine Yes (✓) No ( )
Site Suitable Yes (✓) No ( )
Lot Area ½ acre

Character & Porosity of Soil Clay & Rock Parent mat.
Percolation Rate est. clay Cannot perc
Topography 12% Slope
Depth to Water Table 10'
Rock or other impervious formations Shaly Parent material to hard rock

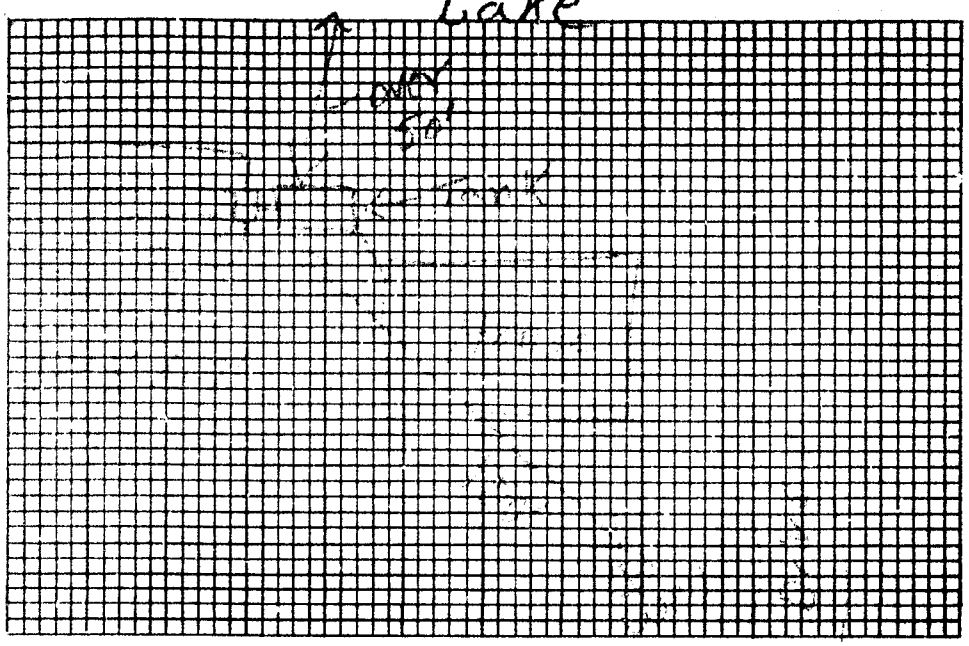

Plot of System

Size of Tank 1500 Gals.
Nitrification Field:
No. of Lines 3
Sq. Ft. 225 Linear Ft. 250
Depth of Stone in Lines 17"
Water Supply: Individual (✓)
Public ( )

Installed by John Howie

IMPROVEMENTS PERMIT BY D. C. Moore

COMMENTS: System was installed lot had shallow rock than found at time of test deep water used to minimize.

CERTIFICATE OF COMPLETION BY D. C. Moore DATE 7-25-77

CONSTRUCTION MUST COMPLY WITH ALL OTHER APPLICABLE STATE AND LOCAL REGULATIONS.

Health Dept. Copy: White Inspection Dept. Copy: Yellow Sanitarian's Copy: Pink Owner's Copy: Gold