10'00

# IREDELL COUNTY HEALTH DEPARTMENT

STATESVILLE 704-878-5305 MOORESVILLE 704-664-5281

## IMPROVEMENT PERMIT / AUTHORIZATION TO CONSTRUCT / OPERATION PERMIT / EXISTING SYSTEM INSPECTION

PERMIT# 122338 PIN# 4626455 6909.451 4626-45-7089 DATE 6/30/04

OWNER OR CONTRACTOR THE FARMS LLC / Craig Carter Builders PHONE: Business 660-1185 Home

ADDRESS 2214 BRAWLEY SCHOOL RD - MOORESVILLE NC 28115

LOCATION BRAWLEY SCHOOL - TR SOUTH FORK - TR AGNEW ON RT PAST CHAFFIELD

SUBDIVISION THE FARMS BLOCK / SECTION 3 LOT 451 LOT AREA 31,848 ft² SITE CLASS. PS DESIGN FLOW 480GPD L.T.A.R. .36-PSP/F12

Septic Tank: 1000 Gallons; STB 444 Date 9-17-08

Pump Tank: Gallons; PT Date

Pump Make: Model Serial No.

Nitrification Field: No Fields 1 Square Feet 1200 Linear Feet 400

No Lines 3@133' Trench Width 36" Max Trench Bottom Depth 36" Gravel Depth N/A

☑ New System ☐ Repair System Type: I, II, III, IV, V, VI

System Description: GRAVITY 25% REDUCTION

Repair System Description: LP PANEL

Maintenance Agreement Required: ☐ Yes ☑ No

☑ House/Mod. Home No. Bedrooms 4

☐ Mobile Home No. Bathrooms 4

☐ Business No. Employees

☐ Other


☐ Slab ☑ Crawl Space ☐ Basement w/plumbing ☐ Basement wo/plumbing

Water Supply: ☐ Individual ☐ Public ☑ Community


Comments/Conditions:

Comments/Conditions: Installed Quick 4 essentially as drawn.

INITIAL SITE SKETCH 1"=50'

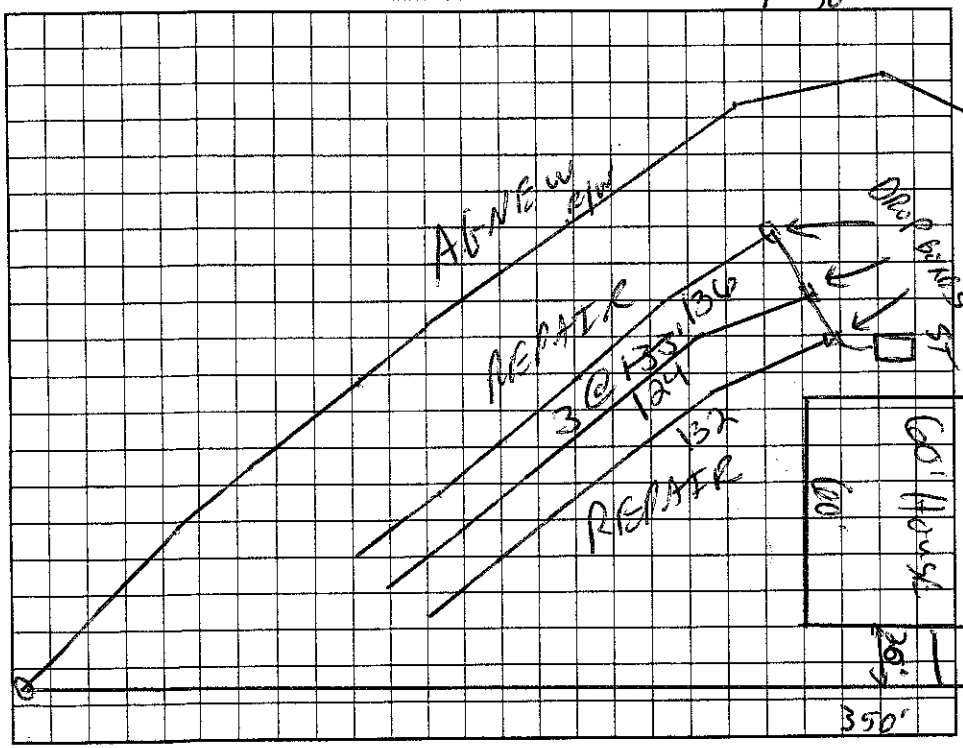


AS BUILT SKETCH

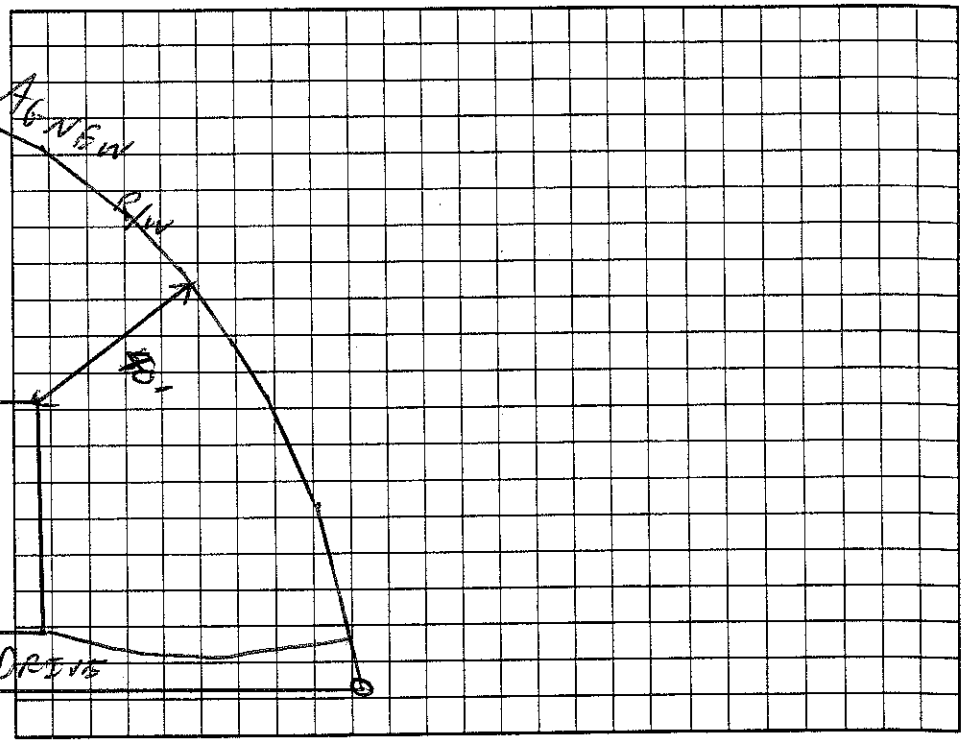


Permit can be ~~suspended~~ or revoked if any false information is supplied toward securing the permit/any unauthorized changes are made to the site/any unauthorized changes are made in the installation of the system. Improvement Permit ~~with plat~~ valid ~~without expiration~~; Improvement Permit with site plan valid for sixty months. Authorization to Construct is valid for a period equal to that of Improvement Permit – not to exceed sixty months.

Signed: date 7-12-04 Installed by: Richard Abernathy RS 10/21/08

Improvement Permit by: date 6/30/04 Operation Permit by: date

Authorization to Construct by: date 5-16-08 Existing System Inspection by: date

HEALTH DEPT. COPY: WHITE OWNER COPY (FINAL): YELLOW OWNER COPY (INITIAL): PINK