IREDELL COUNTY HEALTH DEPARTMENT

STATESVILLE 704-878-5305 300.00 Paid MOORESVILLE 704-664-5281

IMPROVEMENT PERMIT / AUTHORIZATION TO CONSTRUCT / OPERATION PERMIT / EXISTING SYSTEM INSPECTION

PERMIT# 112840 PIN# 4626 45 7896 DATE 10/7/03

OWNER OR CONTRACTOR Moser Bros. Inc. / Brian Bass PHONE: Business 704-663-4020 Home

ADDRESS 119 Barber Loop Mooresville, NC. 28117

LOCATION Farmington Ln. - 1100 TR McKendree TL Kemp TL Agnew corner of Agnew and Farmington.

SUBDIVISION CL+T BLOCK / SECTION 8 LOT 71 LOT AREA .99 Ac SITE CLASS. V P3 DESIGN FLOW L.T.A.R. .3

Septic Tank: 1000 Gallons; STB 1007 Date 6/23/06
Pump Tank: 1000 Gallons; PT 274 Date 4/27/06
Pump Make: Model Serial No.
Nitrification Field: No Fields 1 Square Feet 900 Linear Feet 300
No Lines 3@100' Trench Width 3 Max Trench Bottom Depth 3' Gravel Depth N/A

☑ New System ☐ Repair System Type: I, II, III, IV, V, VI
System Description: Pres. Manifold - 2570 Reduced
Repair System Description: Pres Dosed 16" PPBPS
Maintenance Agreement Required: ☐ Yes ☒ No

☒ House/Mod. Home No. Bedrooms 3
☐ Mobile Home No. Bathrooms 3
☐ Business No. Employees
☐ Other
☐ Slab ☐ Crawl Space ☒ Basement w/plumbing ☐ Basement wo/plumbing


Water Supply: ☒ Individual ☐ Public ☐ Community

Comments:/Conditions:


Comments:/Conditions:

1" = 50'

INITIAL SITE SKETCH

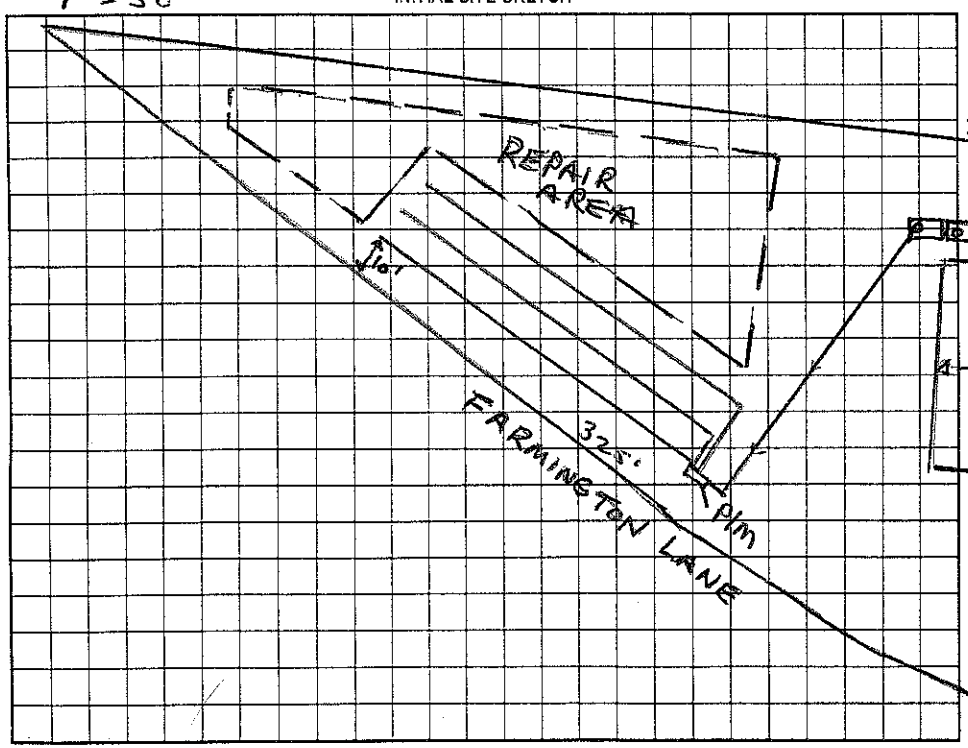

AS BUILT SKETCH

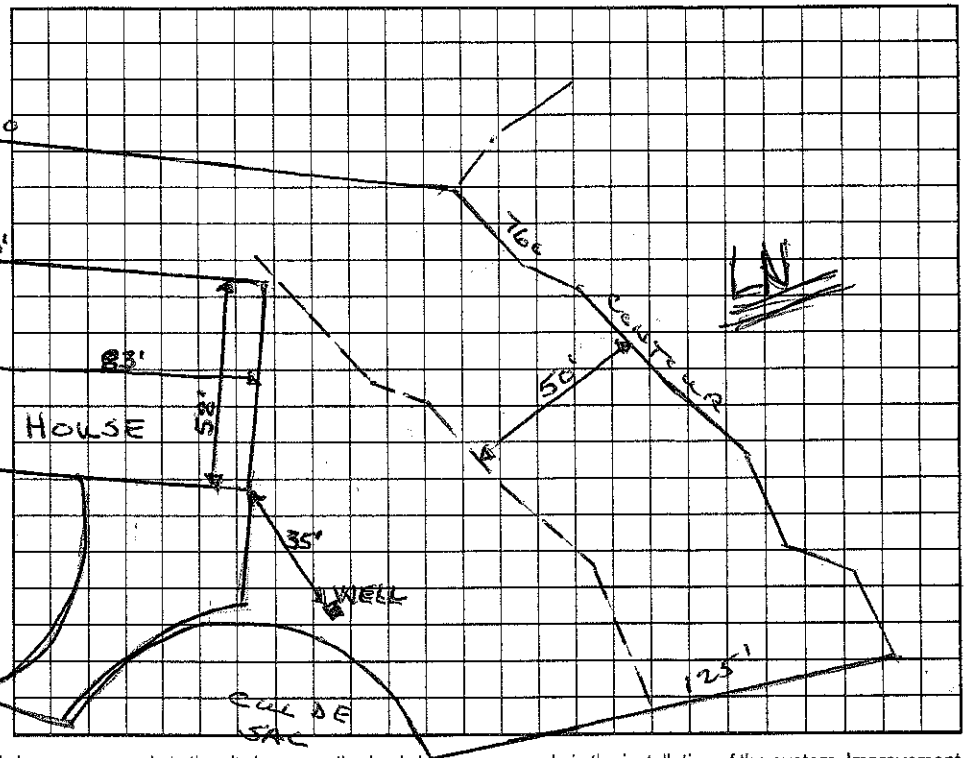

Permit can be suspended or revoked if any false information is supplied toward securing the permit/any unauthorized changes are made to the site/any unauthorized changes are made in the installation of the system. Improvement Permit with plat valid without expiration. Improvement Permit with site plan valid for sixty months. Authorization to Construct is valid for a period equal to that of Improvement Permit – not to exceed sixty months.

Signed: [signature] date 3/18/04 Installed by: Abernathy

Improvement Permit by: Wesley Sparks RS date 10/29/03 Operation Permit by: [signature] date 10/30/06

Authorization to Construct by: Wesley Sparks RS date 10/29/03 Existing System Inspection by: date

HEALTH DEPT. COPY: WHITE OWNER COPY (FINAL): YELLOW OWNER COPY (INITIAL): PINK