IREDELL COUNTY HEALTH DEPARTMENT

STATESVILLE 704-878-5305 MOORESVILLE 704-664-5281

IMPROVEMENT PERMIT / AUTHORIZATION TO CONSTRUCT / OPERATION PERMIT / EXISTING SYSTEM INSPECTIO

PERMIT# 12337 PIN# ~~4626 55 69 09.450~~ 4626 45 81 88 DATE 6/30/04

OWNER OR CONTRACTOR THE FARMS, LLC / T. Whelan Homes PHONE: Business 660-1185 Home

ADDRESS 3214 BRAWLEY SCHOOL - MOORESVILLE NC 28115

LOCATION BRAWLEY SCHOOL - TR SOUTHFORK - TR AGNEW - ON RT PAST CHATFIELD COVE

SUBDIVISION THE FARMS BLOCK / SECTION 3 LOT 450 LOT AREA 48,557 ft² SITE CLASS PS DESIGN FLOW 480GPD L.T.A.R. .30RD/FT²

Septic Tank: 1000-1500 Gallons; STB 338 Date 8/20/07
Pump Tank: ____ Gallons; PT ____ Date ____
Pump Make: ____ Model ____ Serial No. ____
Nitrification Field: No Fields 1 Square Feet 1200 Linear Feet 400
No Lines 4 @ 100' Trench Width 36" Max Trench Bottom Depth 36" Gravel Depth N/A

☑ New System ☐ Repair System Type: I, II, (III) IV, V, VI
System Description: GRAVITY 25% REDUCTION
Repair System Description: SAME
Maintenance Agreement Required: ☐ Yes ☑ No


☑ House/Mod. Home No. Bedrooms 4
☐ Mobile Home No. Bathrooms 4
☐ Business No. Employees ____
☐ Other ____
☐ Slab ☑ Crawl Space ☐ Basement w/plumbing ☐ Basement wo/plumbing

Water Supply:
☐ Individual
☐ Public
☑ Community


Comments:/Conditions: Reviewed Building plans & site plan essentially in compliance with original permit.

Comments:/Conditions: clr of the tons shot-lld.

INITIAL SITE SKETCH 1"=50'

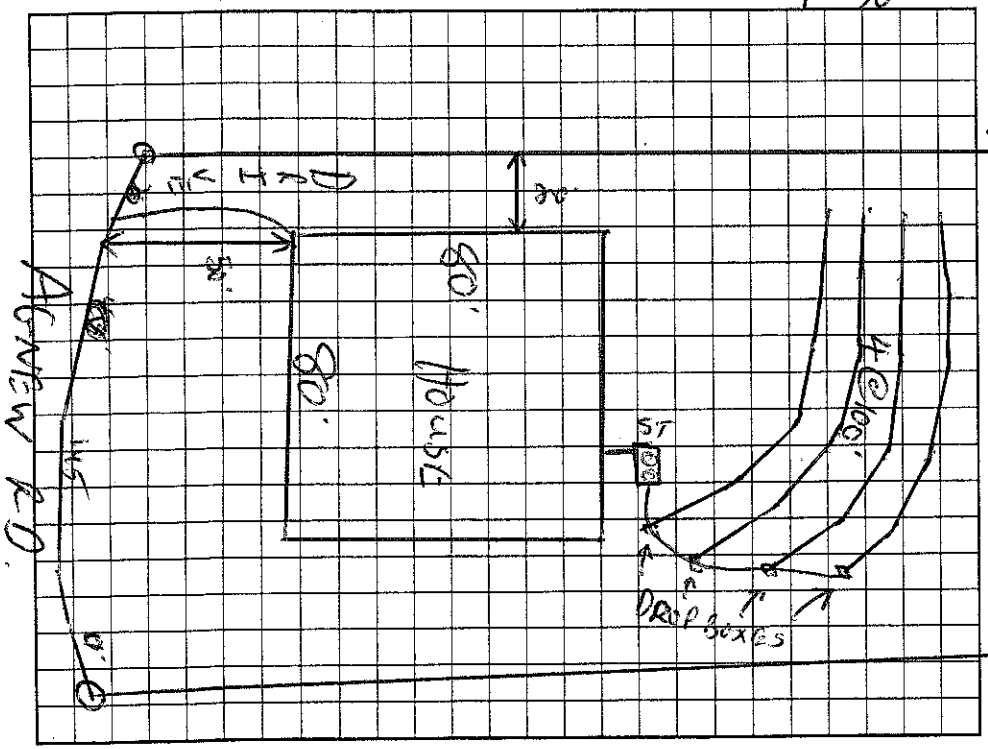

AS BUILT SKETCH

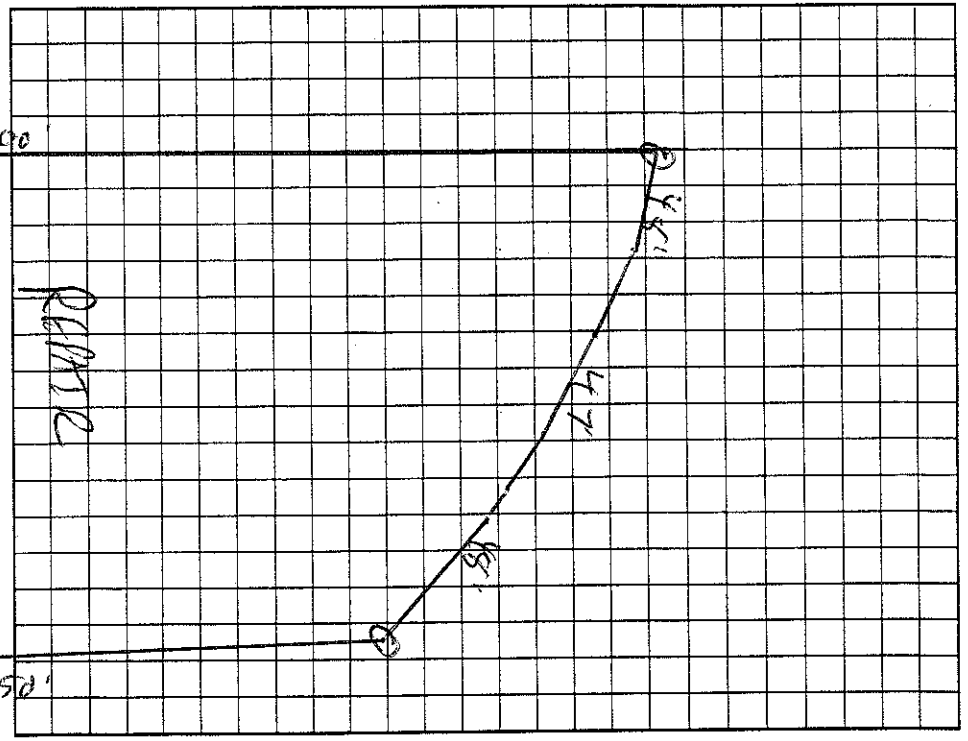

Permit can be suspended or revoked if any false information is supplied toward securing the permit/any unauthorized changes are made to the site/any unauthorized changes are made in the installation of the system. Improvement Permit with plat valid without expiration. Improvement Permit with site plan valid for sixty months. Authorization to Construct is valid for a period equal to that of Improvement Permit – not to exceed sixty months.

Signed: ____ date 7-12-04 Installed by: Larry Beason

Improvement Permit by: ____ date 6/30/04 Operation Permit by: Wesley Sparks RS. date 4/4/07

Authorization to Construct by: Marvin H. Dotson RS date 11/14/06 Existing System Inspection by: ____ date ____

HEALTH DEPT. COPY: WHITE OWNER COPY (FINAL): YELLOW OWNER COPY (INITIAL): PINK