4626460460

IREDELL COUNTY HEALTH DEPARTMENT

STATESVILLE 704-878-5305 MOORESVILLE 704-664-5281

IMPROVEMENT PERMIT / CERTIFICATE OF COMPLETION / OPERATION PERMIT / EXISTING SYSTEM INSPECTION

PROPERTY DESCRIPTION NO. 23087 DATE 1-23-96 TAX MAP NO. 2F-3-A-78 Watershed: Yes ~~No~~ IVGA

OWNER OR CONTRACTOR CHUCK & ALICIA HANNA PHONE: Business Home (704) 866-9540

ADDRESS 483 AGNEW ROAD MOORESVILLE NC 28115

LOCATION BRAWLEY SCHOOL RD, TR McKENDREE, TL KEMP, TL AGNEW, 2ND LOT ON RIGHT

SUBDIVISION CRESCENT ~~BLOCK~~ SECTION 8 LOT 1644 LOT AREA 1.44 AC SITE CLASS. PS' DESIGN FLOW 480 L.T.A.R. EXISTING 0.35 ope

Septic Tank: EXISTING Gallons; STB ____ Date ____

Pump Tank: ____ Gallons; PT ____ Date ____

Pump Make: ____ Model ____ Serial No. ____

Nitrification Field: No Fields 1 Square Feet 345 Linear Feet 115

No Lines 1 Trench Width 36" Max Trench Bottom Depth 18-36" Gravel Depth 12"

☑ New System ☐ Repair System Type: ☐ I ☐ II ☐ III ☐ IV ☐ V ☐ VI

System Description: CONVENTIONAL GRAVITY

Repair System Description: CHAMBERED GRAVITY

Maintenance Agreement Required: ☐ Yes ☑ No

☑ House/Mod. Home No. Bedrooms 4

☐ Mobile Home No. Bathrooms ____

☐ Business No. Employees ____

☐ Other ____


☐ Slab ☐ Crawl Space ☑ Basement w/plumbing ☐ Basement wo/plumbing

Water Supply:
☑ Individual
☐ Community
☐ Public
WELL

Comments: ① PUMP-OUT SEPTIC TANK ② REMOVE EXISTING D. BOX AND REPLACE WITH THREE FLOW DIVIDER TEES TO ACHIEVE EQUAL DIST. INTO FOUR LINES ③ INSTALL NEW 3'X115' LINE AS FLAGGED ④ MINIMUM 50' FROM LAKE ⑤ KEEP COLLECTION SEWER MINIMUM 50' FROM WELL ⑤

Comments:

INITIAL SITE SKETCH

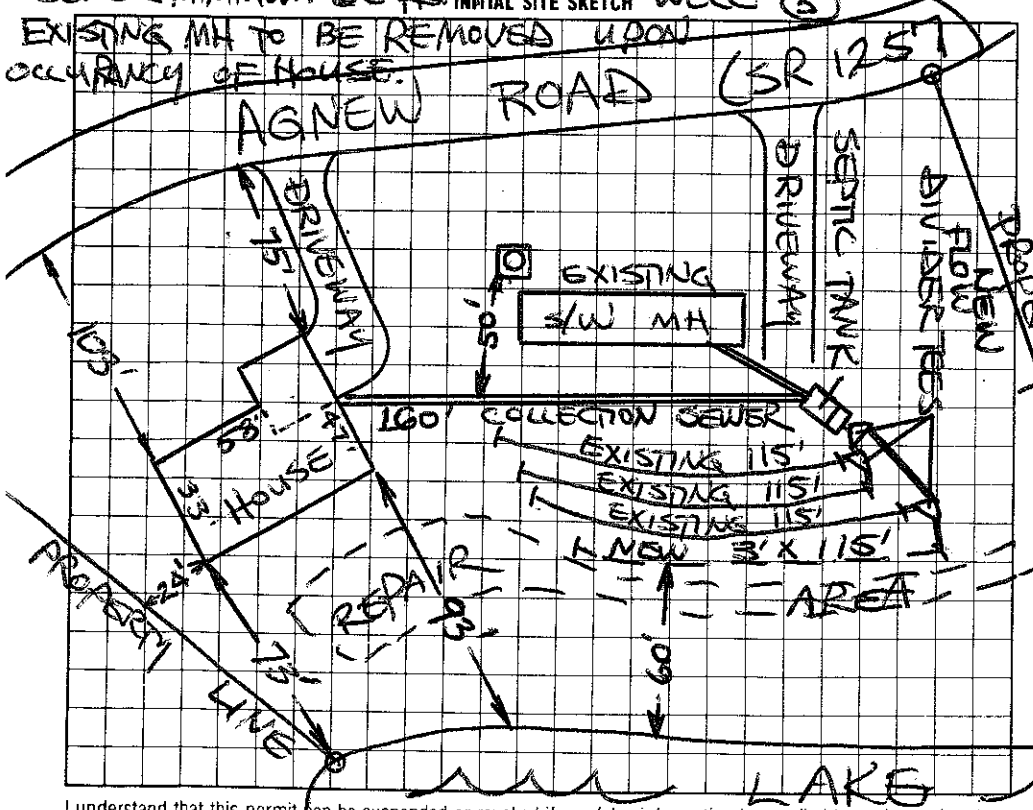

AS BUILT SKETCH

I understand that this permit can be suspended or revoked if any false information is supplied toward securing the permit/any unauthorized changes are made to the site/any unauthorized changes are made in the installation of the system.

AUTHORIZATION TO CONSTRUCT IS VALID FIVE (5) YEARS FROM DATE OF ISSUANCE. IMPROVEMENT PERMIT HAS NO EXPIRATION DATE.

Signed: X Tim Whitacre, Agent

Improvement Permit by: STEVE HODRICK date 1-23-96

AUTHORIZATION TO CONSTRUCT

~~Existing System Inspection~~ by: STEVE HODRICK date 1-23-96

Installed by: Macleod Construction

~~Certificate of Completion by:~~ ____ date ____

Operation Permit by: Wesley Sparks R.S. date 11/22/96

HEALTH DEPT. COPY: WHITE — INSPECTION COPY (FINAL): GREEN — OWNER COPY (FINAL): YELLOW — INSPECTION COPY (INITIAL): PINK — OWNER COPY (INITIAL): GOLD