4.00

IREDELL COUNTY HEALTH DEPARTMENT

STATESVILLE 704-878-5305 MOORESVILLE 704-664-5281

IMPROVEMENT PERMIT / AUTHORIZATION TO CONSTRUCT / OPERATION PERMIT / EXISTING SYSTEM INSPECTI

PERMIT# 124723 PIN# ~~4625505104.391~~ 4626460905.000 Cell DATE 11-17-05

OWNER OR APPLICANT Jasper Builders PHONE: Business 799-1982 ~~Home~~ Cell 201-4980 Shawn

ADDRESS 804 N. Main St. Mooresville NC 28115

LOCATION Brawley School Rd TR McKendree TL Kemp TL Agnew 1st lot on left

SUBDIVISION The Farms BLOCK / SECTION ____ LOT 391 LOT AREA 1.312 Acre SITE CLASS. AS DESIGN FLOW 480gpd L.T.A.R. .3

Septic Tank 1500 Gallons; STB 338 Date ____

Pump Tank 1500 Gallons; PT 441 Date ____

Pump Make: Gouds Model 3VED 3121M Serial No. ____

Nitrification Field: No Fields 1 Square Feet 1500' Linear Feet 500'

No Lines 4@125' Trench Width 36" Max Trench Bottom Depth 36"

☒ New System ☐ Repair ☐ Expansion System Type: I II III IV V VI

System Description: Pump-PM-25% Reduction

Repair System Description: Pump-Panel Block

Maintenance Agreement Required: ☐ Yes ☒ No

Gravel Depth N/A ☐ Gravity ☒ Pressure

☒ House/Mod. Home ☐ Mobile Home ☐ Business ☐ Other

No. Bedrooms 5 No. Persons ____ No. Employees ____

Water Supply: ☐ Individual ☒ Public ☒ Community


☐ Slab ☐ Crawl Space ☒ Basement w/plumbing ☐ Basement wo/plumbing

Comments:/Conditions: Keep Drainfield at least 15ft from cut 2ft or greater & 25ft from basement wall. Keep Septic system 10' from PL


Comments:/Conditions: Installed Quick 4 for Drainfield as Drawn

Scale 1:50

INITIAL SITE SKETCH

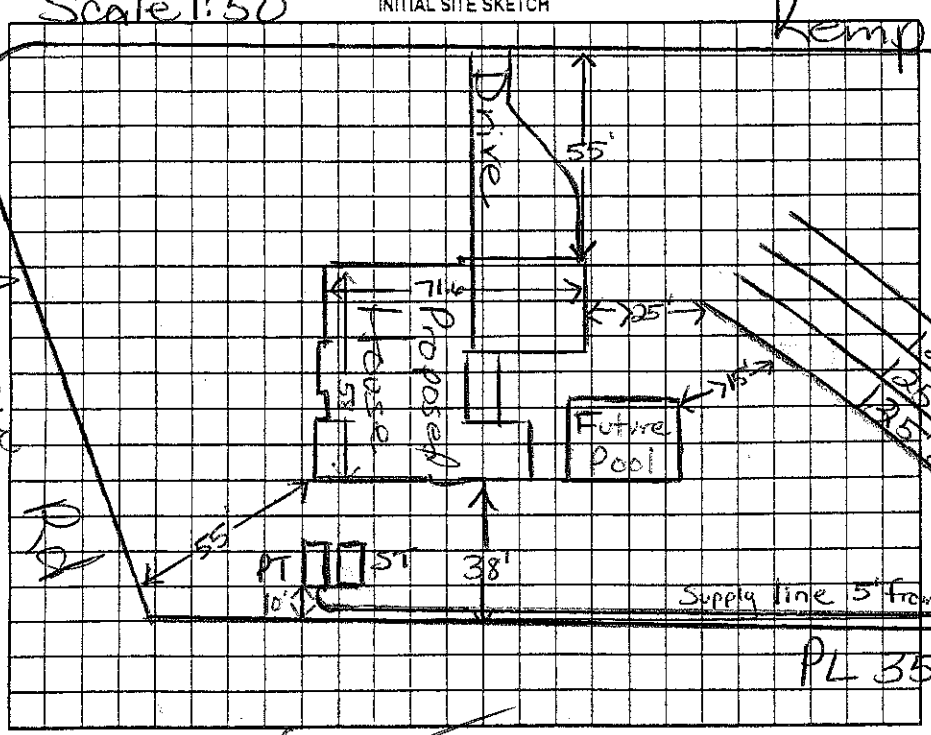

AS BUILT SKETCH

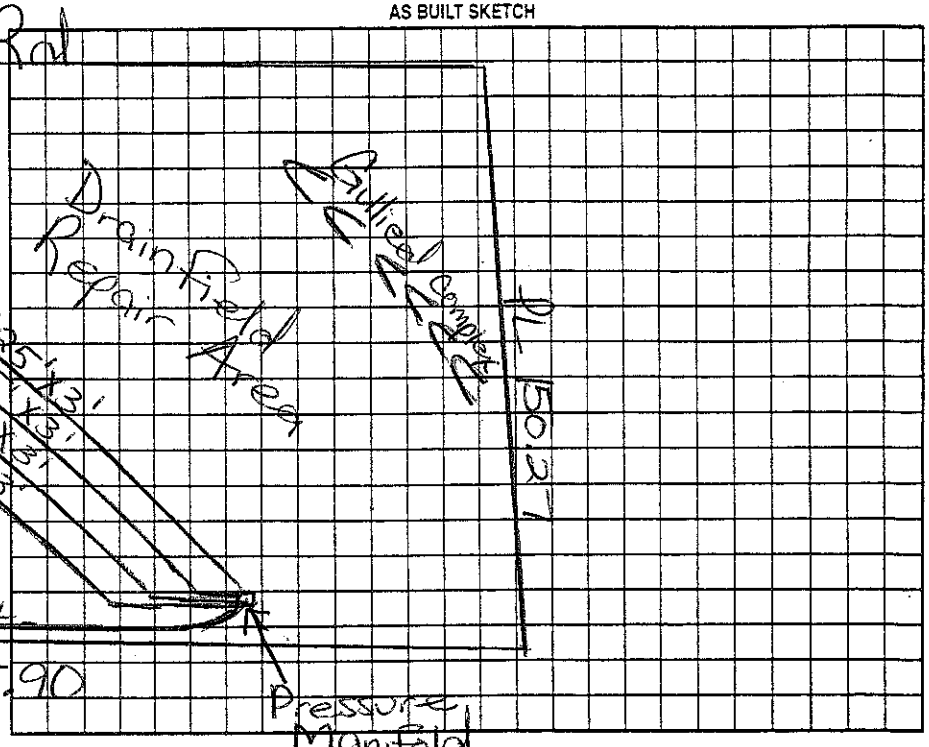

Permit can be suspended or revoked if any false information is supplied toward securing the permit/any unauthorized changes are made to the site/any unauthorized changes are made in the installation of the system. Improvement Permit with plat valid without expiration ☐ Improvement Permit with site plan valid for sixty months ☐ Authorization to Construct is valid for a period equal to that of Improvement Permit – not to exceed sixty months.

Signed: [signature] date 11/17/05 Installed by: Richard Abernathy

Improvement Permit by: Myra H. Dolan RS date 11/17/05 Operation Permit by: [signature] RS date 6/14/06

Authorization to Construct by: Myra H. Dolan RS date 11/17/05 Existing System Inspection by: ____ date ____

HEALTH DEPT. COPY: WHITE OWNER COPY (FINAL): YELLOW OWNER COPY (INITIAL): PINK