4626461260 750.00 Paid 2130

IREDELL COUNTY HEALTH DEPARTMENT

STATESVILLE 704-878-5305 MOORESVILLE 704-664-5281

IMPROVEMENT PERMIT / AUTHORIZATION TO CONSTRUCT / OPERATION PERMIT / EXISTING SYSTEM INSPECTION

PERMIT# 101908 PIN# 4626-46-1260 SP→336 945-5212 DATE 8/31/01

OWNER OR CONTRACTOR Alan Gardner / Sammy Phillips PHONE: Business 704-568-6406 Home 704-576-2058

ADDRESS 1216 Manchester Ln Charlotte NC 28227

LOCATION Brawley Sch, TR McKendree, TL Kemp, TL Agnew, on Rt.

SUBDIVISION CL+T BLOCK / SECTION 8 LOT 77 LOT AREA SITE CLASS PS DESIGN FLOW 480 L.T.A.R. 0.3

Septic Tank: ~~new~~ Existing Gallons; STB Date

Pump Tank: Gallons; PT Date

Pump Make: Model Serial No.

Nitrification Field: No Fields 1 Square Feet 600 Linear Feet Add'l 200

No Lines 2 or 3 Trench Width 36" Max Trench Bottom Depth 36" Gravel Depth —

☒ New System ☐ Repair System Type: I, II, III, IV, V, VI

System Description: Gravity 25% Red. Addition

Repair System Description: Pump Panel

Maintenance Agreement Required: ☐ Yes ☒ No

☒ House/Mod. Home ☐ Mobile Home ☐ Business ☐ Other

No. Bedrooms 4 No. Bathrooms 4 No. Employees


☐ Slab ☐ Crawl Space ☒ Basement w/plumbing ☐ Basement wo/plumbing

Water Supply: ☒ Individual ☐ Public ☐ Community


Comments:/Conditions: Existing Bed Approved for 2 bedrooms
New Addition possible for 2 additional bedrooms
Putting up 28x68 Modular Home

Comments:/Conditions:
Site Reviewed 4/3/02
OK for Temporary MH during const.

INITIAL SITE SKETCH AGNEW Rd

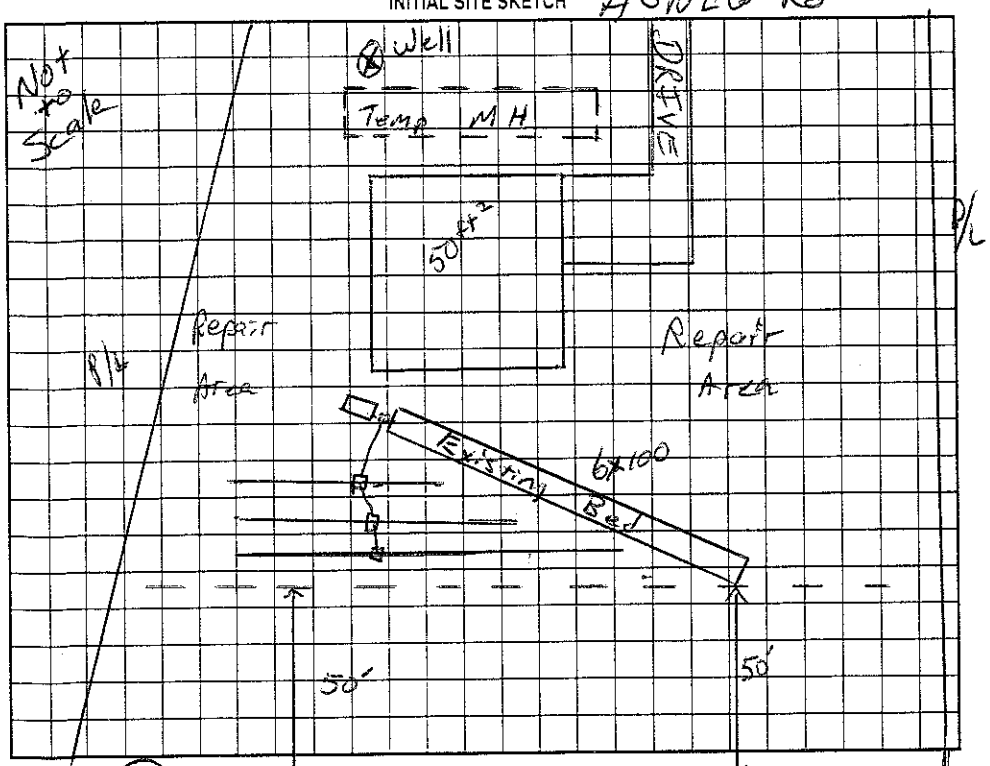

AS BUILT SKETCH

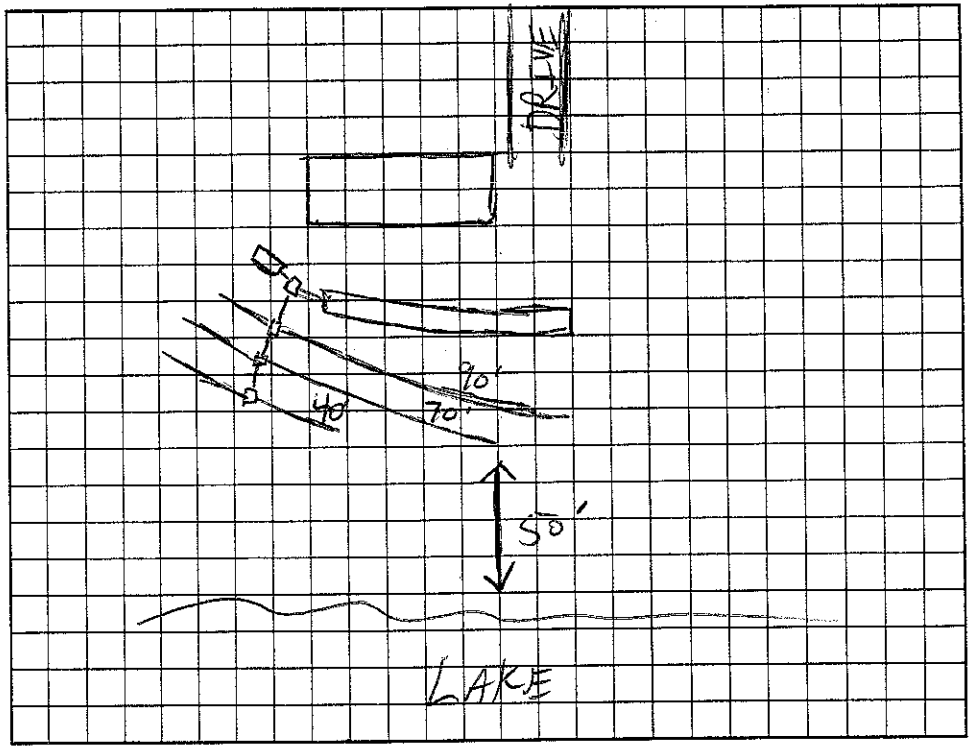

Permit can be suspended or revoked if any false information is supplied toward securing the permit/any unauthorized changes are made to the site/any unauthorized changes are made in the installation of the system. Improvement Permit with plat valid without expiration. Improvement Permit with site plan valid for sixty months. Authorization to Construct is valid for a period equal to that of Improvement Permit – not to exceed sixty months.

Signed: date 9/4/01

Improvement Permit by: RSI date 8/31/01

Authorization to Construct by: RS date 9/3/02

Installed by: BW Christianburg

Operation Permit by: RS date 4/24/02

Existing System Inspection by: date

HEALTH DEPT. COPY: WHITE OWNER COPY (FINAL): YELLOW OWNER COPY (INITIAL): PINK