1.30

IREDELL COUNTY HEALTH DEPARTMENT

STATESVILLE 704-878-5305 MOORESVILLE 704-664-5281

IMPROVEMENT PERMIT / AUTHORIZATION TO CONSTRUCT / OPERATION PERMIT / EXISTING SYSTEM INSPECTION

PERMIT# 124731 PIN# ~~4625505104.392~~ 4626470277 DATE 2/26/07

OWNER OR APPLICANT Jasper Builders PHONE: Business 634-3687 Home

ADDRESS 804 N. Main St. Mooresville, NC 28115

LOCATION Brawley School Rd TR McKendree TL Kemp TL Grove Creek Ln 1st lot on right

SUBDIVISION The Farms BLOCK / SECTION LOT 392 LOT AREA SITE CLASS. DESIGN FLOW L.T.A.R.

Septic Tank: 1500' Gallons; STB 744 Date 7-21-05

Pump Tank: Gallons; PT Date

Pump Make: Model Serial No.

Nitrification Field: No Fields 1 Square Feet 1560 Linear Feet 500'

No Lines 5 @ 100' Trench Width 36" Max Trench Bottom Depth 36"

☒ New System ☐ Repair ☐ Expansion System Type: I II III IV V VI

System Description: Gravity - 25% Reduction

Repair System Description: Pumped 25-50% Reduction

Maintenance Agreement Required: ☐ Yes ☒ No

☒ House/Mod. Home ☐ Mobile Home ☐ Business ☐ Other

No. Bedrooms 5 No. Persons No. Employees

Water Supply: ☐ Individual ☒ Public ☒ Community


Gravel Depth N/A ☒ Gravity ☐ Pressure ☐ Slab ☒ Crawl Space ☐ Basement w/plumbing ☐ Basement wo/plumbing

Comments/Conditions: Replaces previous permit from 4-28-05


Comments/Conditions: Installed Quick 4, essentially as Drawn

Scale 1:50

INITIAL SITE SKETCH

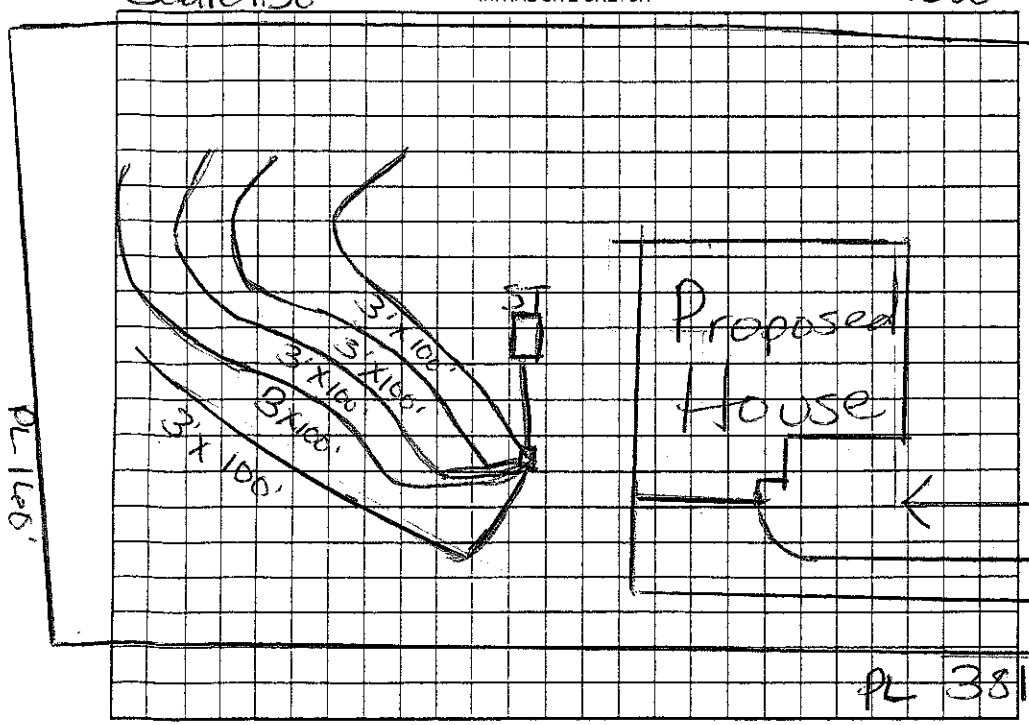

AS BUILT SKETCH

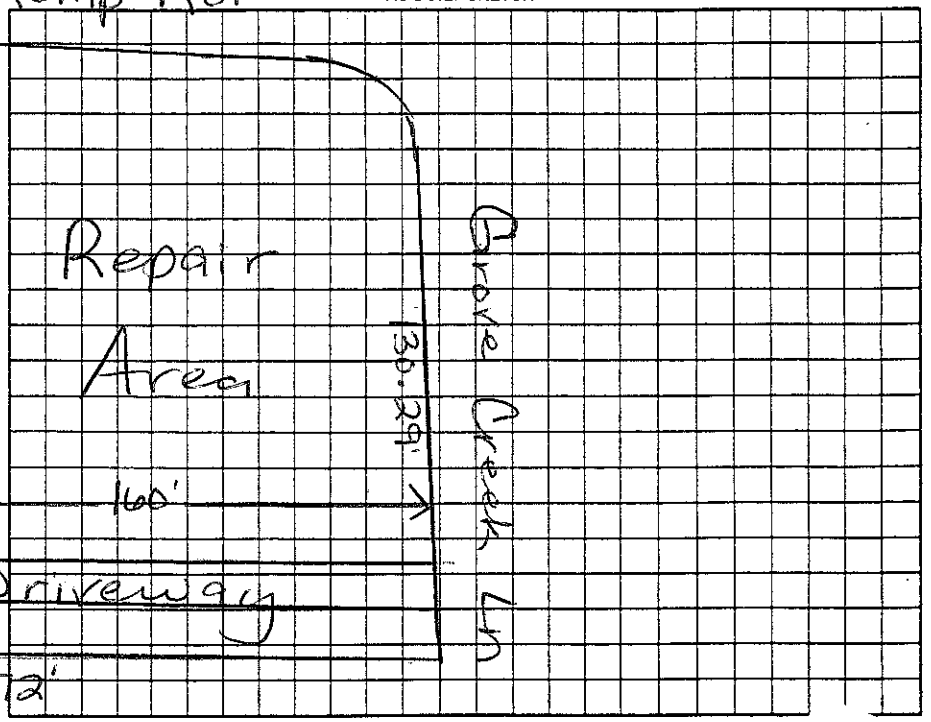

Permit can be suspended or revoked if any false information is supplied toward securing the permit/any unauthorized changes are made to the site/any unauthorized changes are made in the installation of the system

Permit with plat valid without expiration ☐ Improvement Permit with site plan valid for sixty months ☐ Authorization to Construct is valid for a period equal to that of Improvement Permit - not to exce

Signed: Jerri Cauley date 2/27/07 Installed by: Richard Abernathy

Improvement Permit by: Maria H. Dotson RS date 2/26/07 Operation Permit by: Maria H. Dotson RS date

Authorization to Construct by: Maria H. Dotson RS date 2/26/07 Existing System Inspection by: date

HEALTH DEPT. COPY: WHITE OWNER COPY (FINAL): YELLOW OWNER COPY (INITIAL): PINK