IREDELL COUNTY HEALTH DEPARTMENT

STATESVILLE 704-878-5305 MOORESVILLE 704-664-5281

IMPROVEMENT PERMIT / AUTHORIZATION TO CONSTRUCT / OPERATION PERMIT / EXISTING SYSTEM INSPECTION

PERMIT# 19505 PIN# ~~4625-50-5107.406~~ 4625470741 DATE 6/29/04

OWNER OR CONTRACTOR THE FARMS LLC / D. S. Rushing PHONE: Business 660-1185 Home

ADDRESS 2214 BRAWLEY SCHOOL RD - MOORESVILLE NC 28115

LOCATION BRAWLEY SCHOOL - JR McKENDREE - TL KEMP - TR ALDER SPRINGS. ~~3005 OLD CAMP - CORNER OF BRANCH~~

SUBDIVISION THE FARMS BLOCK / SECTION 3 LOT 406 LOT AREA 1.1 Ac SITE CLASS. RS DESIGN FLOW 480GPD L.T.A.R. .36 PD/FT2

Septic Tank: 1000 Gallons; STB 538 Date 8/26/05
Pump Tank: Gallons; PT Date
Pump Make: Model Serial No.
Nitrification Field: No Fields 1 Square Feet 1602 Linear Feet 534
No Lines 5@107' Trench Width 36" Max Trench Bottom Depth 36" Gravel Depth 12"

☑ New System ☐ Repair System Type: I, II, III, IV, V, VI
System Description: GRAVITY ~~CONVENTIONAL~~
Repair System Description: PUMP 25% REDUCTION
Maintenance Agreement Required: ☐ Yes ☑ No


☑ House/Mod. Home No. Bedrooms 4
☐ Mobile Home No. Bathrooms 4
☐ Business No. Employees
☐ Other
☐ Slab ☑ Crawl Space ☐ Basement w/plumbing ☐ Basement wo/plumbing

Water Supply: ☐ Individual ☐ Public ☑ Community


Comments:/Conditions:

Comments:/Conditions:

1"=50' INITIAL SITE SKETCH

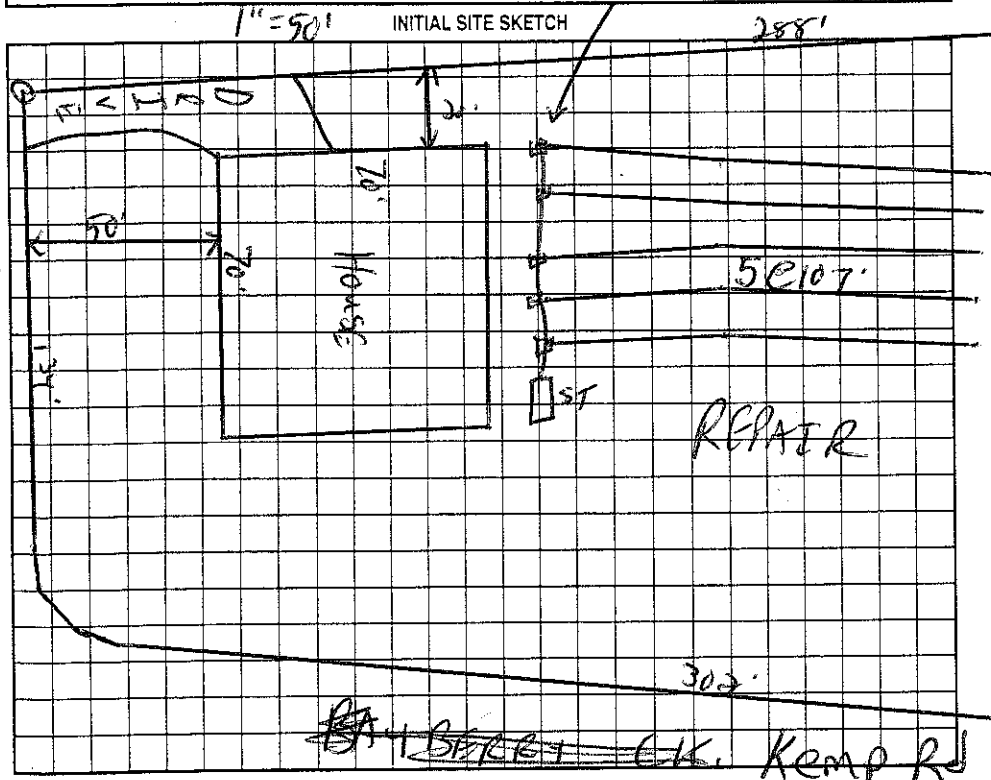

AS BUILT SKETCH

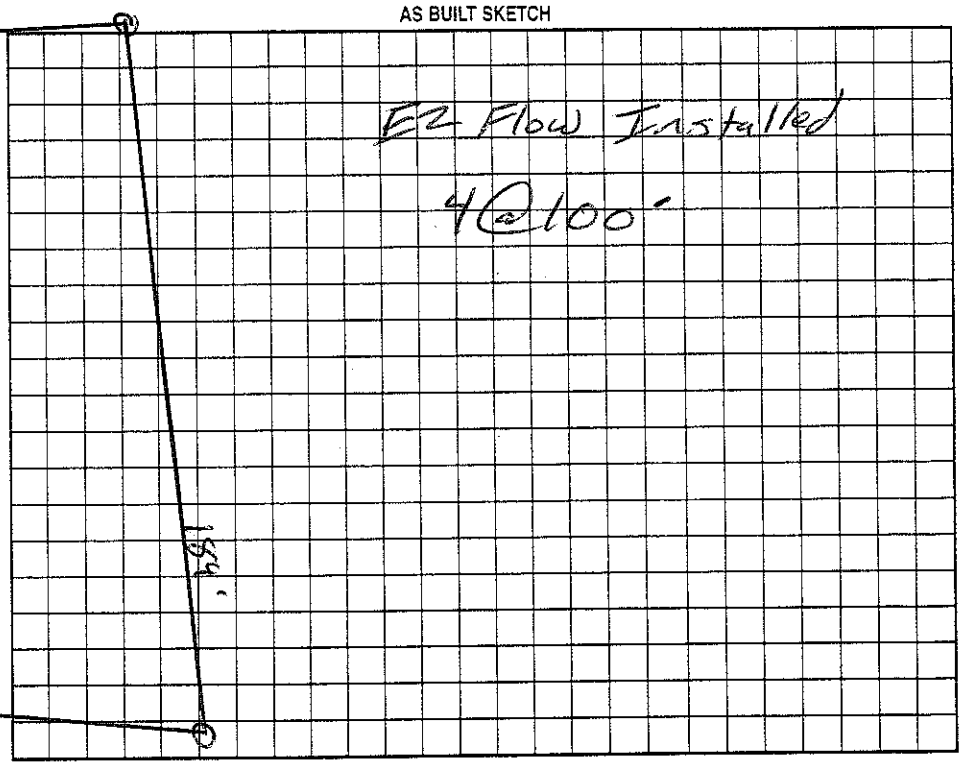

ALDER SPRINGS

Permit can be suspended or revoked if any false information is supplied toward securing the permit/any unauthorized changes are made to the site/any unauthorized changes are made in the installation of the system. Improvement Permit with ~~plat~~ valid without expiration. Improvement Permit with site plan valid for sixty months. Authorization to Construct is valid for a period equal to that of Improvement Permit – not to exceed sixty months.

Signed: date 7-6-04 Installed by: Bob McCarver

Improvement Permit by: RS date 6/29/04 Operation Permit by: RS date 9/13/05

Authorization to Construct by: RS date 7/25/05 Existing System Inspection by: date

HEALTH DEPT. COPY: WHITE OWNER COPY (FINAL): YELLOW OWNER COPY (INITIAL): PINK