# IREDELL COUNTY HEALTH DEPARTMENT

STATESVILLE 704-878-5305 MOORESVILLE 704-664-5281

## IMPROVEMENT PERMIT / AUTHORIZATION TO CONSTRUCT / OPERATION PERMIT / EXISTING SYSTEM INSPECTION

PERMIT# 119509 PIN# 4625505104.408 4626470990 DATE 3-29-07

OWNER OR APPLICANT Jasper Builders PHONE: Business 799-9982 Home

ADDRESS 804 N. Main St. Mooresville, NC

LOCATION Brawley School Rd, TR McKendree Tl Bayberry on left before Kemp

SUBDIVISION The Farms BLOCK / SECTION 3 LOT 408 LOT AREA 1.36 Acre SITE CLASS PS DESIGN FLOW 480gpd L.T.A.R. .3

Septic Tank: 1000 Gallons: STB 3444 Date 3/29/07

Pump Tank: 1000 Gallons: PT 2433 Date 6/2/07

Pump Make: Gorlds Model WE05T7MV Serial No.

Nitrification Field: No Fields 1 Square Feet 1200' Linear Feet 400'

No Lines *400 100' Trench Width 36" Max Trench Bottom Depth 36" Gravel Depth N/A

☒ New System ☐ Repair ☐ Expansion System Type: I II III IV V VI

System Description: Pump - 25% Reduction

Repair System Description: Pump / 25-50% Reduct

Maintenance Agreement Required: ☐ Yes ☒ No

☒ House/Mod. ☐ Mobile Home ☐ Business ☐ Other No. Bedrooms 4 No. Persons No. Employees

Water Supply: ☐ Individual ☐ Public ☒ Community


☐ Gravity ☒ Pressure ☐ Slab ☒ Crawl Space ☐ Basement w/plumbing ☐ Basement wo/plumbing

Comments/Conditions: *Note: Okay to installed 3 lines @ 133 ft each


Comments/Conditions: - Inf. trailer installed - JA 7/6/07 (Quick 4's)

*New Tank location - supply line buried >30" under driveway

INITIAL SITE SKETCH Scale 1:50

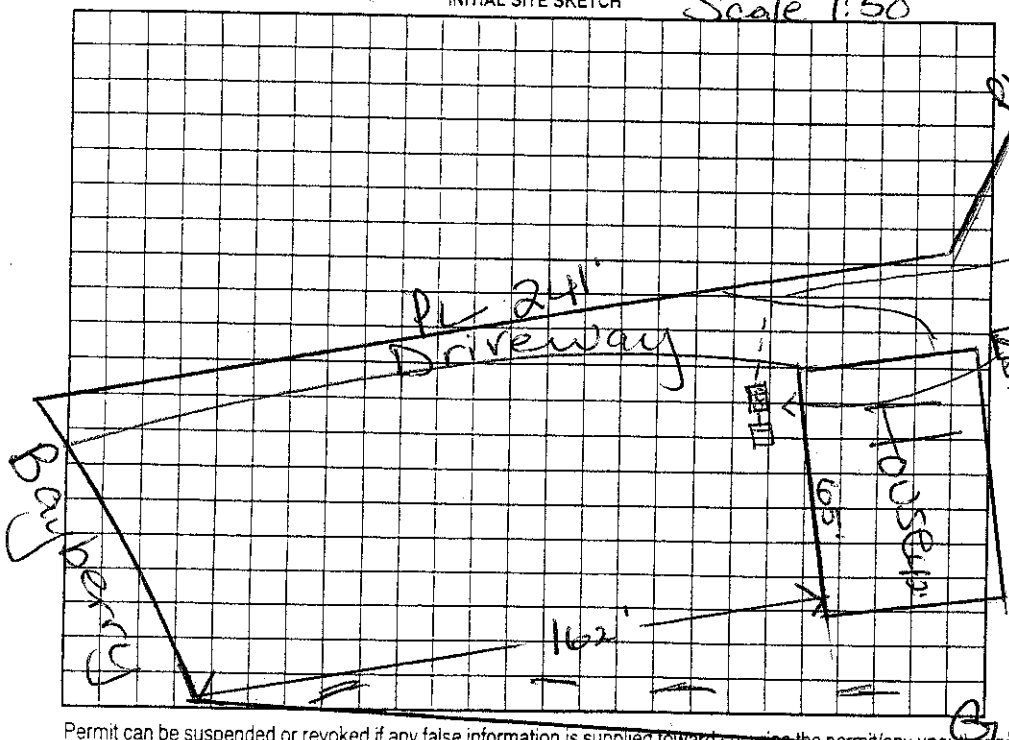


AS BUILT SKETCH Elect & alarm 8/29/07

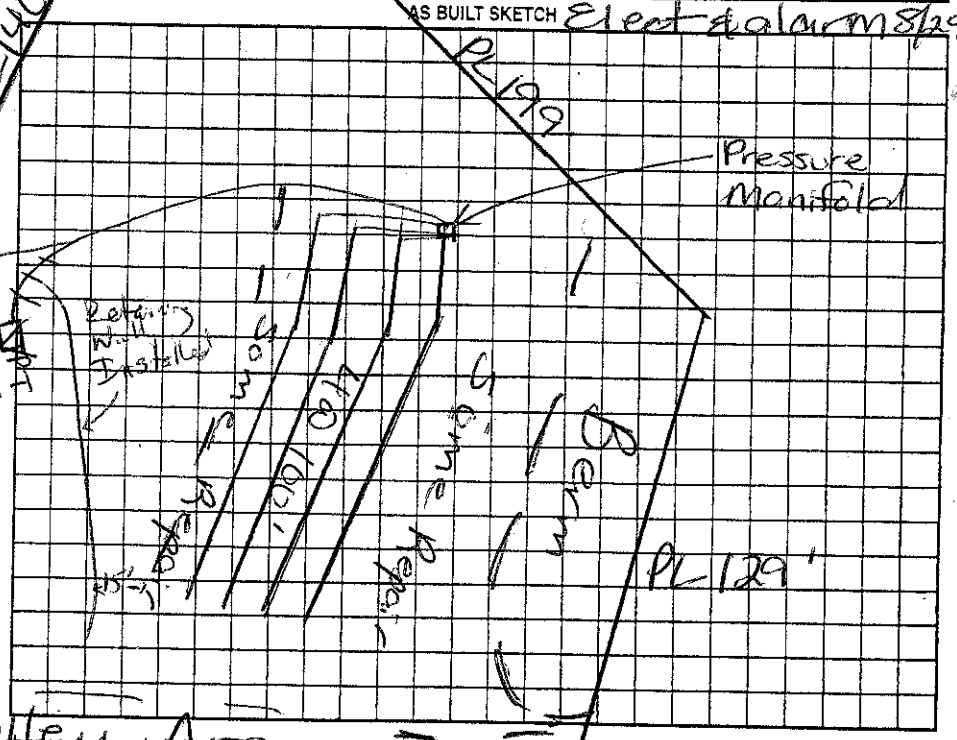


Permit can be suspended or revoked if any false information is supplied toward securing the permit/any unauthorized changes are made to the site/any unauthorized changes are made in the installation of the system. Improvement Permit with plat valid without expiration ☐ Improvement Permit with site plan valid for sixty months ☐ Authorization to Construct is valid for a period equal to that of Improvement Permit – not to exceed sixty months.

Signed: Jerri Crawley date 4-2-07

Improvement Permit by: Maria H. Dotson RS date 3/29/07

Authorization to Construct by: Maria H. Dotson RS date 3/29/07

Installed by: Richard Abernathy

Operation Permit by: Wesley Sparks RS date 9/14/07

Existing System Inspection by: date

HEALTH DEPT. COPY: WHITE OWNER COPY (FINAL): YELLOW OWNER COPY (INITIAL): PINK