IREDELL COUNTY HEALTH DEPARTMENT

STATESVILLE 704-878-5305 MOORESVILLE 704-664-5281

IMPROVEMENT PERMIT / AUTHORIZATION TO CONSTRUCT / OPERATION PERMIT / EXISTING SYSTEM INSPECTIO

130.00 Pd 3/30

PERMIT# 124749 PIN# 4625-50-5104.404 4626473567

OWNER OR CONTRACTOR The Farms LLC / ES Johnson PHONE: Business

ADDRESS 3214 Brawley School Rd. Mooresville N.C. 28117 Home

LOCATION Brawley School Rd TR McKendree TL Kemp TL Grove Creek Lane 2nd lot on left DATE May 3, 2005

SUBDIVISION The Farms BLOCK / SECTION LOT 404 LOT AREA .930 Ac SITE CLASS P5 DESIGN FLOW 440 gpd L.T.A.R. 3

Septic Tank: 1000 Gallons; STB 338 Date 9-2-05

Pump Tank: 1000 Gallons; PT 27 Date 8-11-06

Pump Make: Myers Model ME50 Serial No.

Nitrification Field: No Fields 1 Square Feet 1200 Linear Feet 400

No Lines 3 Trench Width 36" Max Trench Bottom Depth 36" Gravel Depth NA

☒ New System ☐ Repair System Type: I, II, III, IV, V, VI

System Description: pm -25% Reduction

Repair System Description: pm/LP -25-50% Reduction

Maintenance Agreement Required: ☐ Yes ☒ No

☒ House/Mod. Home No. Bedrooms 4

☐ Mobile Home No. Bathrooms

☐ Business No. Employees

☐ Other

☐ Slab ☒ Crawl Space ☐ Basement w/plumbing ☐ Basement wo/plumbing


Water Supply: ☐ Individual ☒ Public ☒ Community

Comments/Conditions:


Comments/Conditions:
Tollgate Installed "Quick 4" as drawn
Checked tanks & lines 10/4/06
Checked pressure, elect & alarm 2/20/07

1"=50'

INITIAL SITE SKETCH

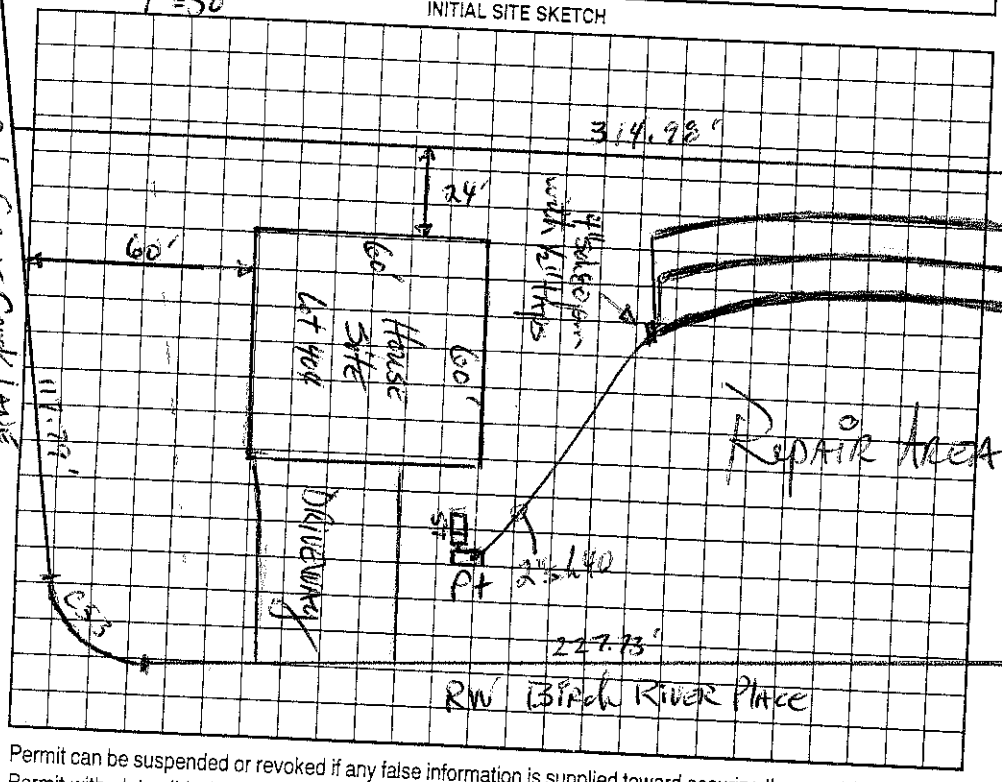

AS BUILT SKETCH

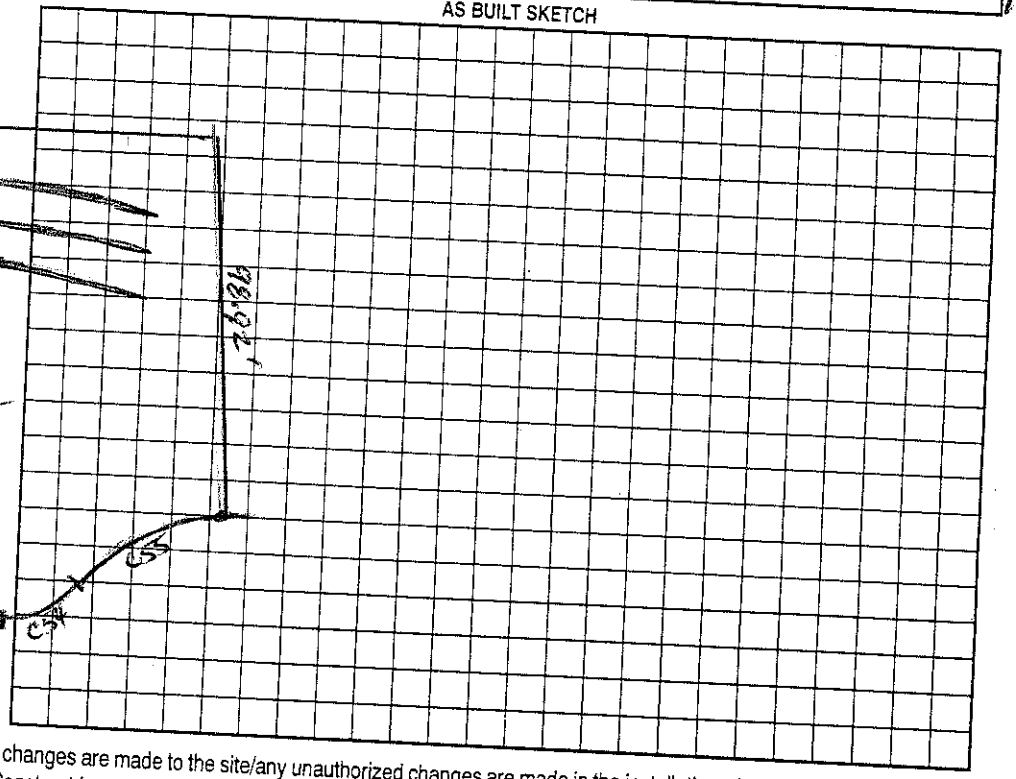

Permit can be suspended or revoked if any false information is supplied toward securing the permit/any unauthorized changes are made to the site/any unauthorized changes are made in the installation of the system. Improvement Permit with plat valid without expiration. Improvement Permit with site plan valid for sixty months. Authorization to Construct is valid for a period equal to that of Improvement Permit – not to exceed sixty months.

Signed: Kathleen Sawyer

Improvement Permit by: date 5/6/05

Authorization to Construct by: Judy Mundy date 5-3-05

Installed by: Willie Chanstanbury date 4-10-06

Operation Permit by: Marvin Tolson date 2/20/07

Existing System Inspection by: date

HEALTH DEPT. COPY: WHITE OWNER COPY (FINAL): YELLOW OWNER COPY (INITIAL): PINK