130.00 Paid

IREDELL COUNTY HEALTH DEPARTMENT

Redraw

STATESVILLE 704-878-5305 MOORESVILLE 704-664-5281

IMPROVEMENT PERMIT / AUTHORIZATION TO CONSTRUCT / OPERATION PERMIT / EXISTING SYSTEM INSPECTION

PERMIT# 124745 PIN# 4625-50-5104.400 4626-47-7662 DATE 8/27/07

OWNER OR APPLICANT The Farms LLC / Helms Bldrs. Inc. PHONE: Business _____ Home _____

ADDRESS 2214 Brawley Sch. Rd Mooresville NC 28117

LOCATION Brawley Sch Rd. TR McLendree TL Kemp TL Grove Creek Ln TL Birch River Place on right at end.

SUBDIVISION The Farms BLOCK / SECTION 3 LOT 400 LOT AREA 1.144 ac SITE CLASS. PS DESIGN FLOW 480 L.T.A.R. .3

Septic Tank: 1000 Gallons: STB 338 Date 11/5/07

Pump Tank: 1000 Gallons: PT 29 Date 11/6/07

Pump Make: Meads Model ME-50-S-21 Serial No. _____

Nitrification Field: No. Fields 1 Square Feet 1200 Linear Feet 400

No Lines 4@100' Trench Width 36" Max Trench Bottom Depth 36" Gravel Depth NA ☐ Gravity ☐ Pressure

☑ New System ☐ Repair ☐ Expansion System Type: I II (III) IV V VI

System Description: PM 25% Reduction

Repair System Description: Same

Maintenance Agreement Required: ☐ Yes ☑ No

☑ House/Mod. Home ☐ Mobile Home ☐ Business ☐ Other

No. Bedrooms 4 No. Persons ____ No. Employees ____

Water Supply: ☐ Individual ☑ Public ☑ Community

☐ Slab ☑ Crawl Space ☐ Basement w/plumbing ☐ Basement wo/plumbing


Comments:/Conditions:

Comments:/Conditions: Infiltration chamber


Electrical checked 2/1/08

1"=50'

INITIAL SITE SKETCH

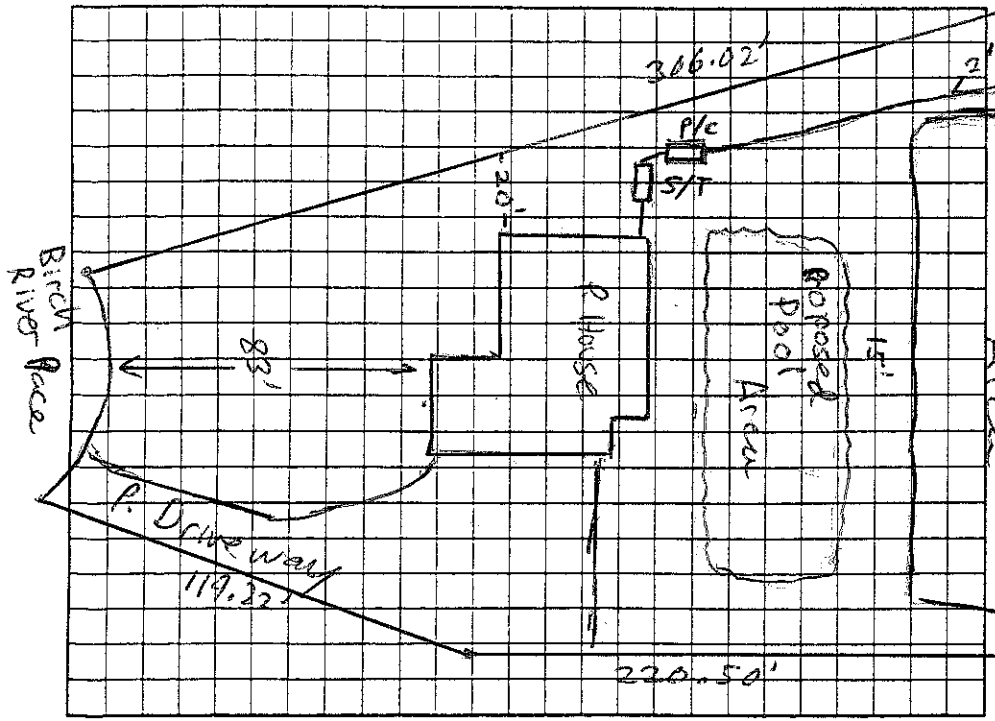

AS BUILT SKETCH

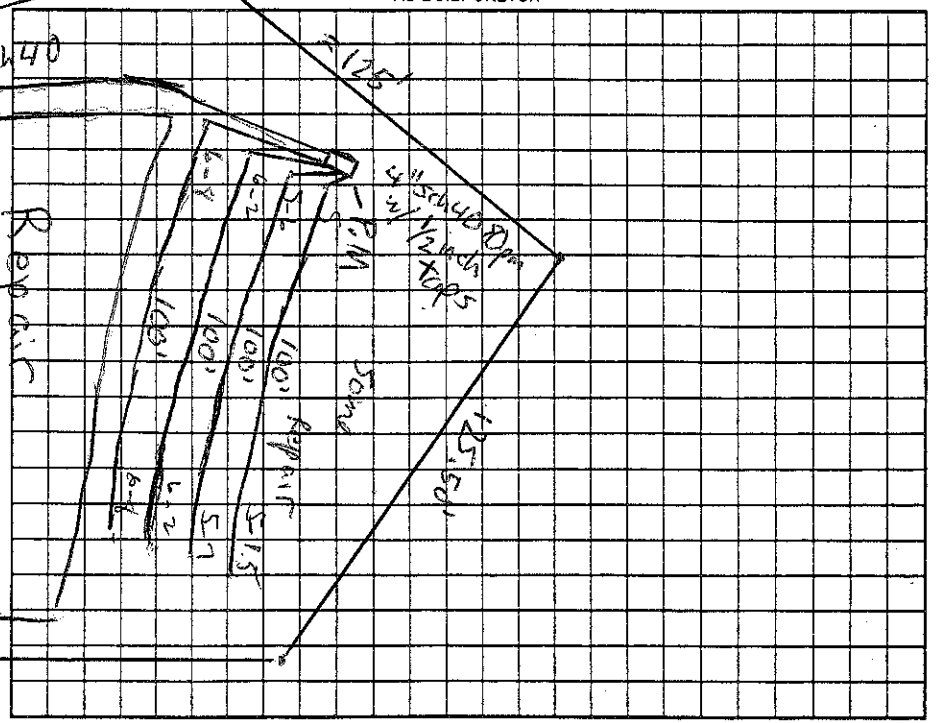

Permit can be suspended or revoked if any false information is supplied toward securing the permit/any unauthorized changes are made to the site/any unauthorized changes are made in the installation of the system. Improvement Permit with plat valid without expiration ☐ Improvement Permit with site plan valid for sixty months ☑ Authorization to Construct is valid for a period equal to that of Improvement Permit – not to exceed sixty months.

Signed: _____ date 8/29/07 Installed by: Tankard Septic

Improvement Permit by: Anthony Cokers Jr. date 8/27/07 Operation Permit by: Anthony Cokers Jr date 2/1/08

Authorization to Construct by: Anthony Cokers Jr date 8/27/07 Existing System Inspection by: _____ date _____

HEALTH DEPT. COPY: WHITE OWNER COPY (FINAL): YELLOW OWNER COPY (INITIAL): PINK