IREDELL COUNTY HEALTH DEPARTMENT

STATESVILLE 704-878-5305 MOORESVILLE 704-664-5281 130

IMPROVEMENT PERMIT / AUTHORIZATION TO CONSTRUCT / OPERATION PERMIT / EXISTING SYSTEM INSPECTION

PERMIT# 11960 PIN# ~~4625 50 5164. 415~~ 4626481589 DATE 1/4/05

OWNER OR CONTRACTOR THE FARMS LLC / T. Whelan Home PHONE: Business _____ Home _____

ADDRESS 2214 BRAWLEY SCHOOL RD MOORESVILLE NC 28115

LOCATION BRAWLEY SCHOOL - TR McKENDREE - ~~TR~~ - TR BAYBERRY - TL EWART - AT END

SUBDIVISION THE FARMS BLOCK / SECTION 3 LOT 415 LOT AREA ~~2.0~~ 1 AC SITE CLASS. CS DESIGN FLOW ~~440~~ 330 L.T.A.R. .25 ~~.20~~ .25

Septic Tank: ~~1000~~ 1500 Gallons; STB 338 Date 9/10/05

Pump Tank: _____ Gallons; PT _____ Date _____

Pump Make: _____ Model _____ Serial No. _____

Nitrification Field: No Fields 1 Square Feet 1500 Linear Feet 500

No Lines 5 @ 100' Trench Width 36" Max Trench Bottom Depth 36" Gravel Depth N/A

☑ New System ☐ Repair System Type: I, II, III, IV, V, VI

System Description: GRAVITY 25% REDUCTION

Repair System Description: PUMP 25% REDUCTION

Maintenance Agreement Required: ☐ Yes ☑ No

☑ House/Mod. Home No. Bedrooms 4

☐ Mobile Home No. Bathrooms 4

☐ Business No. Employees _____

☐ Other _____


☐ Slab ☑ Crawl Space ☐ Basement w/plumbing ☐ Basement wo/plumbing

Water Supply: ☐ Individual ☐ Public ☒ Community


Comments/Conditions: Reviewed Building plans & site plan; in compliance with I.P. Drive on other side

Comments/Conditions: ST W/ RISERS AND POLY LOK FITTINGS INSTALLED AS DRAWN WITH 12.5 QUICK-4 INFILTRATORS

1"=50' INITIAL SITE SKETCH

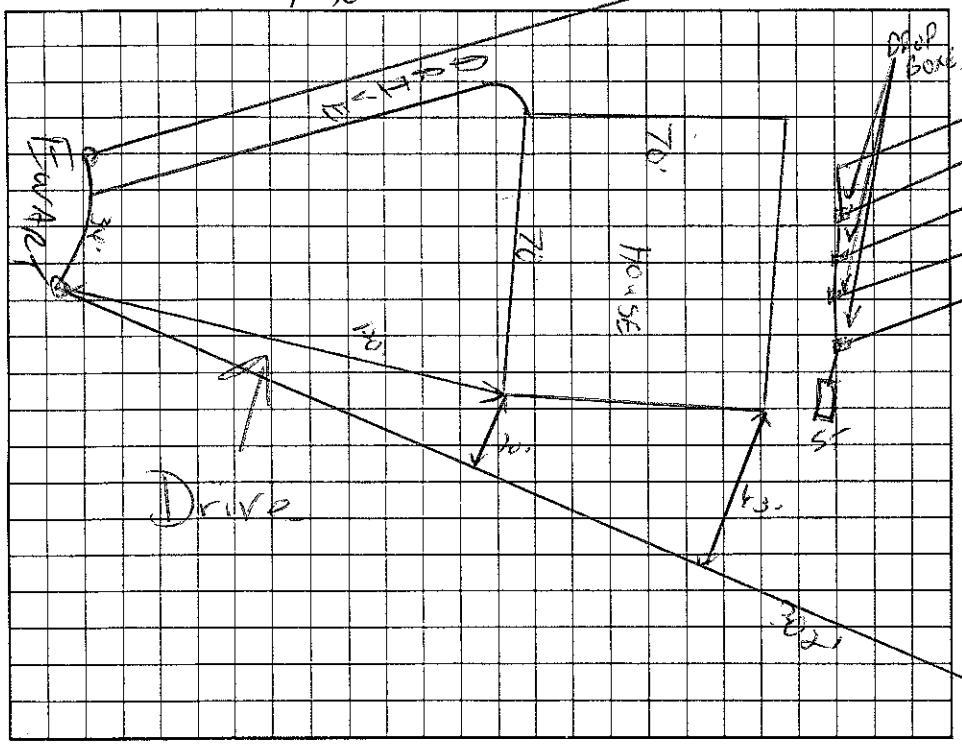

AS BUILT SKETCH

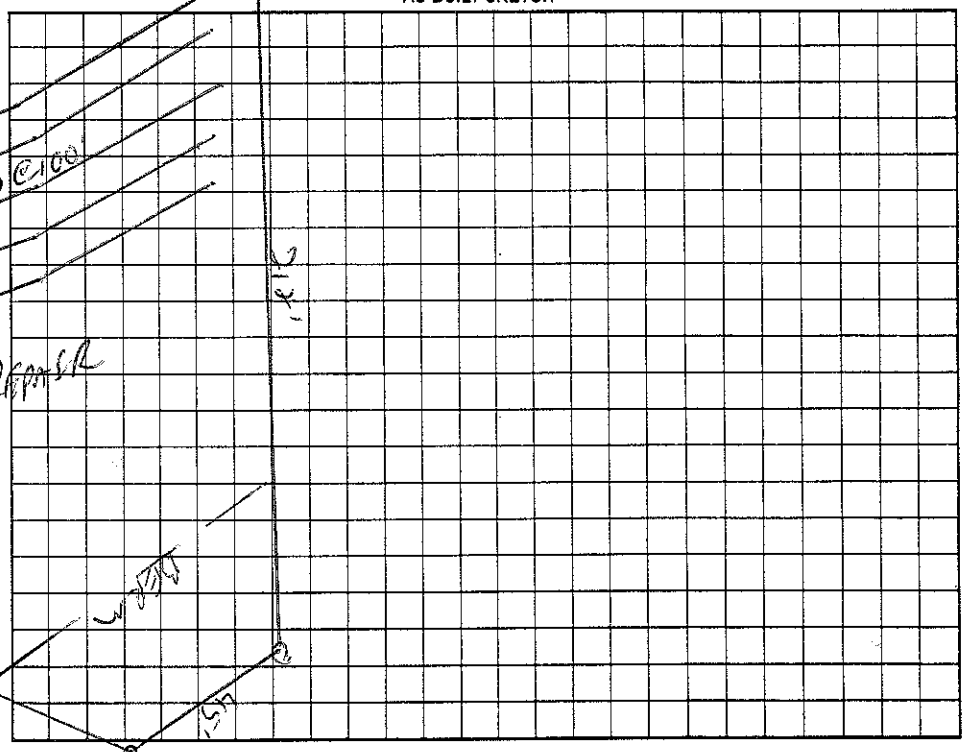

Permit can be suspended or revoked if any false information is supplied toward securing the permit/any unauthorized changes are made to the site/any unauthorized changes are made in the installation of the system. Improvement Permit with ~~that~~ valid without expiration. Improvement Permit with site plan valid for sixty months. Authorization to Construct is valid for a period equal to that of Improvement Permit – not to exceed sixty months.

Signed: _____ date 2-24-05 Installed by: LARRY BEAN GRADING

Improvement Permit by: _____ date 1/4/05 Operation Permit by: _____ date 10/27/05

Authorization to Construct by: _____ date 7/25/05 Existing System Inspection by: _____ date _____

HEALTH DEPT. COPY: WHITE OWNER COPY (FINAL): YELLOW OWNER COPY (INITIAL): PINK