IREDELL COUNTY HEALTH DEPARTMENT

STATESVILLE 704-878-5305 195.00 Paid MOORESVILLE 704-664-5281

IMPROVEMENT PERMIT / AUTHORIZATION TO CONSTRUCT / OPERATION PERMIT / EXISTING SYSTEM INSPECTION

PERMIT# 19520 PIN# 4626482102 DATE 9/29/05

OWNER OR CONTRACTOR The Hoke Company PHONE: Business 799-7495 Home 201-0264

ADDRESS P.O. Box 4448 Mooresville NC 28117

LOCATION Brawley School Rd TR McKendree TL Kemp TR Alder Springs TR Bayberry Creek TR Ewart Place

SUBDIVISION The Farms BLOCK / SECTION 3 LOT 411 LOT AREA .97 Acre SITE CLASS PS DESIGN FLOW 600gpd L.T.A.R. .3 acres

Septic Tank: 1500 Gallons; STB 338 Date 11/19/05

Pump Tank 1500 Gallons; PT 477 Date 11/21/05

Pump Make: Myers Model ME50 Serial No.

Nitrification Field: No Fields 1 Square Feet 1005' Linear Feet 335'

No Lines 3 Trench Width 24"-36" Max Trench Bottom Depth 36 Gravel Depth N/A

☒ New System ☐ Repair System Type: I, II, III, IV, V, VI

System Description: Pump-LP-Panel Block

Repair System Description: Same

Maintenance Agreement Required: ☒ Yes ☐ No

☒ House/Mod. Home No. Bedrooms 5

☐ Mobile Home No. Bathrooms 4

☐ Business No. Employees

☐ Other


☐ Slab ☒ Crawl Space ☐ Basement w/plumbing ☐ Basement wo/plumbing

Water Supply: ☐ Individual ☒ Public ☐ Community

Comments:/Conditions: Do Not Cut House Pad.

Comments:/Conditions: Note: Any Future pool must be 15' from Septic System (including Repair Area) Pressure Sheet & Alarm 5/4/06

INITIAL SITE SKETCH

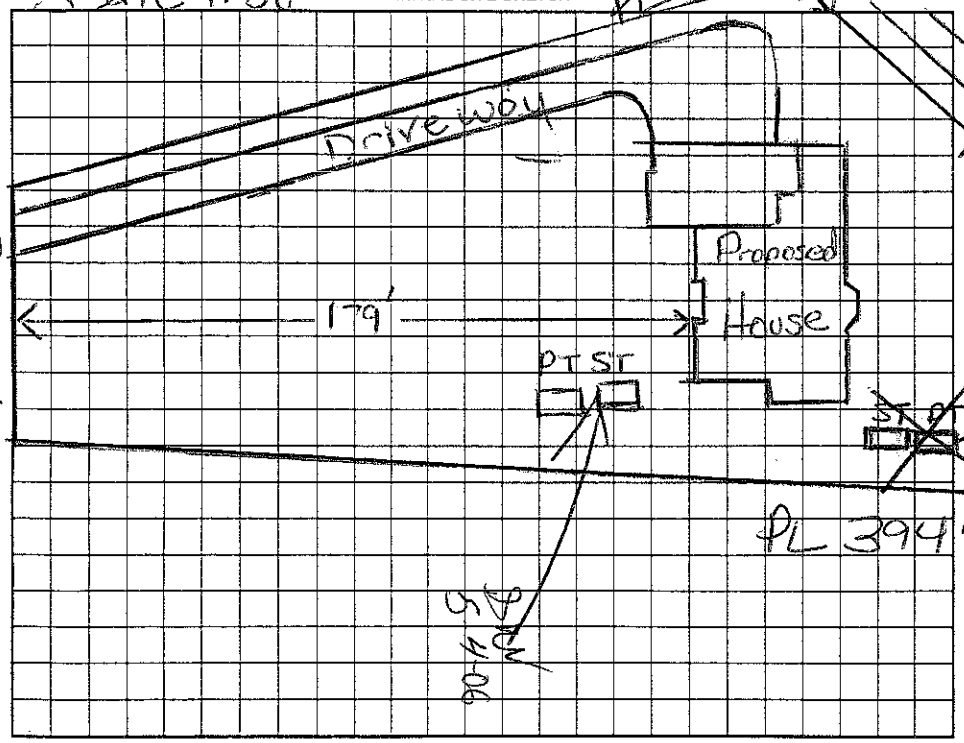

AS BUILT SKETCH

Tanks & Top 2 lines checked by GM
Lower line Checked by MD

Permit can be suspended or revoked if any false information is supplied toward securing the permit/any unauthorized changes are made to the site/any unauthorized changes are made in the installation of the system. Improvement Permit with plat valid without expiration. Improvement Permit with site plan valid for sixty months. Authorization to Construct is valid for a period equal to that of Improvement Permit – not to exceed sixty months.

Signed: Dan Clark date 9/30/05 Installed by: R+H

Improvement Permit by: Maria H Dolson RS date 9/29/05 Operation Permit by: Maria H Dolson RS date 5/4/06

Authorization to Construct by: Maria H Dolson RS date 9/29/05 Existing System Inspection by: date

HEALTH DEPT. COPY: WHITE OWNER COPY (FINAL): YELLOW OWNER COPY (INITIAL): PINK