Site Address: 131 Silver Lake Trail, Mrsvl.

IREDELL COUNTY HEALTH DEPARTMENT

STATESVILLE 704-878-5305 MOORESVILLE 704-664-5281

IMPROVEMENT PERMIT / AUTHORIZATION TO CONSTRUCT / OPERATION PERMIT / EXISTING SYSTEM INSPECTION

PERMIT# 1396646 208214 PIN# ~~4625581913.555~~ 4626488769 ✓ DATE 4-20-07

OWNER OR APPLICANT The Farms LLC / JS Testa PHONE: Business _____ Home _____

ADDRESS 2214 Brawley School Rd Mooresville NC 28117

LOCATION Brawley School Rd TR McKendree TR Digh Circle TR Montclair TR Silver Lake Trail at end

SUBDIVISION The Farms BLOCK / SECTION 5 LOT 555/~~555A~~ LOT AREA 1.08 Ac SITE CLASS. PS DESIGN FLOW 480 gpd L.T.A.R. .3 gpd/ft², .25 repair

Septic Tank: 1500 # Gallons: STB 338 Date _____

Pump Tank: 1500 # Gallons: PT 283 Date _____

Pump Make: Goulds Model WE05 12HHU Serial No. _____

Nitrification Field: No Fields 1 Square Feet 1200 Linear Feet 400

No Lines 4 @ 100' Trench Width 36" Max Trench Bottom Depth 36" Gravel Depth NA ☐ Gravity ☑ Pressure

☑ New System ☐ Repair ☐ Expansion System Type: I II III IV V VI

System Description: 25% reduction pm Offsite

Repair System Description: LP PPBPS

Maintenance Agreement Required: ☐ Yes ☑ No

☑ House/Mod. Home ☐ Mobile Home ☐ Business ☐ Other

No. Bedrooms 4 No. Persons 8 No. Employees ____

Water Supply: ☐ Individual ☑ Public ☑ Community

☐ Slab ☐ Crawl Space ☑ Basement w/plumbing ☐ Basement wo/plumbing

Comments/Conditions:
* Per plan specs
System on easement 609-555A
Repair on easement 609-555A & 616-555A
Before AC verify elevations

INITIAL SITE SKETCH

See Plan from SY ME

Comments/Conditions: Drainfield located "offsite"
2/2/15 Reviewed Floor plans, house is slightly larger than orginal plan but should still work, dwelling Drainfield

AS BUILT SKETCH

located offsite, Typ

CHECKED TANKS 9-11-15 SA
CHECKED SUPPLY LINE 9-17-15 SA

POOL APPROVED BASED ON SITE PLAN
MUST BE MIN. 15' FROM TANKS.
POOL DECK MUST BE 5' FROM TANKS
SA 10-27-15

½ Hp HH PUMP,
WE05 12HHU
BREAKERS CHECKED ALA 11-10-15
PRESSURE HEAD SET 2'


Permit can be suspended or revoked if any false information is supplied toward securing the permit/any unauthorized changes are made to the site/any unauthorized changes are made in the installation of the system. Improvement Permit with plat valid without expiration ☐ Improvement Permit with site plan valid for sixty months ☑ Authorization to Construct is valid for a period equal to that of Improvement Permit – not to exceed sixty months.

Signed: _____ date 4-30-07 Installed by: ABERNATHY


Improvement Permit by: _____ date 4-20-07 Operation Permit by: _____ date 11-10-15

Authorization to Construct by: _____ date 2/2/15 Existing System Inspection by: _____ date _____


HEALTH DEPT. COPY: WHITE OWNER COPY (FINAL): YELLOW OWNER COPY (INITIAL): PINK

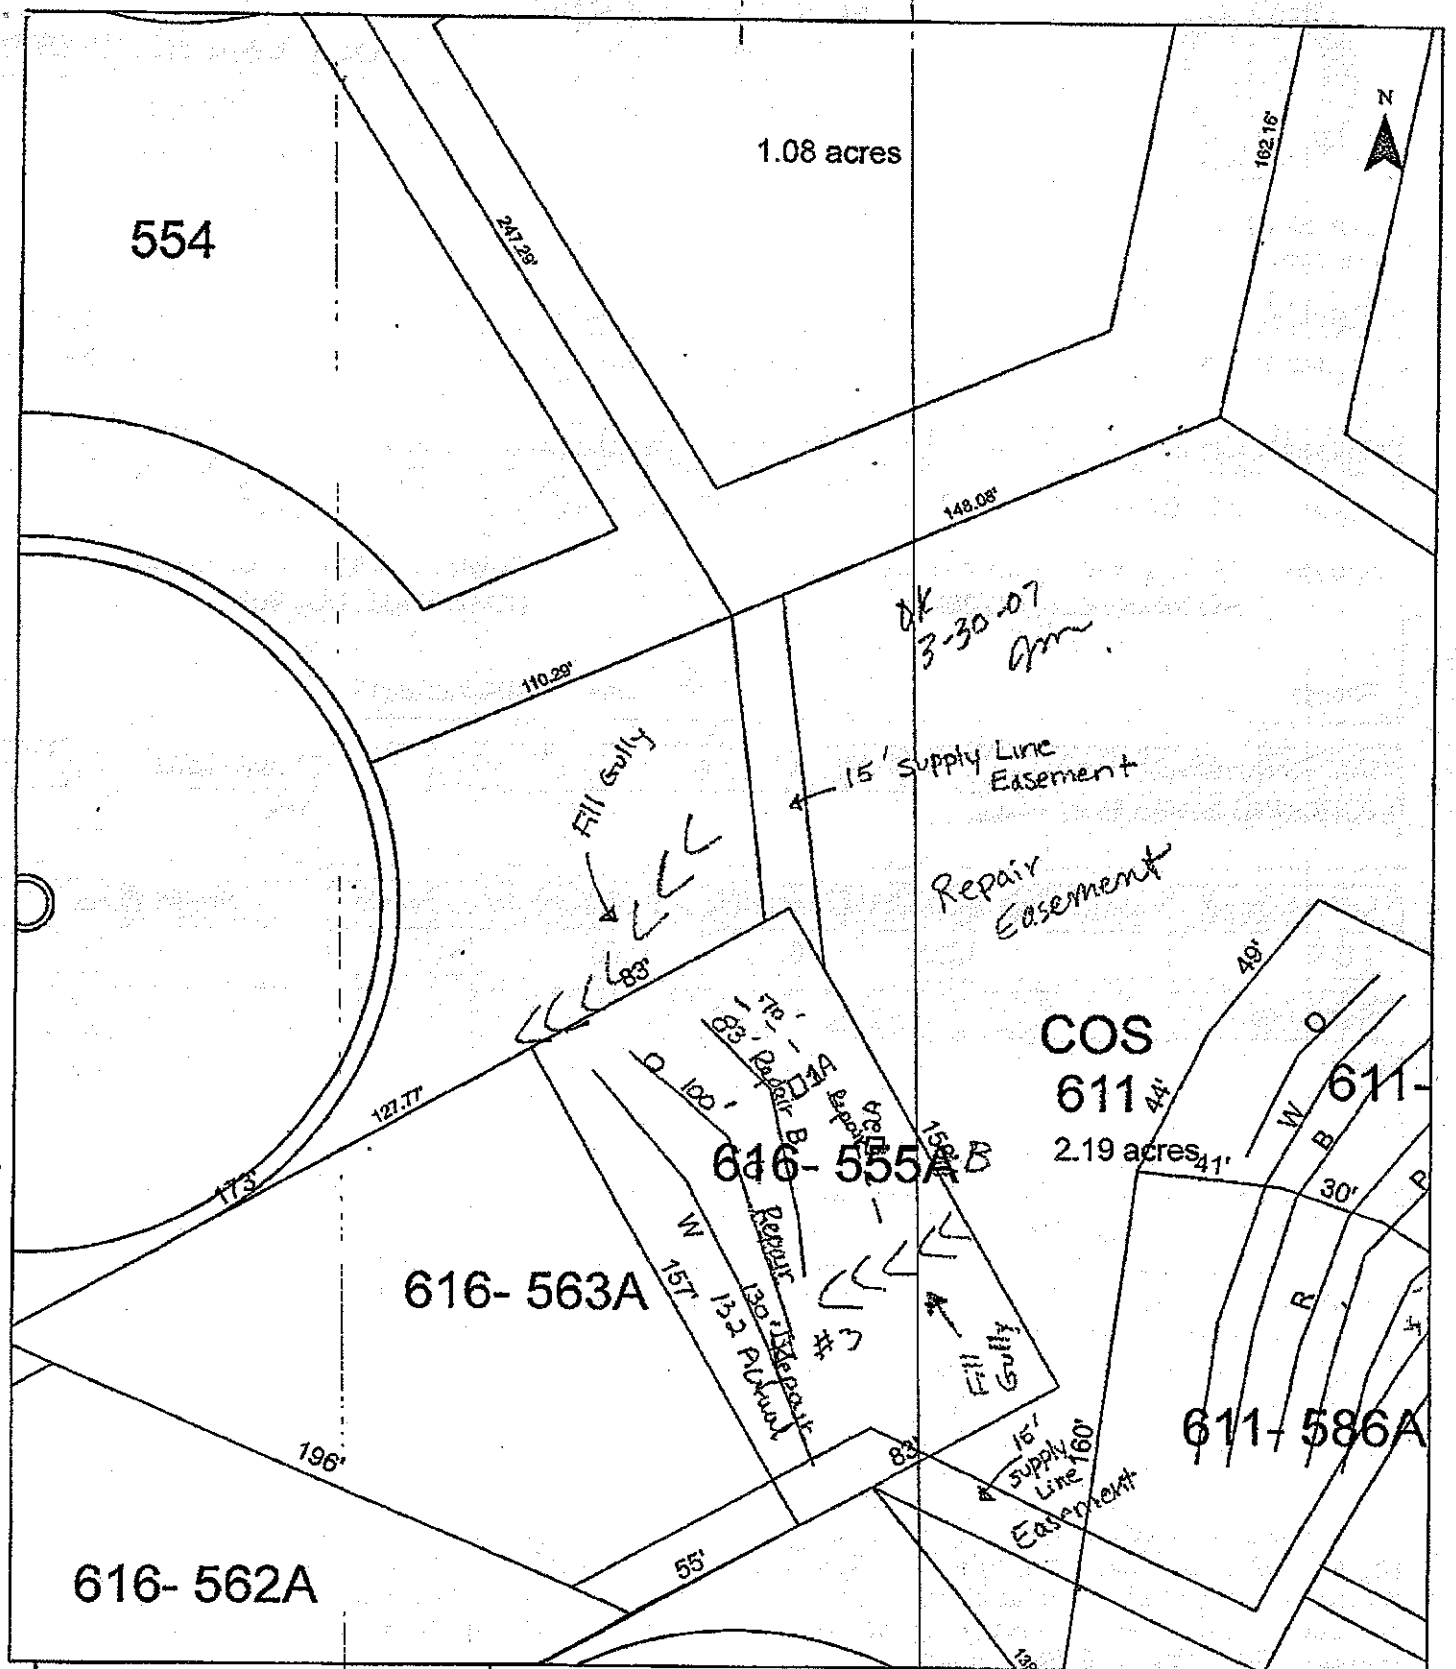

Scale: 1 inch equals 50 feet	S&ME	The Farms - Phase V	FIGURE
Drawn by: JBP		Lot 555	2
Reviewed by: KS		Iredell County, NC	
Date: February, 2007	ENVIRONMENTAL SERVICES • ENGINEERING • TESTING	S&ME Project #1588-05-070	

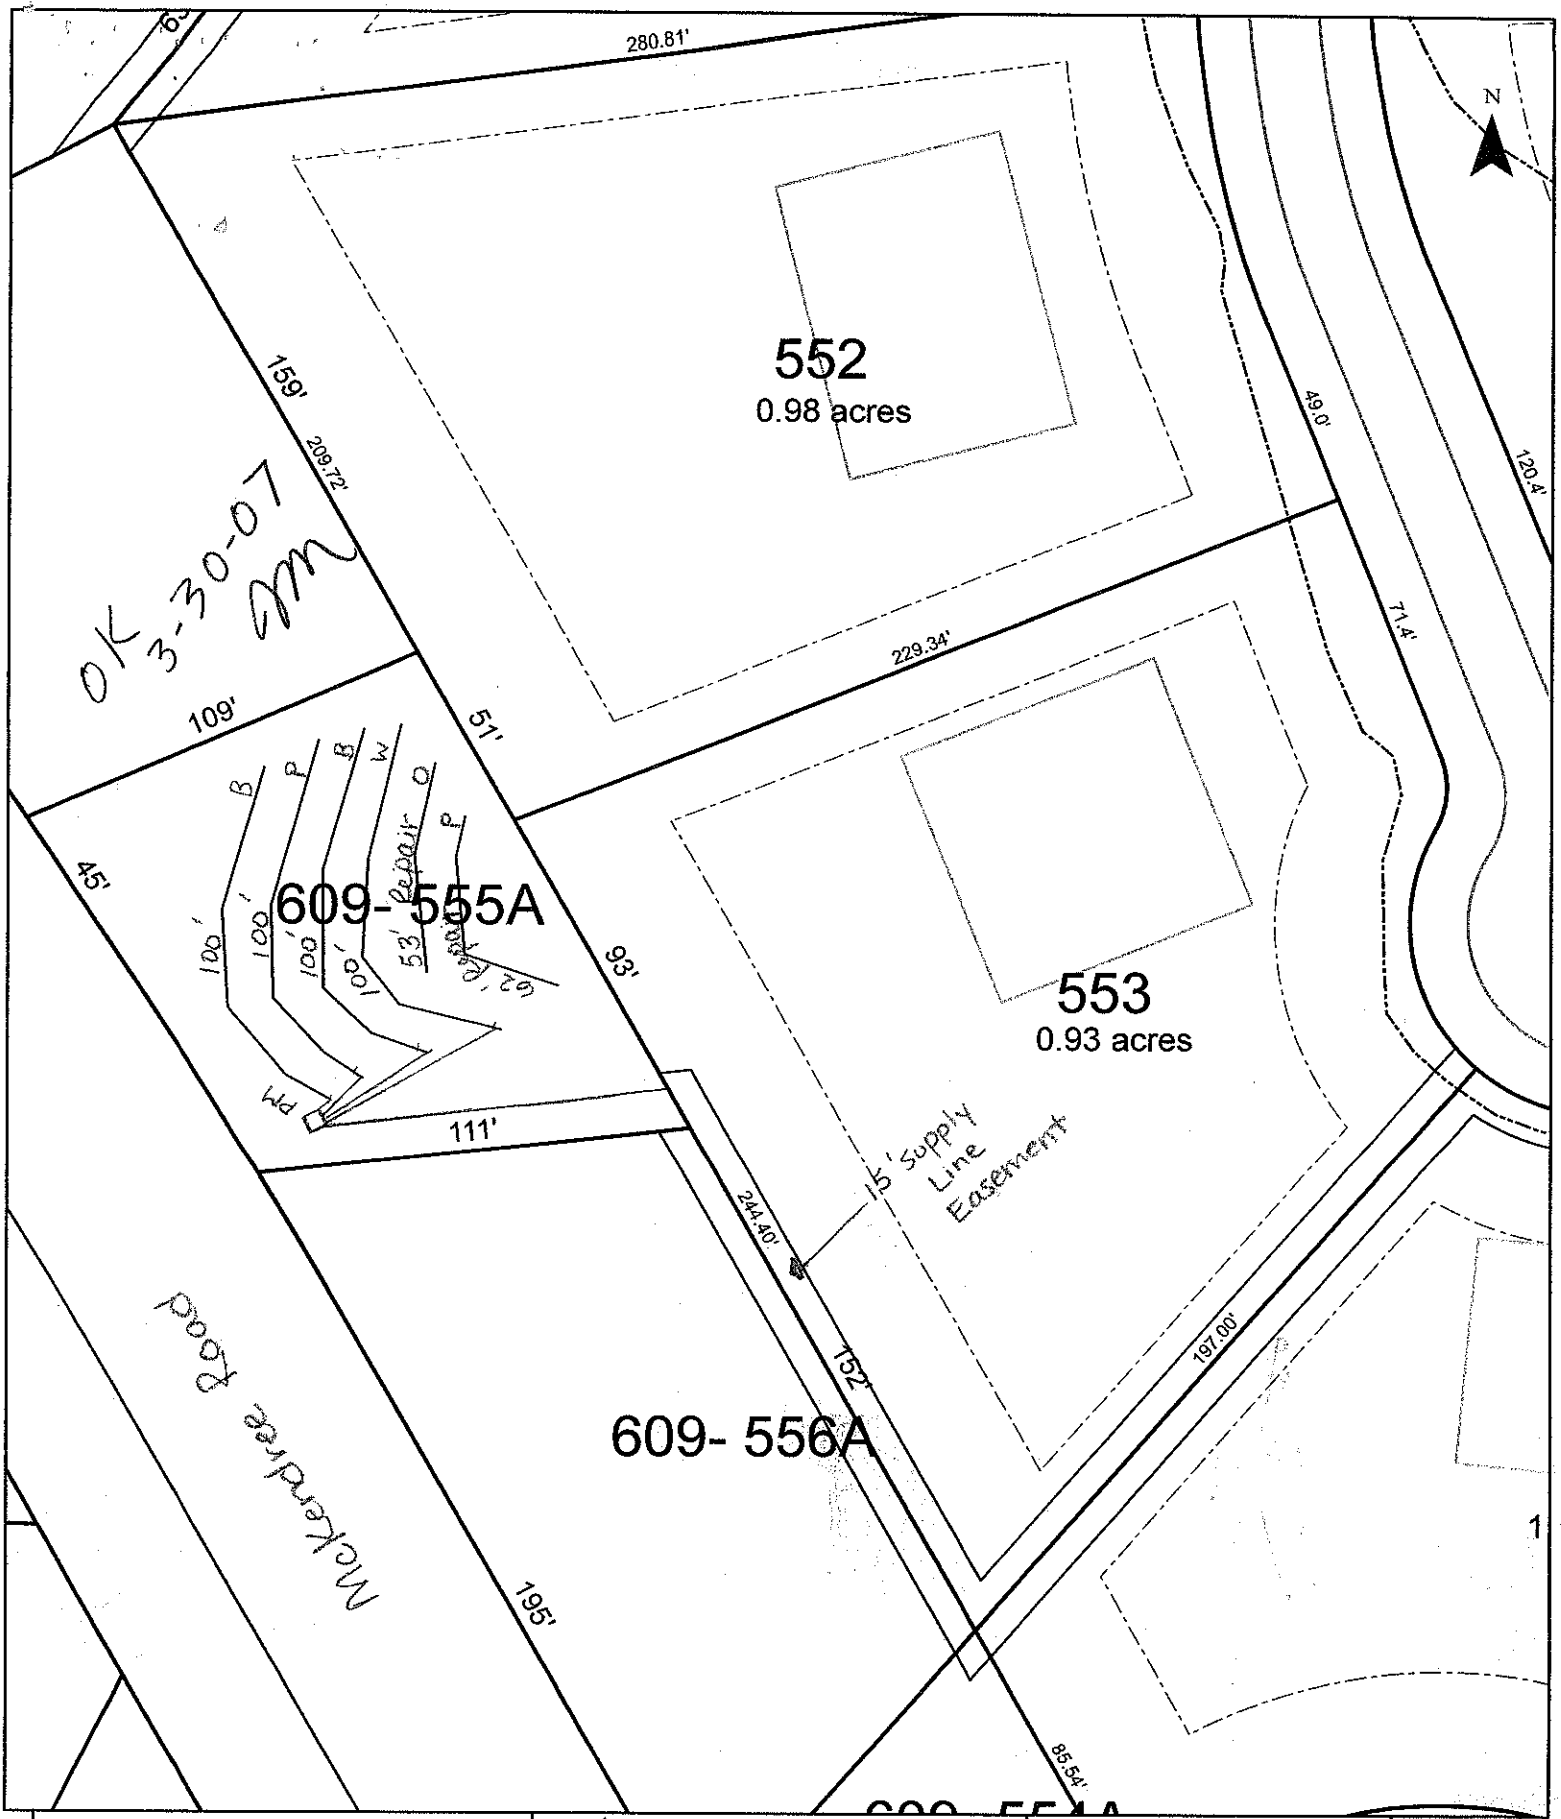

Scale: 1 inch equals 50 feet	S&ME	The Farms - Phase V	FIGURE
Drawn by: JBP		Lot 555	2
Reviewed by: KS		Iredell County, NC	
Date: February, 2007	ENVIRONMENTAL SERVICES • ENGINEERING • TESTING	S&ME Project #1588-05-070	

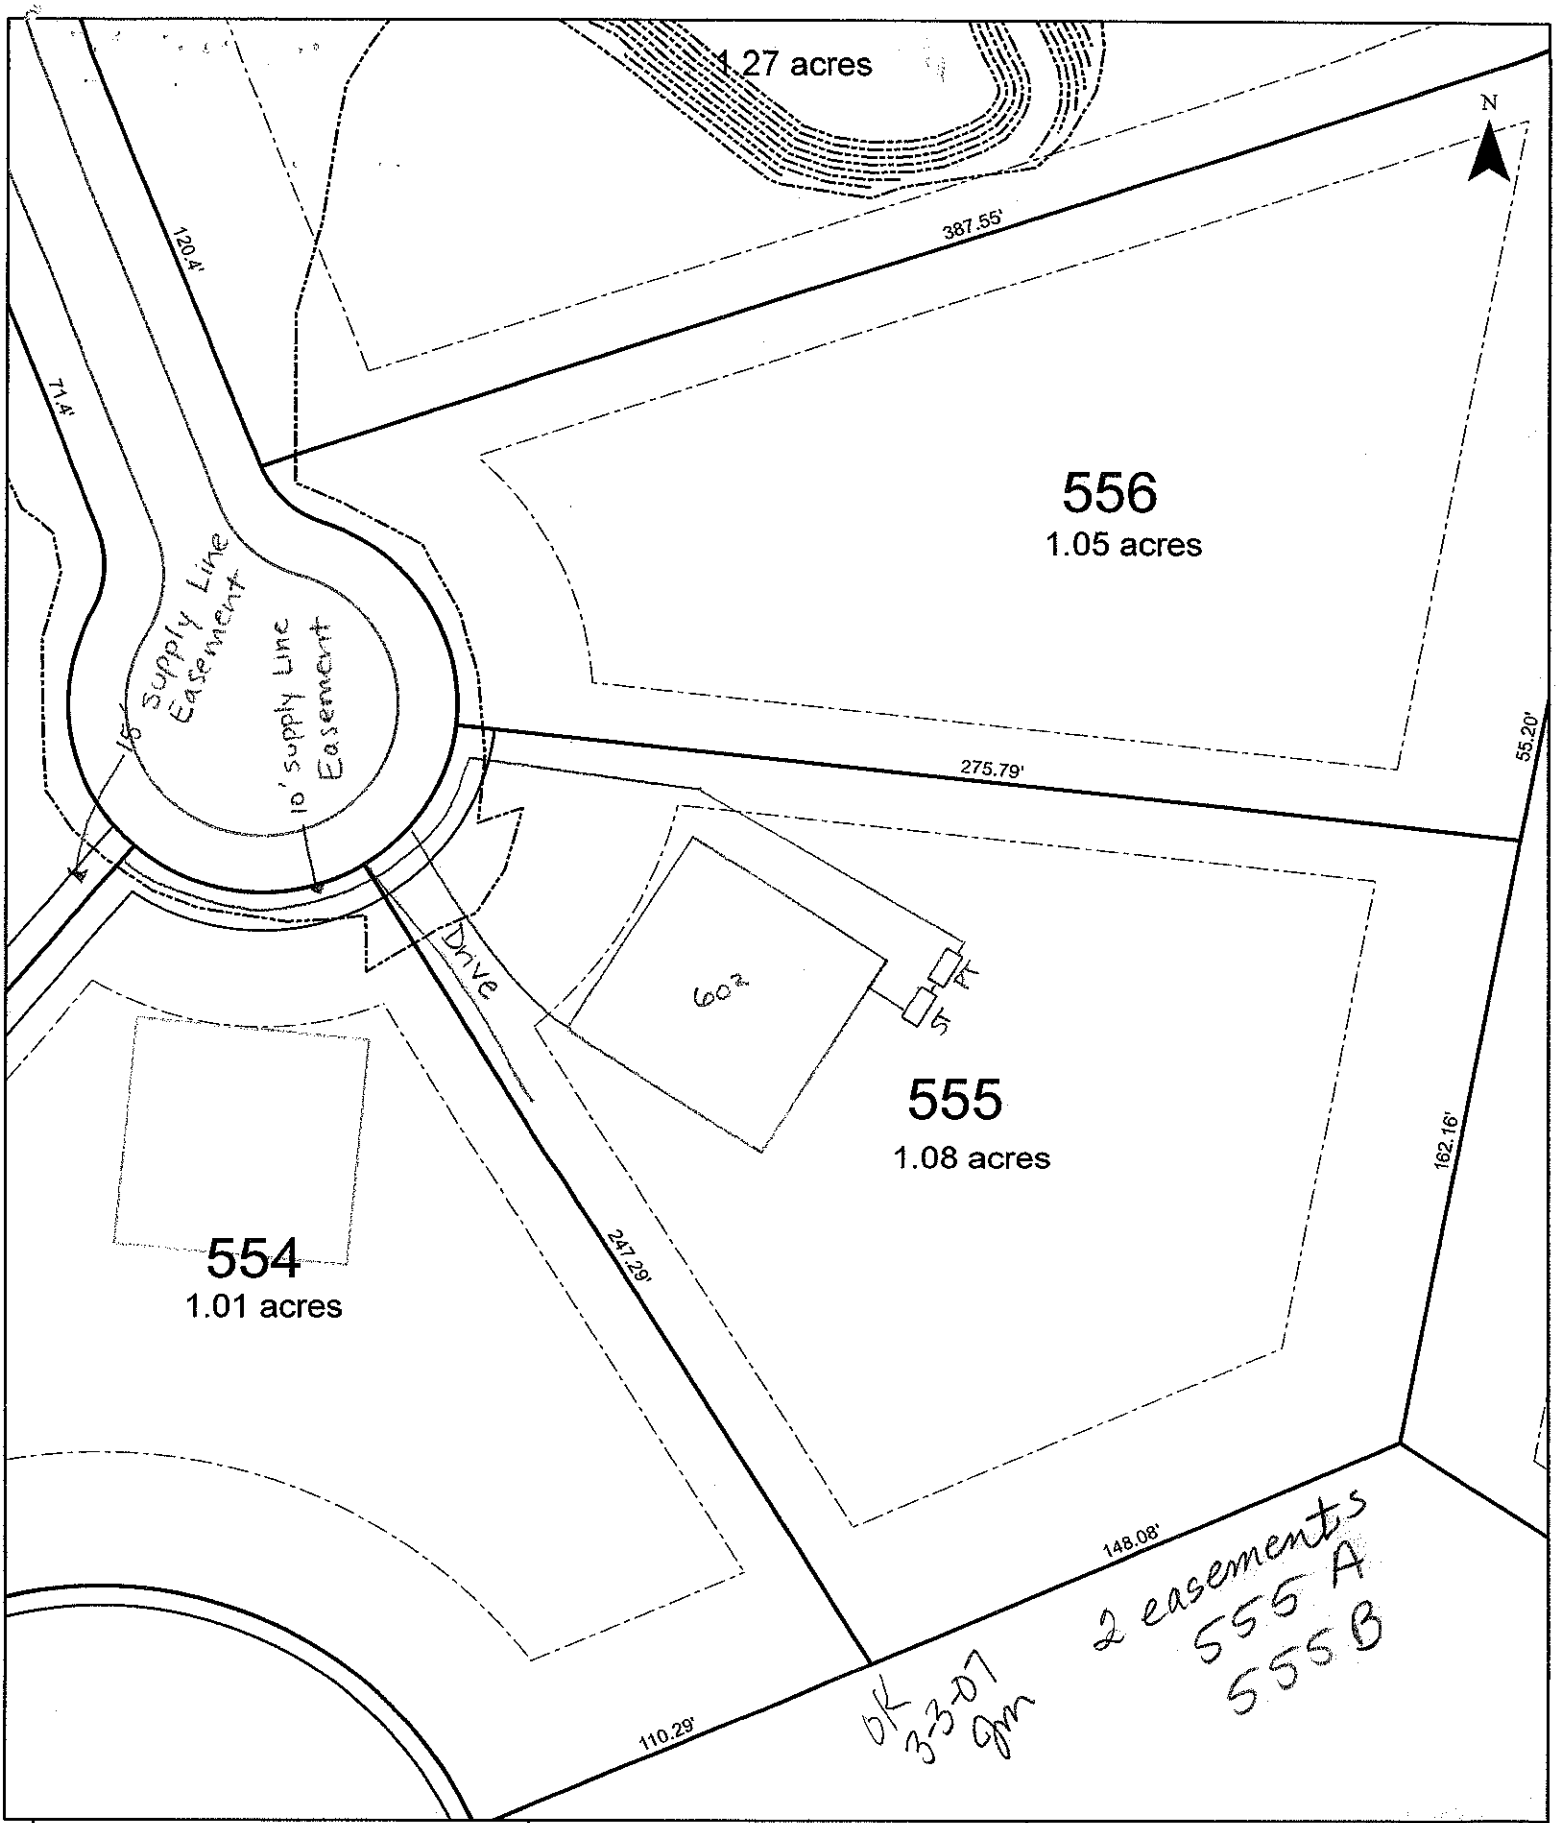

Scale: 1 inch equals 50 feet	S&ME	The Farms - Phase V	FIGURE
Drawn by: JBP		Lot 555	1
Reviewed by: KS		Iredell County, NC	
Date: February, 2007	ENVIRONMENTAL SERVICES · ENGINEERING · TESTING	S&ME Project #1588-05-070	