IMPROVEMENT PERMIT / AUTHORIZATION TO CONSTRUCT / OPERATION PERMIT / EXISTING SYSTEM INSPECTION

4626-49-0311

COPY

...COUNTY HEALTH DEPARTMENT
STATESVILLE 704-878-5305
MOORESVILLE 704-664-5281

PERMIT# 86515 PIN# 4626387480 PT

OWNER OR CONTRACTOR EASTER DEVELOPMENT CORP. PHONE: Business 664-2906

ADDRESS 227 Hideaway Lane Mooresville NC 28117 Home 201-6865

LOCATION R. Brawley School, R. McKendree, R. Dish Creek - CORNER ON DEOH - ON RT DATE 12/14/99

SUBDIVISION Blackberry Creek BLOCK / SECTION 1 LOT 10 LOT AREA .73 ac. SITE CLASS. PS DESIGN FLOW 360 GPD L.T.A.R. 360 PD/AC

Septic Tank: 1000 Gallons; STEP 1000 Date 3-11-00

Pump Tank: Gallons; PT Date

Pump Make: Model Serial No.

Nitrification Field: No Fields 1 Square Feet 900 Linear Feet 300

No Lines 4@75' Trench Width 36" Max Trench Bottom Depth 36"

Comments:/Conditions:

☒ New System ☐ Repair System Type: I, II, III, IV, V, VI

System Description: GRAVITY 35% REDUCTION

Repair System Description: GRAVITY PANEL

Maintenance Agreement Required: ☐ Yes ☒ No

Gravel Depth N/A ☐ Slab ☒ Crawl Space ☐ Basement w/plumbing ☐ Basement wo/plumbing

☒ House/Mod. Home No. Bedrooms 3

☐ Mobile Home No. Bathrooms 2


☐ Business No. Employees

☐ Other

Water Supply: ☒ Individual ☐ Public ☐ Community

Comments:/Conditions:

INITIAL SITE SKETCH 1"=100'

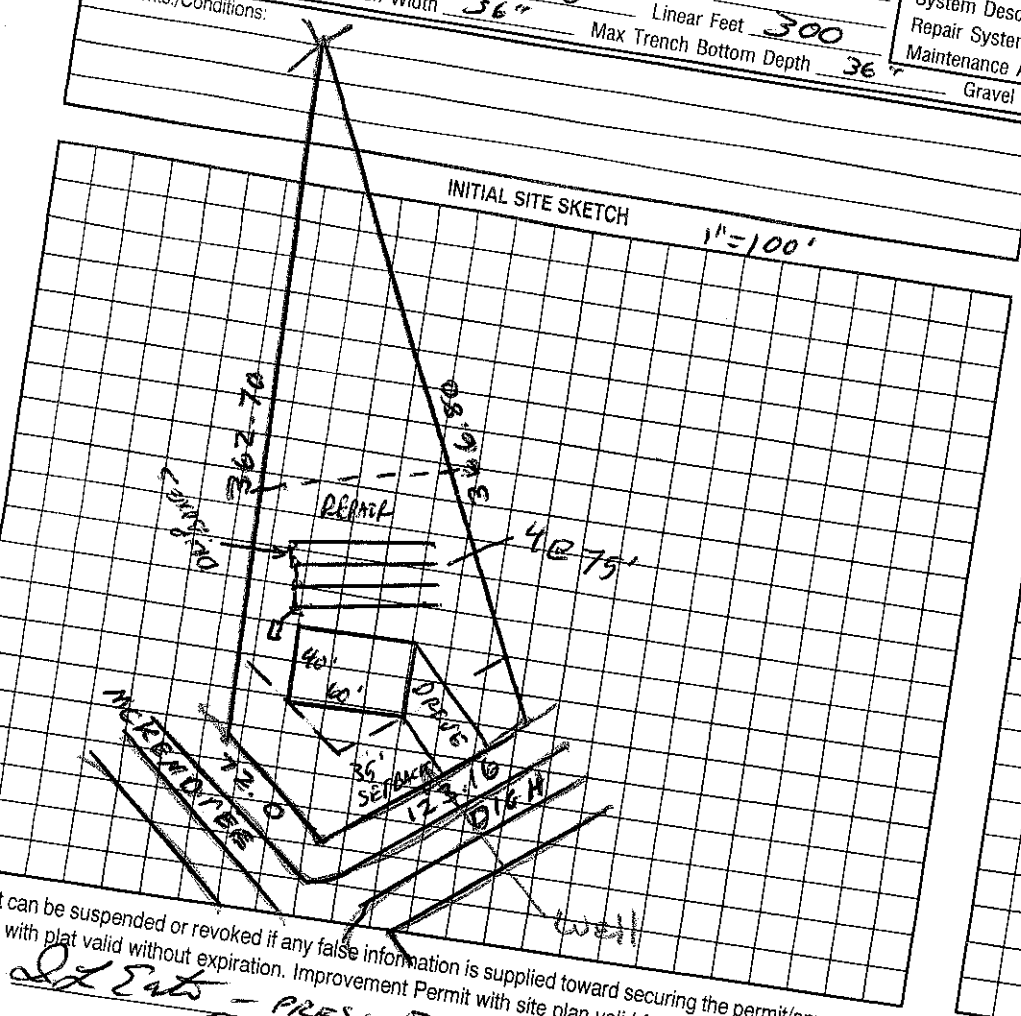

AS BUILT SKETCH

Installed as Drawn

...t can be suspended or revoked if any false information is supplied toward securing the permit/any unauthorized changes are made to the site/any unauthorized changes are made in the installation of the system. Improvement with plat valid without expiration. Improvement Permit with site plan valid for sixty months. Authorization to Construct is valid for a period equal to that of Improvement Permit – not to exceed sixty months.

...t Permit by: D.L. Eats – PRES. EDC date 12/21/99

Construct by: [signature] RS date 12/20/99

[signature] RS date 1/3/00

Installed by: Wayne Clontz

Operation Permit by: [signature] R.S. date 4/12/2000

Existing System Inspection by: _____

HEALTH DEPT. COPY: WHITE OWNER COPY (FINAL): YELLOW OWNER COPY (INITIAL): PINK