IREDELL COUNTY HEALTH DEPARTMENT

STATESVILLE 704-878-5305 MOORESVILLE 704-664-5281

IMPROVEMENT PERMIT / AUTHORIZATION TO CONSTRUCT / OPERATION PERMIT / EXISTING SYSTEM INSPECTION

PERMIT# 126304 PIN# 4626497702.000 DATE 1/3/05

OWNER OR CONTRACTOR EASTER DEVELOPMENT PHONE: Business 201-6465 Home

ADDRESS 222 HIDEAWAY LN MOORESVILLE

LOCATION BR 64 School - TR McKENDREE - TR DOGWOOD CIRCLE - TL BARNSDALE - 1ST ON R

SUBDIVISION BALDBERRY CREEK BLOCK / SECTION LOT 5 LOT AREA .75AC SITE CLASS IS DESIGN FLOW 360GPD L.T.A.R. .360/AC

Septic Tank: 1000 Gallons; STB 1067 Date 2/27/06
Pump Tank: 1000 Gallons; PT 274 Date 2/7/06
Pump Make: Little Giant Model 9EH Serial No.
Nitrification Field: No Fields 1 Square Feet 900 Linear Feet 300
No Lines 3@100' Trench Width 36" Max Trench Bottom Depth 36" Gravel Depth N/A

☐ New System ☐ Repair System Type: I, II, III, IV, V, VI
System Description: PUMP 2506 REQUIRED
Repair System Description: LA PANAC
Maintenance Agreement Required: ☐ Yes ☒ No

☑ House/Mod. Home No. Bedrooms 3
☐ Mobile Home No. Bathrooms 3
☐ Business No. Employees
☐ Other


☐ Slab ☐ Crawl Space ☑ Basement w/plumbing ☐ Basement wo/plumbing

Water Supply: ☑ Individual ☐ Public ☐ Community


Comments:/Conditions:

Comments:/Conditions:

INITIAL SITE SKETCH 1" = 50'

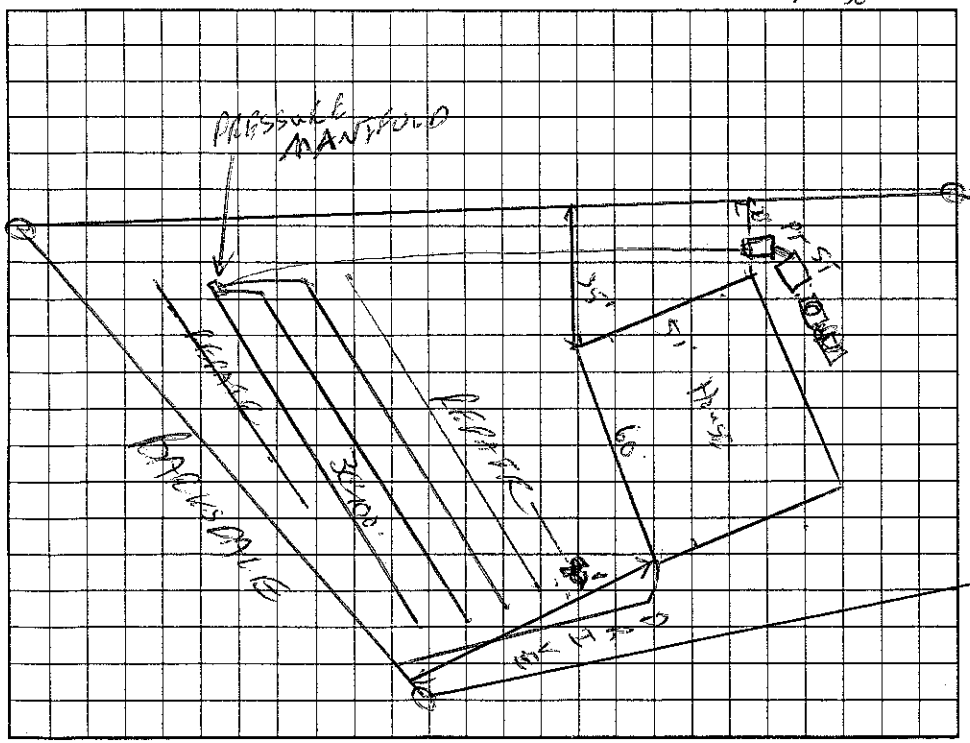

AS BUILT SKETCH

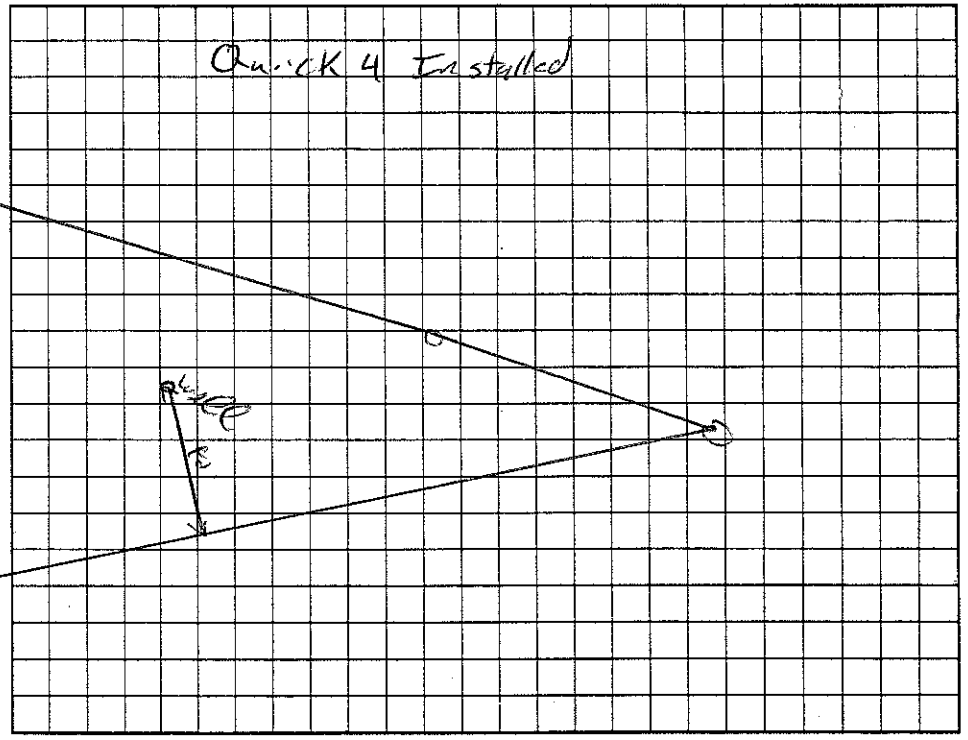

Permit can be suspended or revoked if any false information is supplied toward securing the permit/any unauthorized changes are made to the site/any unauthorized changes are made in the installation of the system. Improvement Permit with plat valid without expiration. Improvement Permit with site plan valid for sixty months. Authorization to Construct is valid for a period equal to that of Improvement Permit – not to exceed sixty months.

Signed: Stacy Whaley date 1/4/05 Installed by: Abernathy

Improvement Permit by: RS date 1/3/05 Operation Permit by: RS date 5/11/06

Authorization to Construct by: RS date 1/3/05 Existing System Inspection by: date

HEALTH DEPT. COPY: WHITE OWNER COPY (FINAL): YELLOW OWNER COPY (INITIAL): PINK