# IREDELL COUNTY HEALTH DEPARTMENT

STATESVILLE 704-878-5305 MOORESVILLE 704-664-5281

## IMPROVEMENT PERMIT / AUTHORIZATION TO CONSTRUCT / OPERATION PERMIT / EXISTING SYSTEM INSPECTION

PERMIT# 86511 PIN# 4626387480 PT Carpenter 4626493602 DATE 12/20/99

OWNER OR CONTRACTOR EASTER DEVELOPMENT CORP./Lewis PHONE: Business 664-2906 Home 201-6465

ADDRESS 227 Hideaway Lane, Mooresville NC 28117

LOCATION R. Brawley School, R. McKendree, R. High Circle - 5th ON LT

SUBDIVISION Blackberry Creek BLOCK / SECTION 1 LOT 6 LOT AREA .96 Acre SITE CLASS. PS DESIGN FLOW 360 L.T.A.R. .3 gpd/ft²

Septic Tank: 1000 Gallons; STB 794 Date 6/14/02
Pump Tank: 1000 Gallons; PT 27 Date 8/3/02
Pump Make: ZOELLER Model N152-A Serial No. 6/4/62
Nitrification Field: No Fields 1 Square Feet 900 Linear Feet 300
No Lines 3@100 Trench Width 36" Max Trench Bottom Depth 38" Gravel Depth N/A

☒ New System ☐ Repair System Type: I, II, (III), IV, V, VI
System Description: PUMP 25% REDUCTION
Repair System Description: PUMP PANEL
Maintenance Agreement Required: ☐ Yes ☒ No


☒ House/Mod. Home No. Bedrooms 3
☐ Mobile Home No. Bathrooms 2
☐ Business No. Employees
☐ Other
☐ Slab ☒ Crawl Space ☐ Basement w/plumbing ☐ Basement wo/plumbing

Water Supply: ☒ Individual ☐ Public ☐ Community

Comments/Conditions: APPROVED @ 4 @ 75'

Comments/Conditions: Infiltrator Installed.

INITIAL SITE SKETCH 1" = 100'

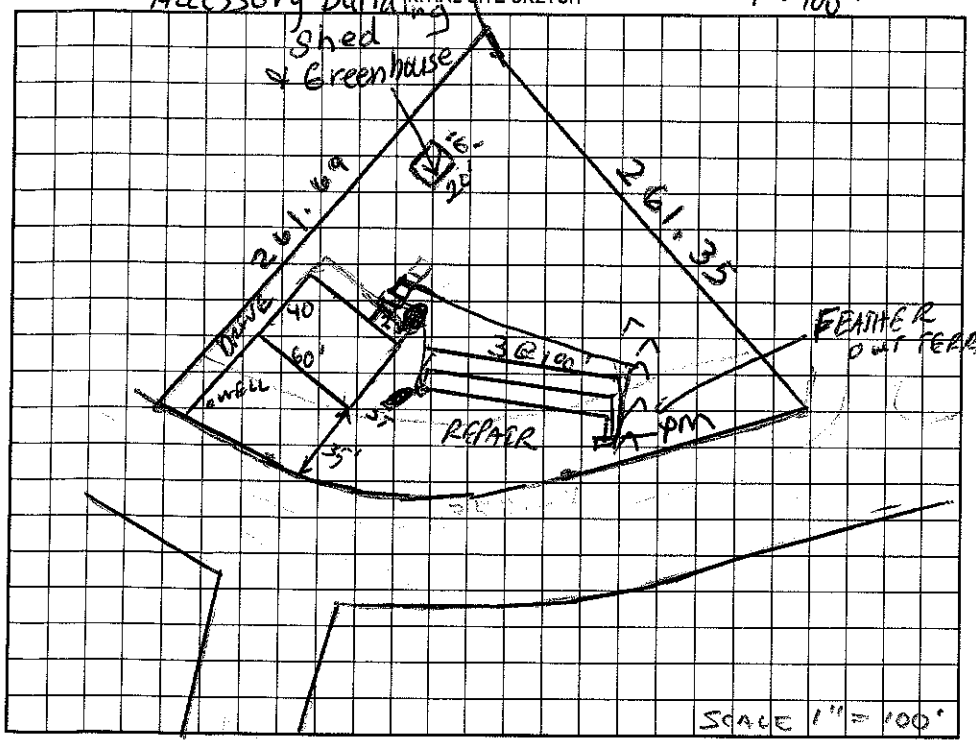


AS BUILT SKETCH

The proposed / existing Shed & Greenhouse addition does not appear to impact the existing septic system.

**NOTE:

Judy Melville REHS
Date: 6-10-11
ICHD-Environmental Health Division

Permit can be suspended or revoked if any false information is supplied toward securing the permit/any unauthorized changes are made to the site/any unauthorized changes are made in the installation of the system. Improvement Permit with plat valid without expiration. Improvement Permit with site plan valid for sixty months. Authorization to Construct is valid for a period equal to that of Improvement Permit – not to exceed sixty months.

Signed: [signature] - PRES. EDC date 12/21/99
Improvement Permit by: [signature] RS date 12/20/99
Authorization to Construct by: [signature] RS date 1/13/00

Installed by: Larry Beam
Operation Permit by: [signature] date 10/11/02
Existing System Inspection by: date

HEALTH DEPT. COPY: WHITE OWNER COPY (FINAL): YELLOW OWNER COPY (INITIAL): PINK