IREDELL COUNTY HEALTH DEPARTMENT

STATESVILLE 704-878-5305 MOORESVILLE 704-664-5281

IMPROVEMENT PERMIT / AUTHORIZATION TO CONSTRUCT / OPERATION PERMIT / EXISTING SYSTEM INSPECTION

PERMIT# 139644 PIN# 4626 58 1913.552 4626 49 5016 DATE March 12, 07

OWNER OR APPLICANT The Parkers LLC PHONE: Business Home

ADDRESS 160 Wagner St Troutman N.C. 28166

LOCATION Brawley Sch Rd. TR Mckendree TR Dogh TR Mordecai TR Silver Lake Trail on Right

SUBDIVISION The Farms BLOCK / SECTION 5 LOT 552 LOT AREA .98Ac SITE CLASS. PS DESIGN FLOW 460gpd L.T.A.R. .3

Septic Tank: 1500 X Gallons; STB 444 Date 11-1-11

Pump Tank: Gallons; PT Date

Pump Make: Model Serial No.

Nitrification Field: No Fields 1 Square Feet 1200 Linear Feet 400

No Lines 4 Trench Width 36" Max Trench Bottom Depth 36" Gravel Depth NA

☒ New System ☐ Repair ☐ Expansion System Type: I II III IV V VI

System Description: Gravity 25% Reduction accepted

Repair System Description: 25% Reduction

Maintenance Agreement Required: ☐ Yes ☒ No

☒ House/Mod. Home ☐ Mobile Home ☐ Business ☐ Other

No. Bedrooms 4 No. Persons No. Employees


Water Supply: ☐ Individual ☒ Public ☒ Community

☒ Gravity ☐ Pressure ☐ Slab ☒ Crawl Space ☐ Basement w/plumbing ☐ Basement wo/plumbing


Comments:/Conditions: X Per Plan specs
Levelers Required in D-box.

Comments:/Conditions:

INITIAL SITE SKETCH

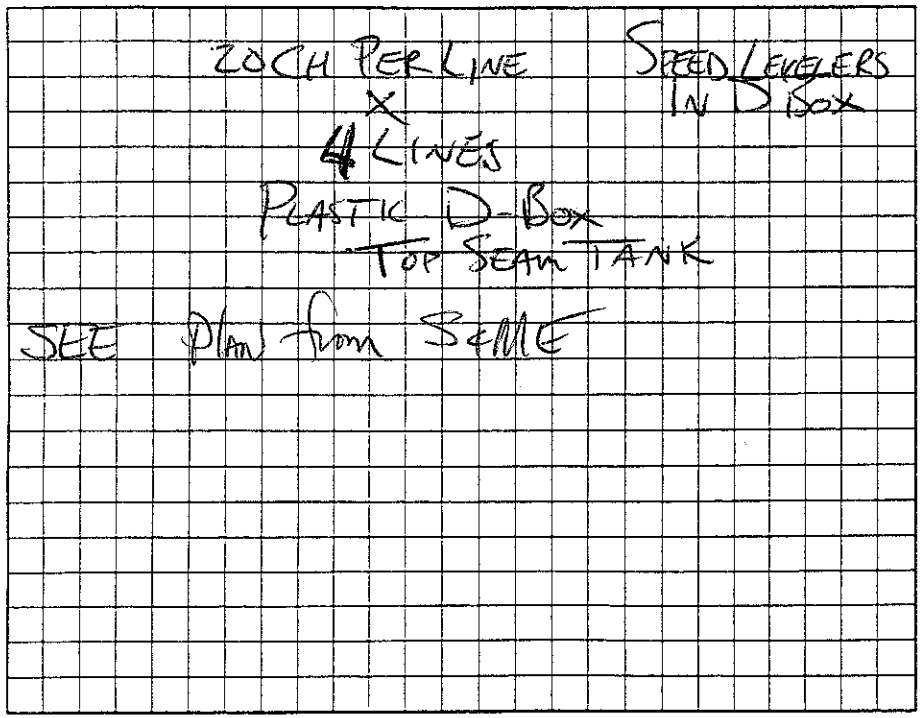

AS BUILT SKETCH

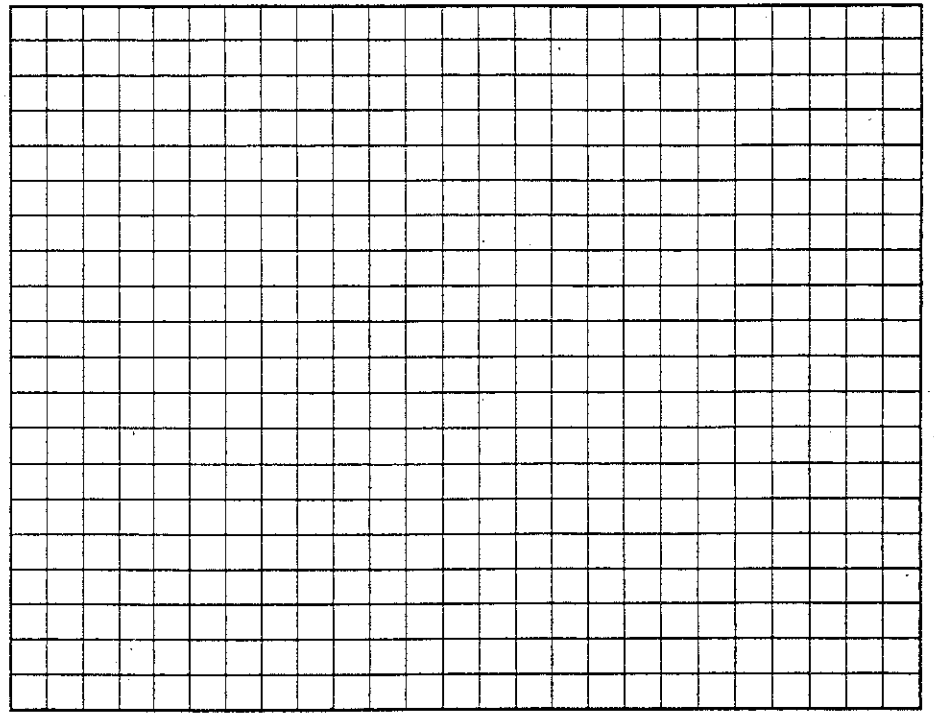

Permit can be suspended or revoked if any false information is supplied toward securing the permit/any unauthorized changes are made to the site/any unauthorized changes are made in the installation of the system. Improvement Permit with plat valid without expiration ☐ Improvement Permit with site plan valid for sixty months ☒ Authorization to Construct is valid for a period equal to that of Improvement Permit – not to exceed sixty months.

Signed: date 4-30-07

Improvement Permit by: date 3-12-07

Authorization to Construct by: REHS date 10-3-11

Installed by: ABERNATHY

Operation Permit by: REHS date 3-8-12

Existing System Inspection by: date

HEALTH DEPT. COPY: WHITE OWNER COPY (FINAL): YELLOW OWNER COPY (INITIAL): PINK