2100

IREDELL COUNTY HEALTH DEPARTMENT

STATESVILLE 704-878-5305 MOORESVILLE 704-664-5281

IMPROVEMENT PERMIT / AUTHORIZATION TO CONSTRUCT / OPERATION PERMIT / EXISTING SYSTEM INSPECTION

PERMIT# ~~19640~~ 204936 PIN# ~~4676-58-1413-.357~~ 49-5109 DATE March 12, 2007

OWNER OR APPLICANT The Farms LLC / Whitley Construction PHONE: Business _____ Home _____

ADDRESS 160 Wagner St Troutman N.C. 28166

LOCATION Brawley Sch Rd. TR McKendree TR Bigh TR Montclair TR Silver Trail on Right 114 Silver Lake Trail

SUBDIVISION The Farms BLOCK / SECTION 5 LOT 551 LOT AREA 0.75Ac SITE CLASS. B DESIGN FLOW 480gpd L.T.A.R. .3

Septic Tank: 1500 X Gallons: STB 444 Date 2-2-15
Pump Tank: 1500 X Gallons: PT 417 Date 2-4-15
Pump Make: Goulds 3/4HP Model VED 7124 Serial No CEL4C15
Nitrification Field: No Fields ___ Square Feet 540 Linear Feet 270
No Lines 2 CF Trench Width 24" Max Trench Bottom Depth 36" Gravel Depth Rock ☐ Gravity ☒ Pressure

☒ New System ☐ Repair ☐ Expansion System Type: I II III (IV) V VI
System Description: LPPPBPS
Repair System Description: LPPPBPS
Maintenance Agreement Required: ☒ Yes ☐ No

☒ House/Mod. Home ☐ Mobile Home ☐ Business ☐ Other
No. Bedrooms 4 No. Persons ___ No. Employees ___

Water Supply: ☐ Individual ☒ Public ☒ Community

☐ Slab ☒ Crawl Space ☐ Basement w/plumbing ☐ Basement wo/plumbing

Comments:/Conditions: * Per plan specs, Minimum 1000g required
House site will Require some filling

Comments:/Conditions:
1/29/14 Reviewed floor plans, in compliance with Septic plan
Drilled 3/16" hole, check valve installed

INITIAL SITE SKETCH

SEE PLAN from SHE

AS BUILT SKETCH

to 4 lines
4/9/15 Checked lines & valve box
5/6/15 Set 3# pressure, elect alarm

Permit can be suspended or revoked if any false information is supplied toward securing the permit/any unauthorized changes are made to the site/any unauthorized changes are made in the installation of the system. Improvement Permit with ~~plat valid without expiration~~ ☐ Improvement Permit with site plan valid for sixty months ☒ Authorization to Construct is valid for a period equal to that of Improvement Permit not to exceed sixty months.

Signed: _____ date 4-3-07

Improvement Permit by: _____ date 3-12-07


Authorization to Construct by: _____ RS date 7/29/14

Installed by: Hallman Construction

Operation Permit by: _____ RS date 5/6/15

Existing System Inspection by: _____ date _____

HEALTH DEPT. COPY: WHITE OWNER COPY (FINAL): YELLOW OWNER COPY (INITIAL): PINK

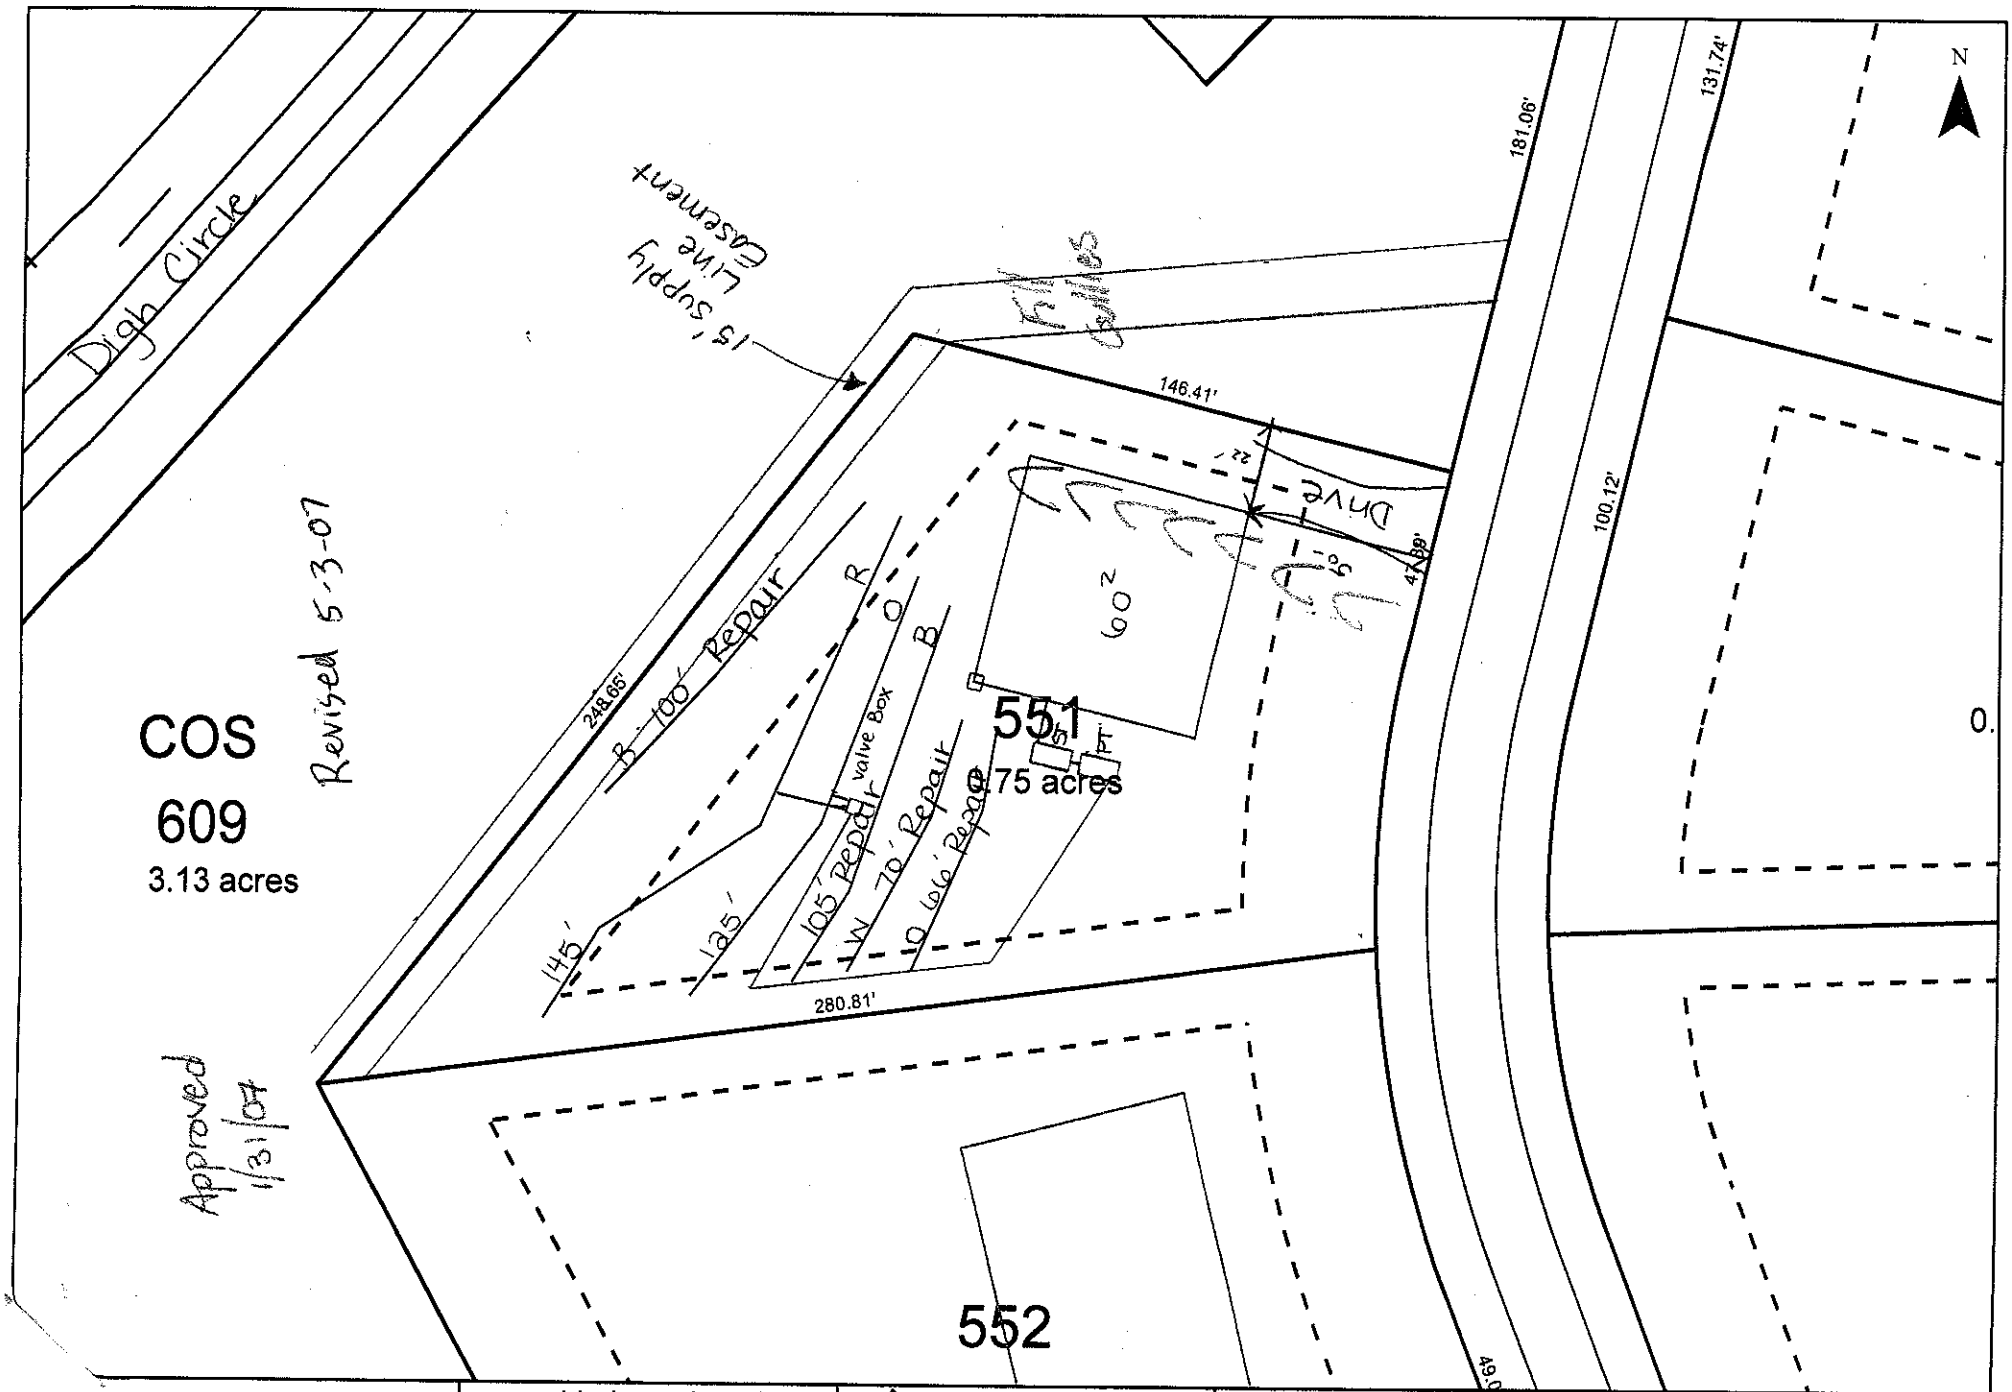

Scale: 1 inch equals 50 feet	S&ME	The Farms - Phase V	FIGURE
Drawn by: JBP	ENVIRONMENTAL SERVICES · ENGINEERING · TESTING	Lot 551	1
Reviewed by: KS		Iredell, North Carolina	
Date: December, 2006		Job No. 1588-05-070	